



The content of this drawing is subject to the provision of the Copyright Act 1956.

Work to figured dimensions only. Site dimensions are to be checked before work is started. Any discrepancy whatsoever between any information contained on this drawing and any other document or drawing must be drawn to the attention of the Architect by the contractor before the work is executed.

IF IN DOUBT ASK IMMEDIATELY.

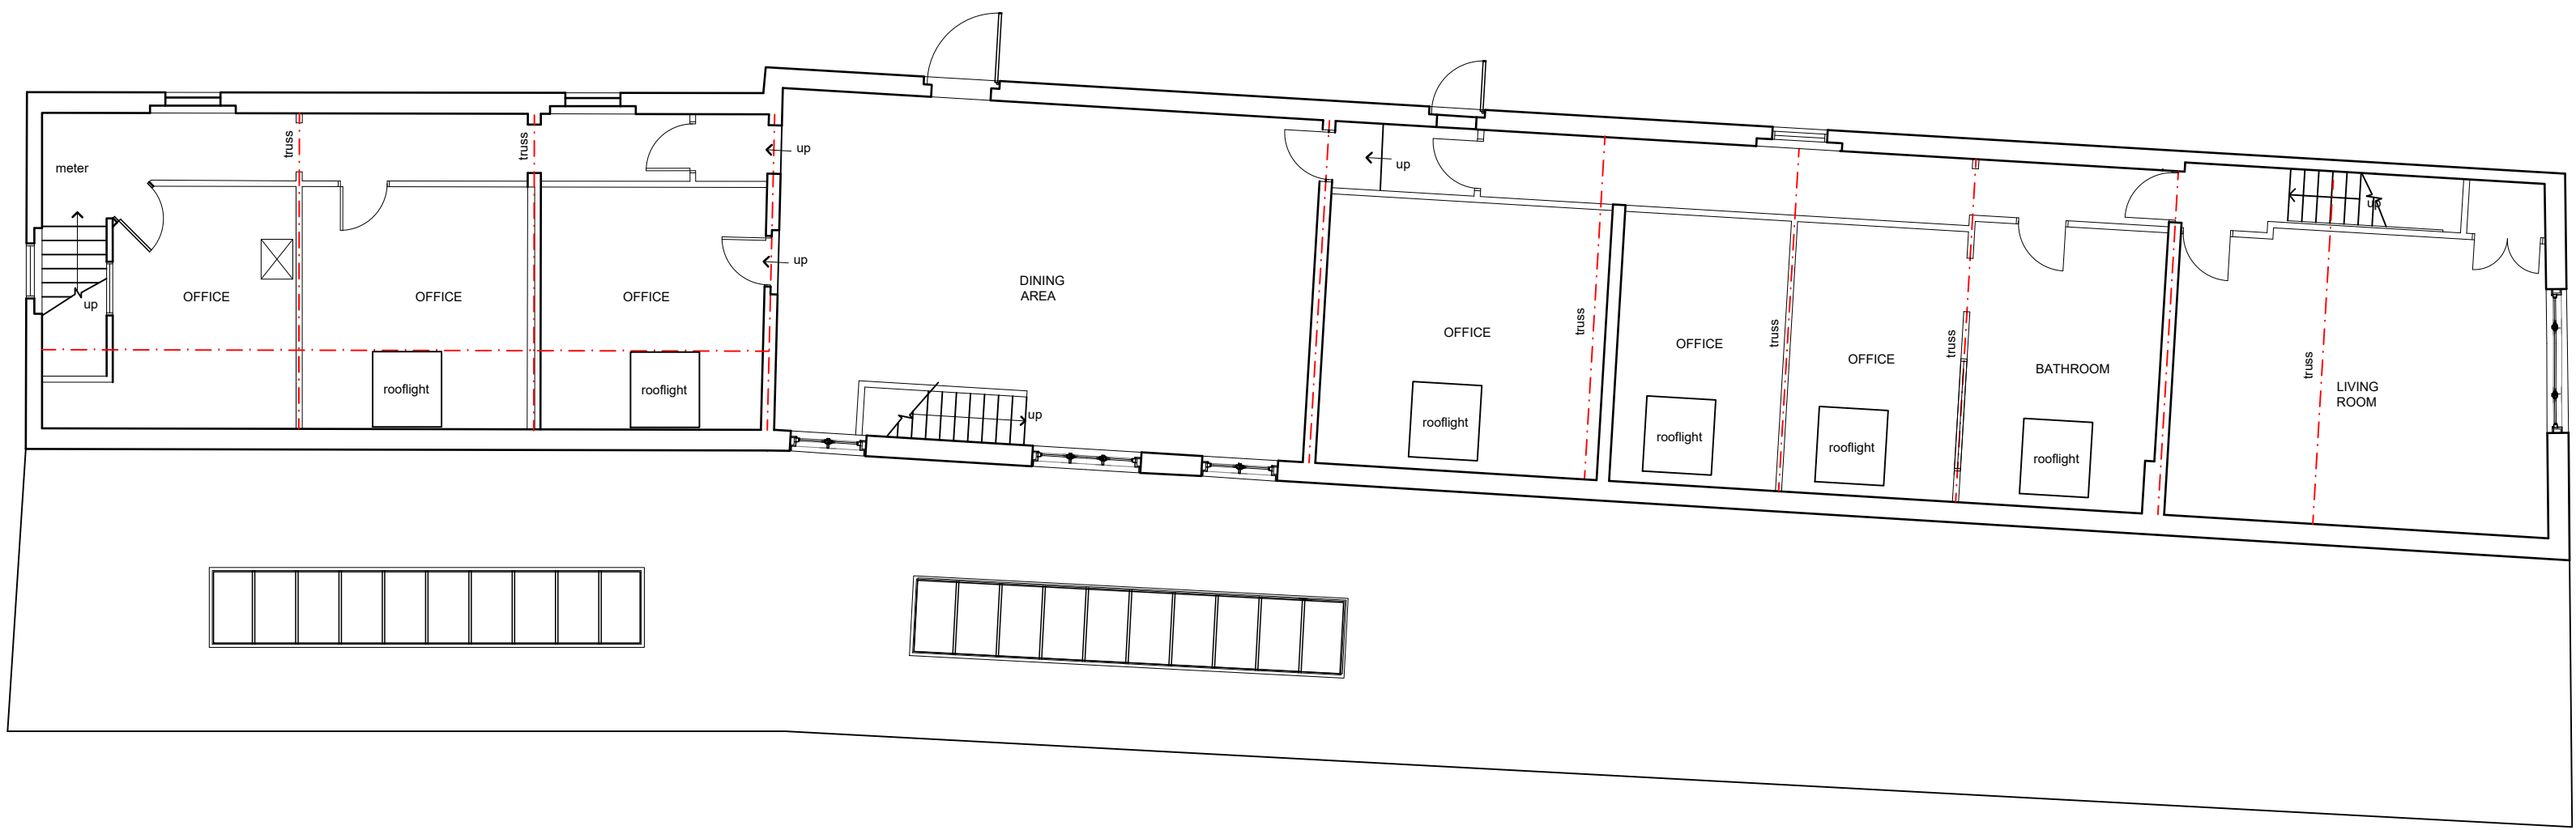

FIRST FLOOR PLAN

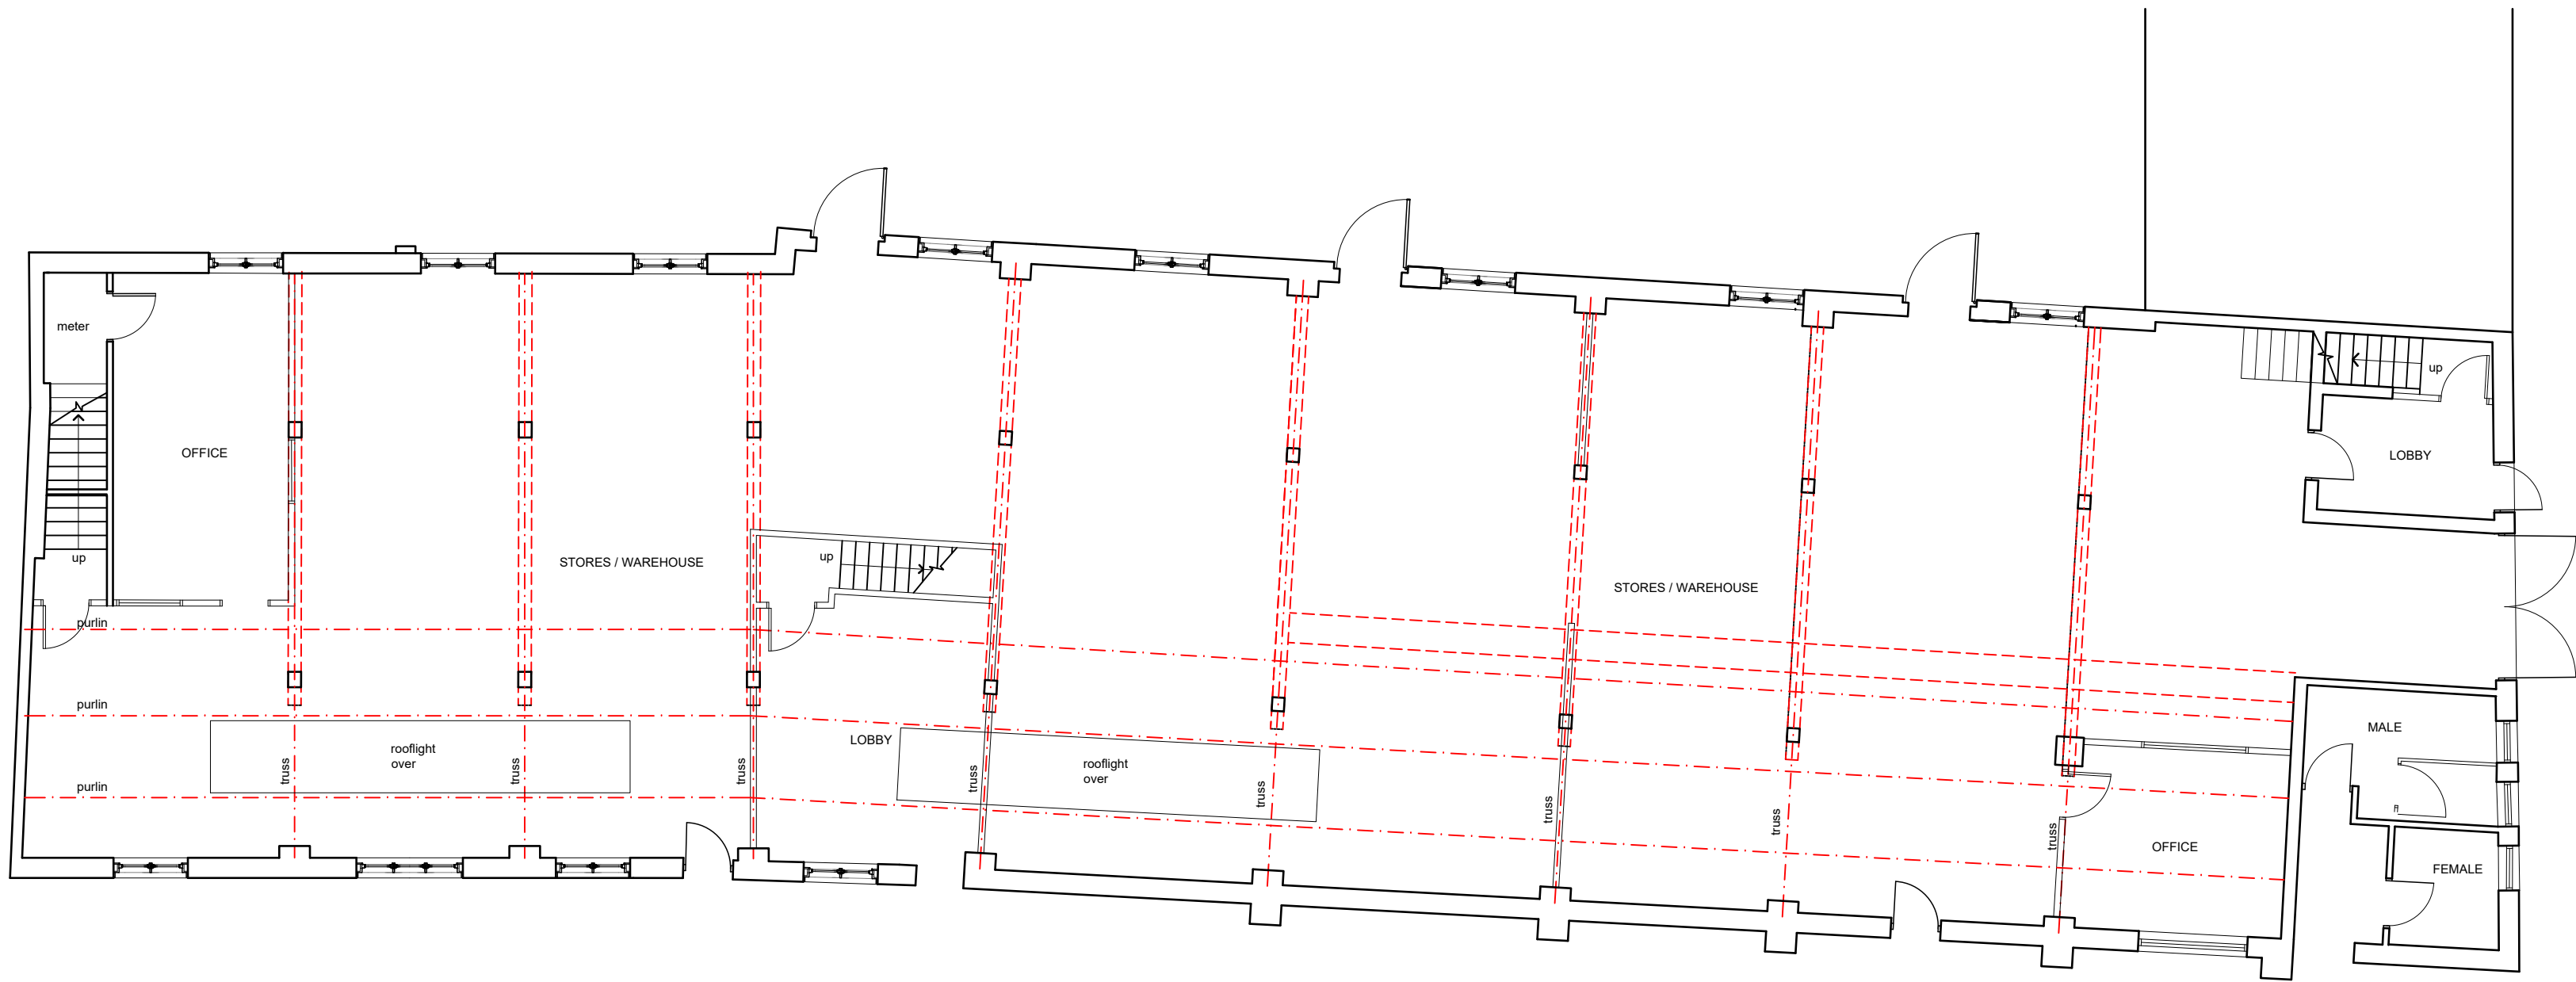

GROUND FLOOR PLAN

rev	date	description
-----	------	-------------

willacy horsewood partnership

client
ANDREW DICKENS

job
PROPOSED CONVERSION OF EXISTING OUTBUILDINGS ,
APPCHEM, HUGMORE LANE, WREXHAM LL13 9YE

title
RECORD DRAWINGS - FLOOR PLANS

scale	date	job no.	drawing no.	rev
1:100	SEP'15	WH1257	EX01	

76, hoole road, hoole, chester CH2 3NL
www.willacyhorsewood.co.uk
Tel: 01244 853891 07973 322953 E-Mail: mark@willacyhorsewood.co.uk