


FIRST FLOOR PLAN

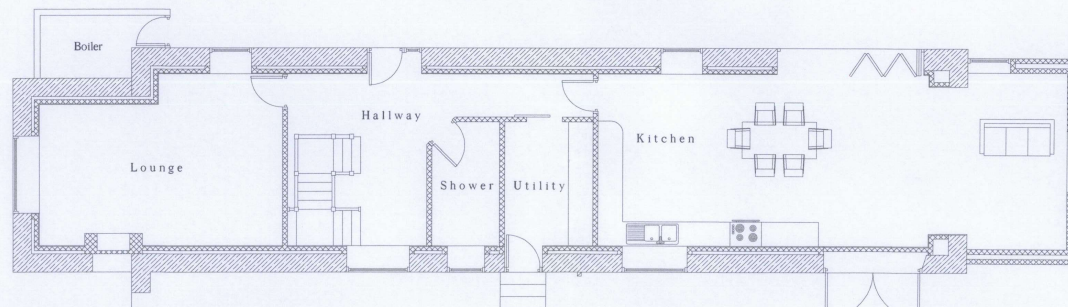

GROUND FLOOR PLAN

Existing House

AS BUILT

