


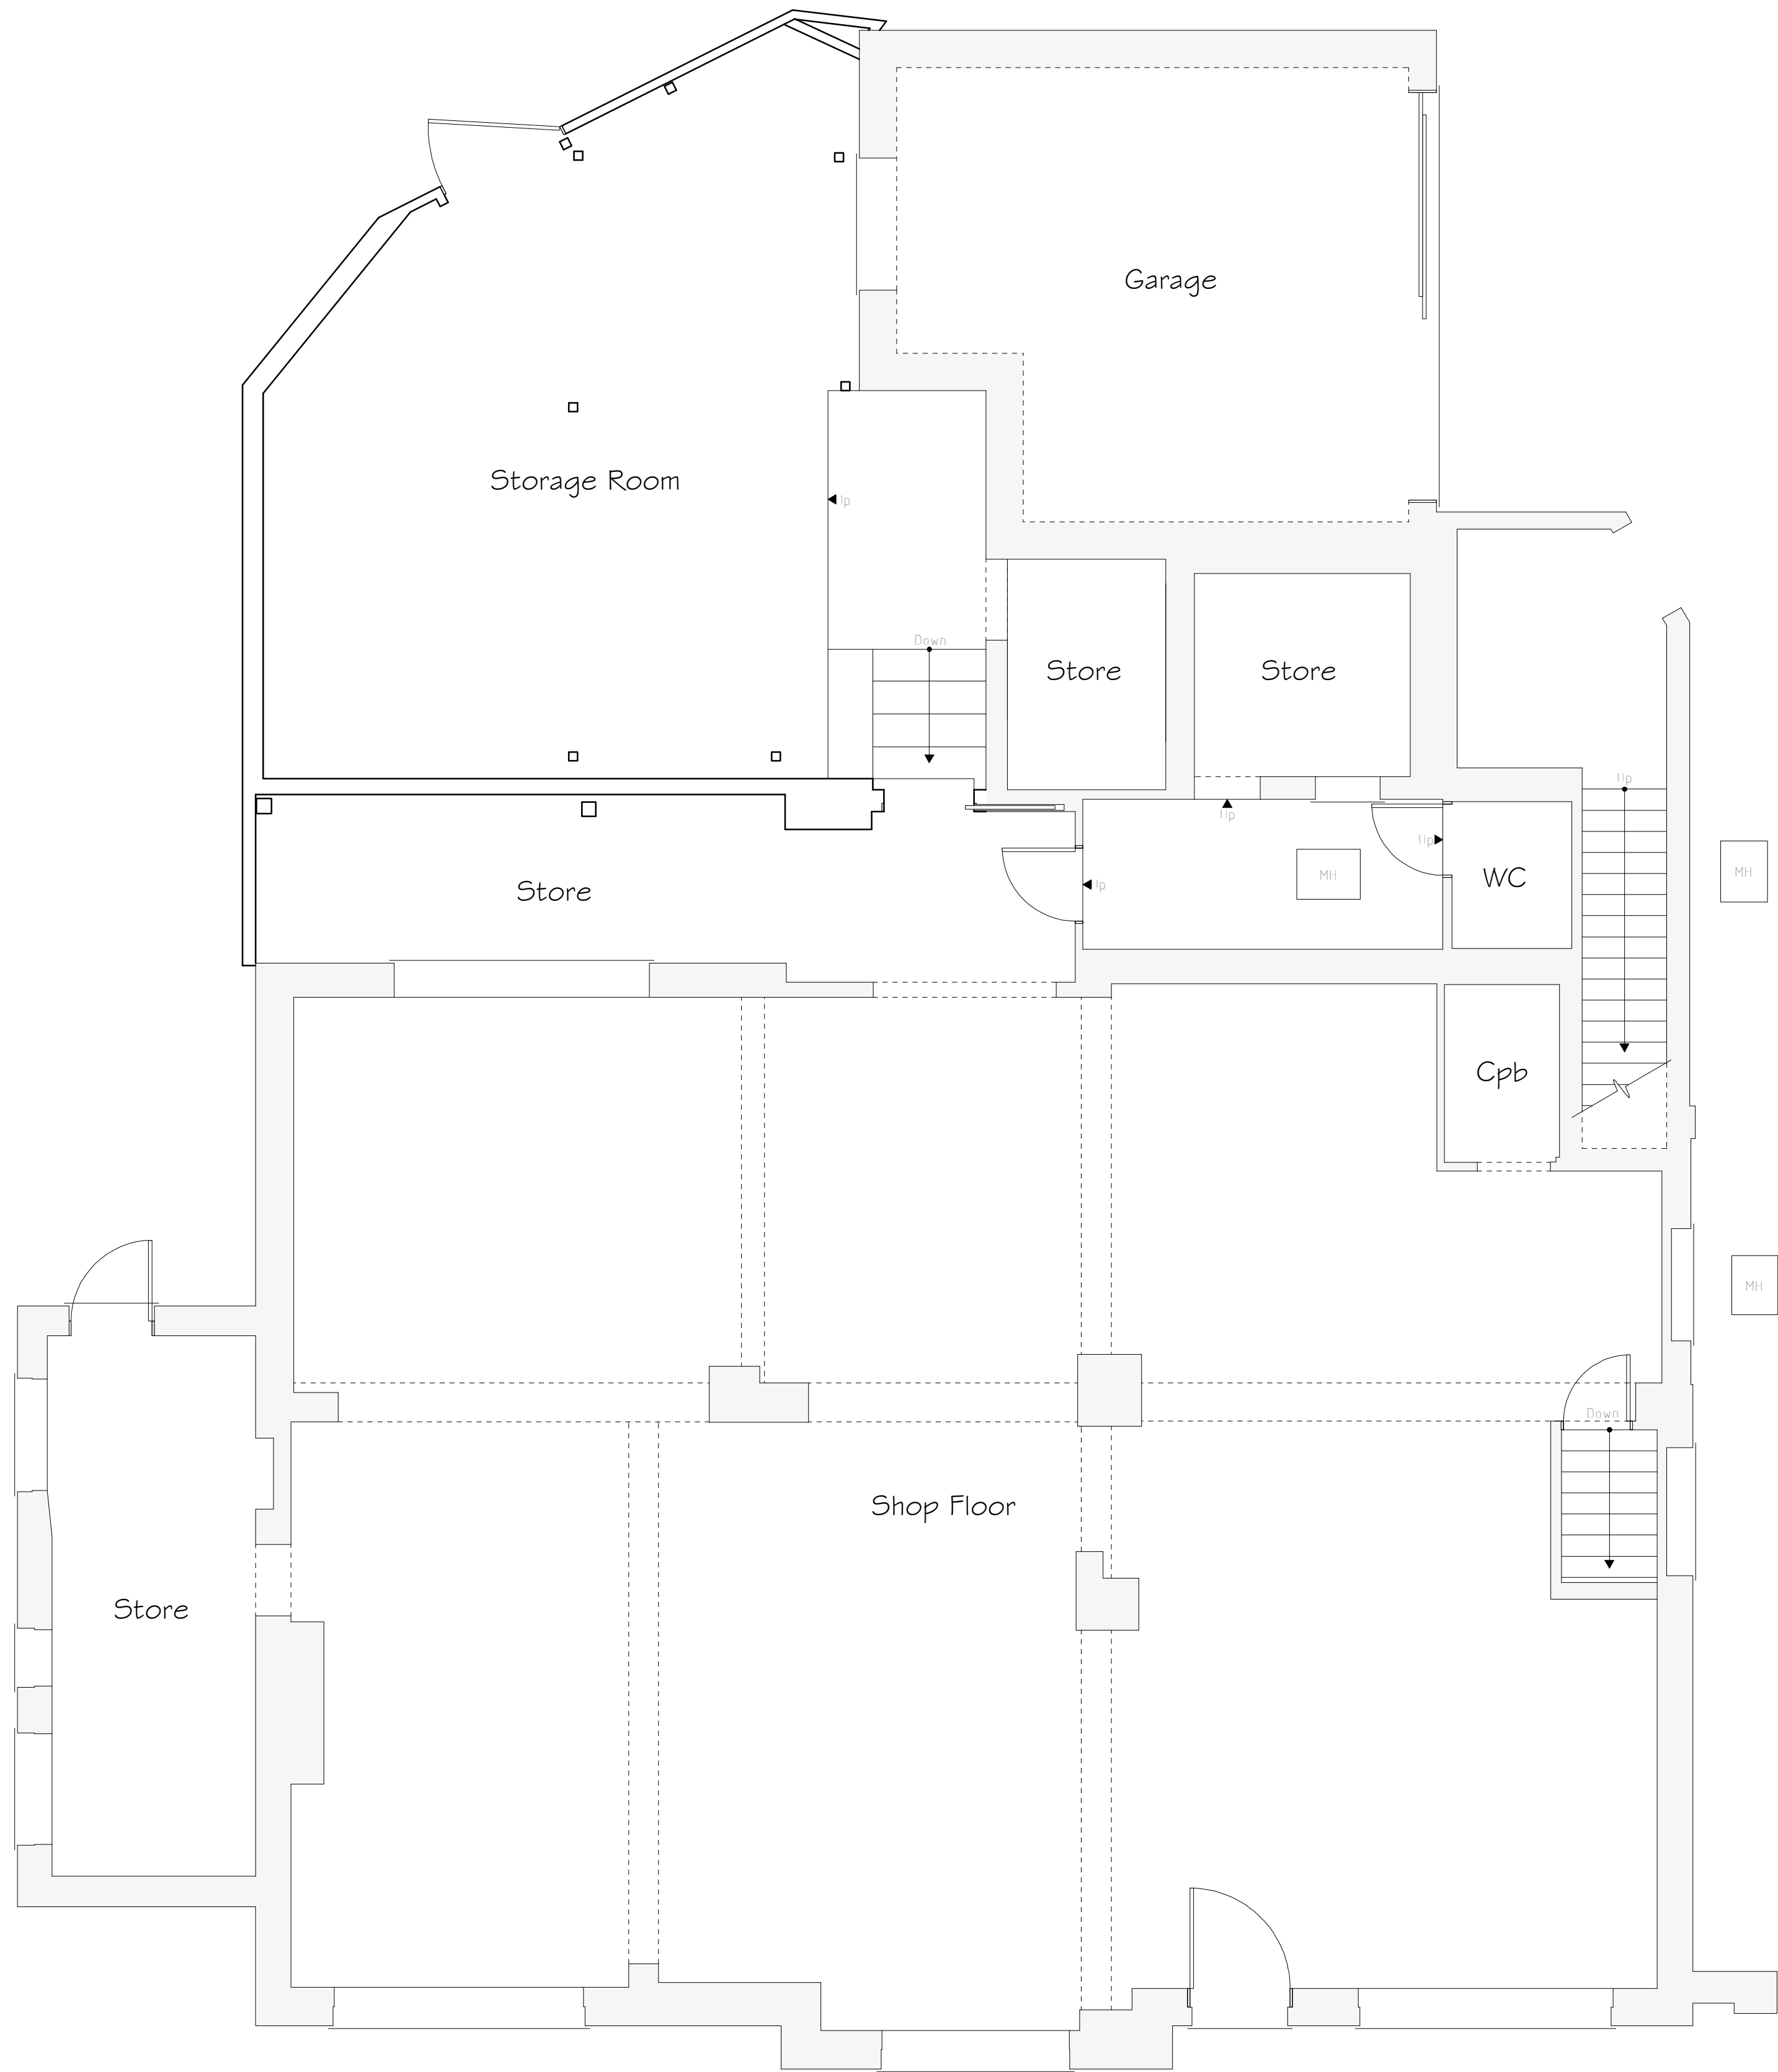

Ground Floor Plan 1:50



Front Elevation 1:100



Side Elevation 1:100



Rear Elevation 1:100



Side Elevation 1:100

Services Key			
MH	Existing Man Hole Position		

Rev	Date	Detail	Initial

Project: Proposed Alterations to, Travellers Rest, Kings Mill Road, Wrexham, LL13 8NH	
Title: As Built Plan	Scale: (A1) 1:50 & 1:100

Drawn By: A.Valentine	Date: April 2023
Drawing No: B169/002	Sheet: 1 of 1



Office 3K4,
Redwither Business Tower,
Wrexham. LL13 9XT
Tel: 01978 356500
www.blueprintarchitectural.com
© copyright all rights reserved