






Front Elevation

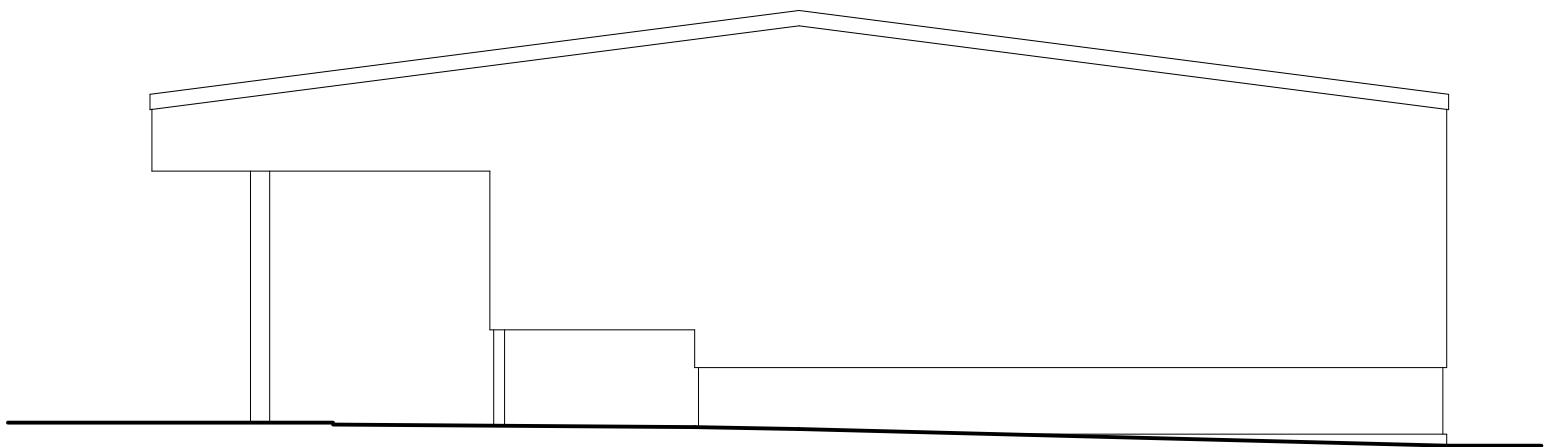


Side Elevation

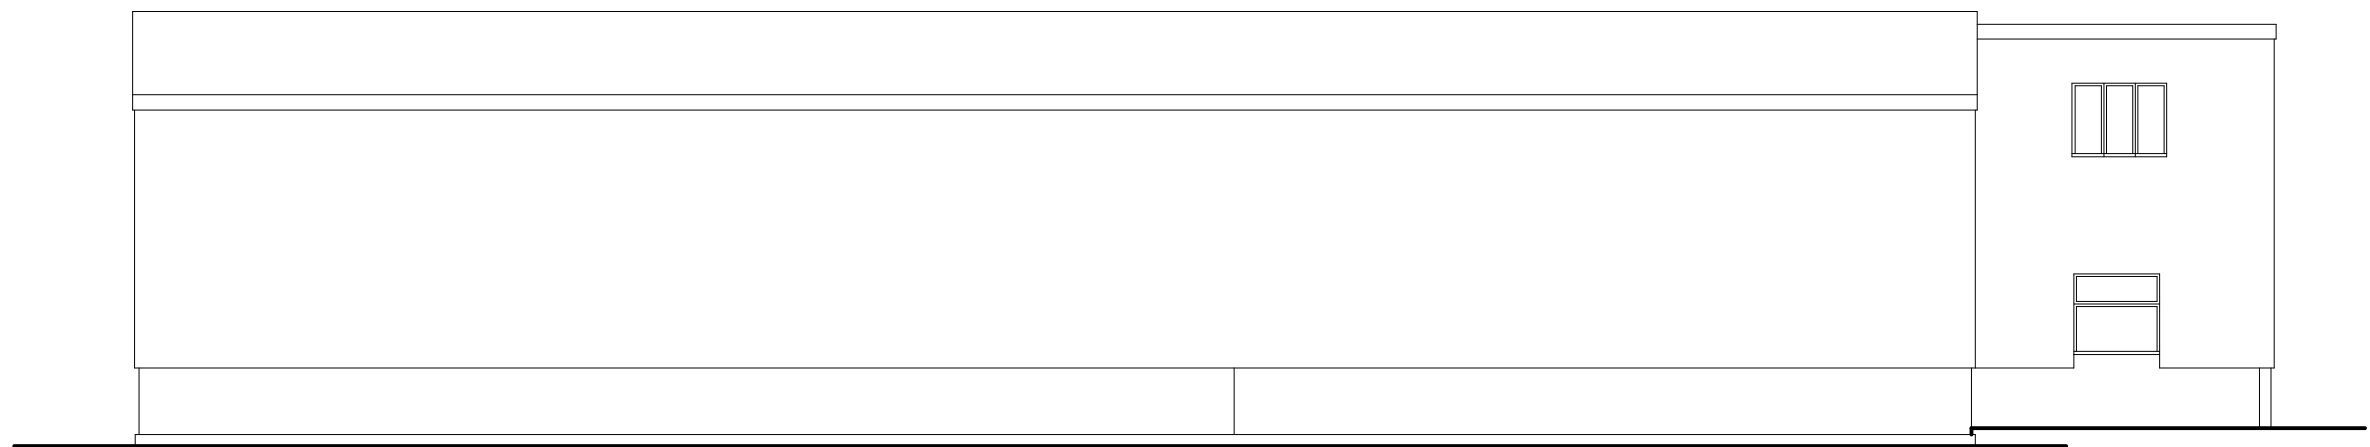


Rear Elevation

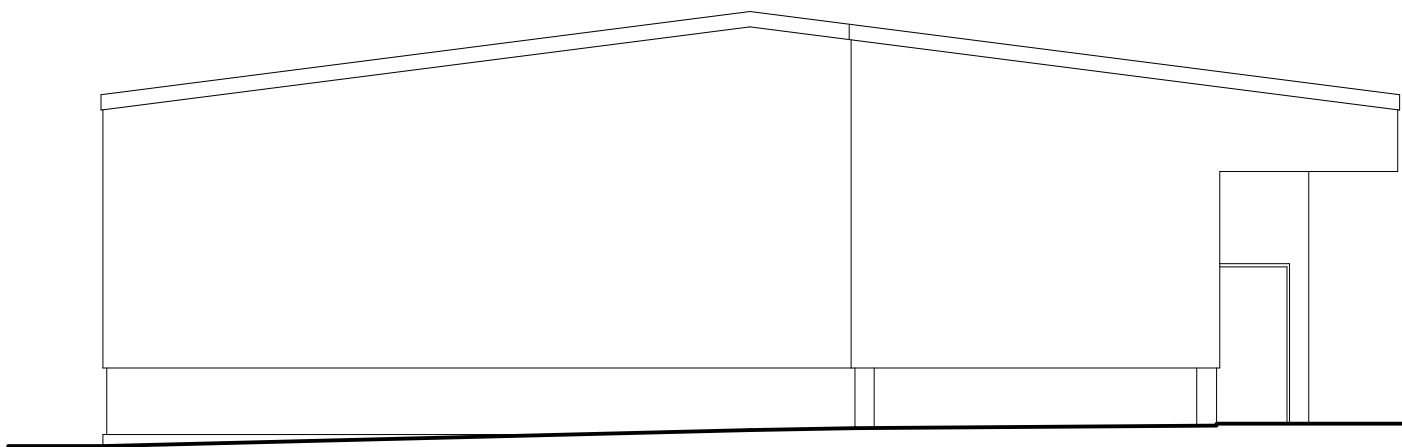

Side Elevation

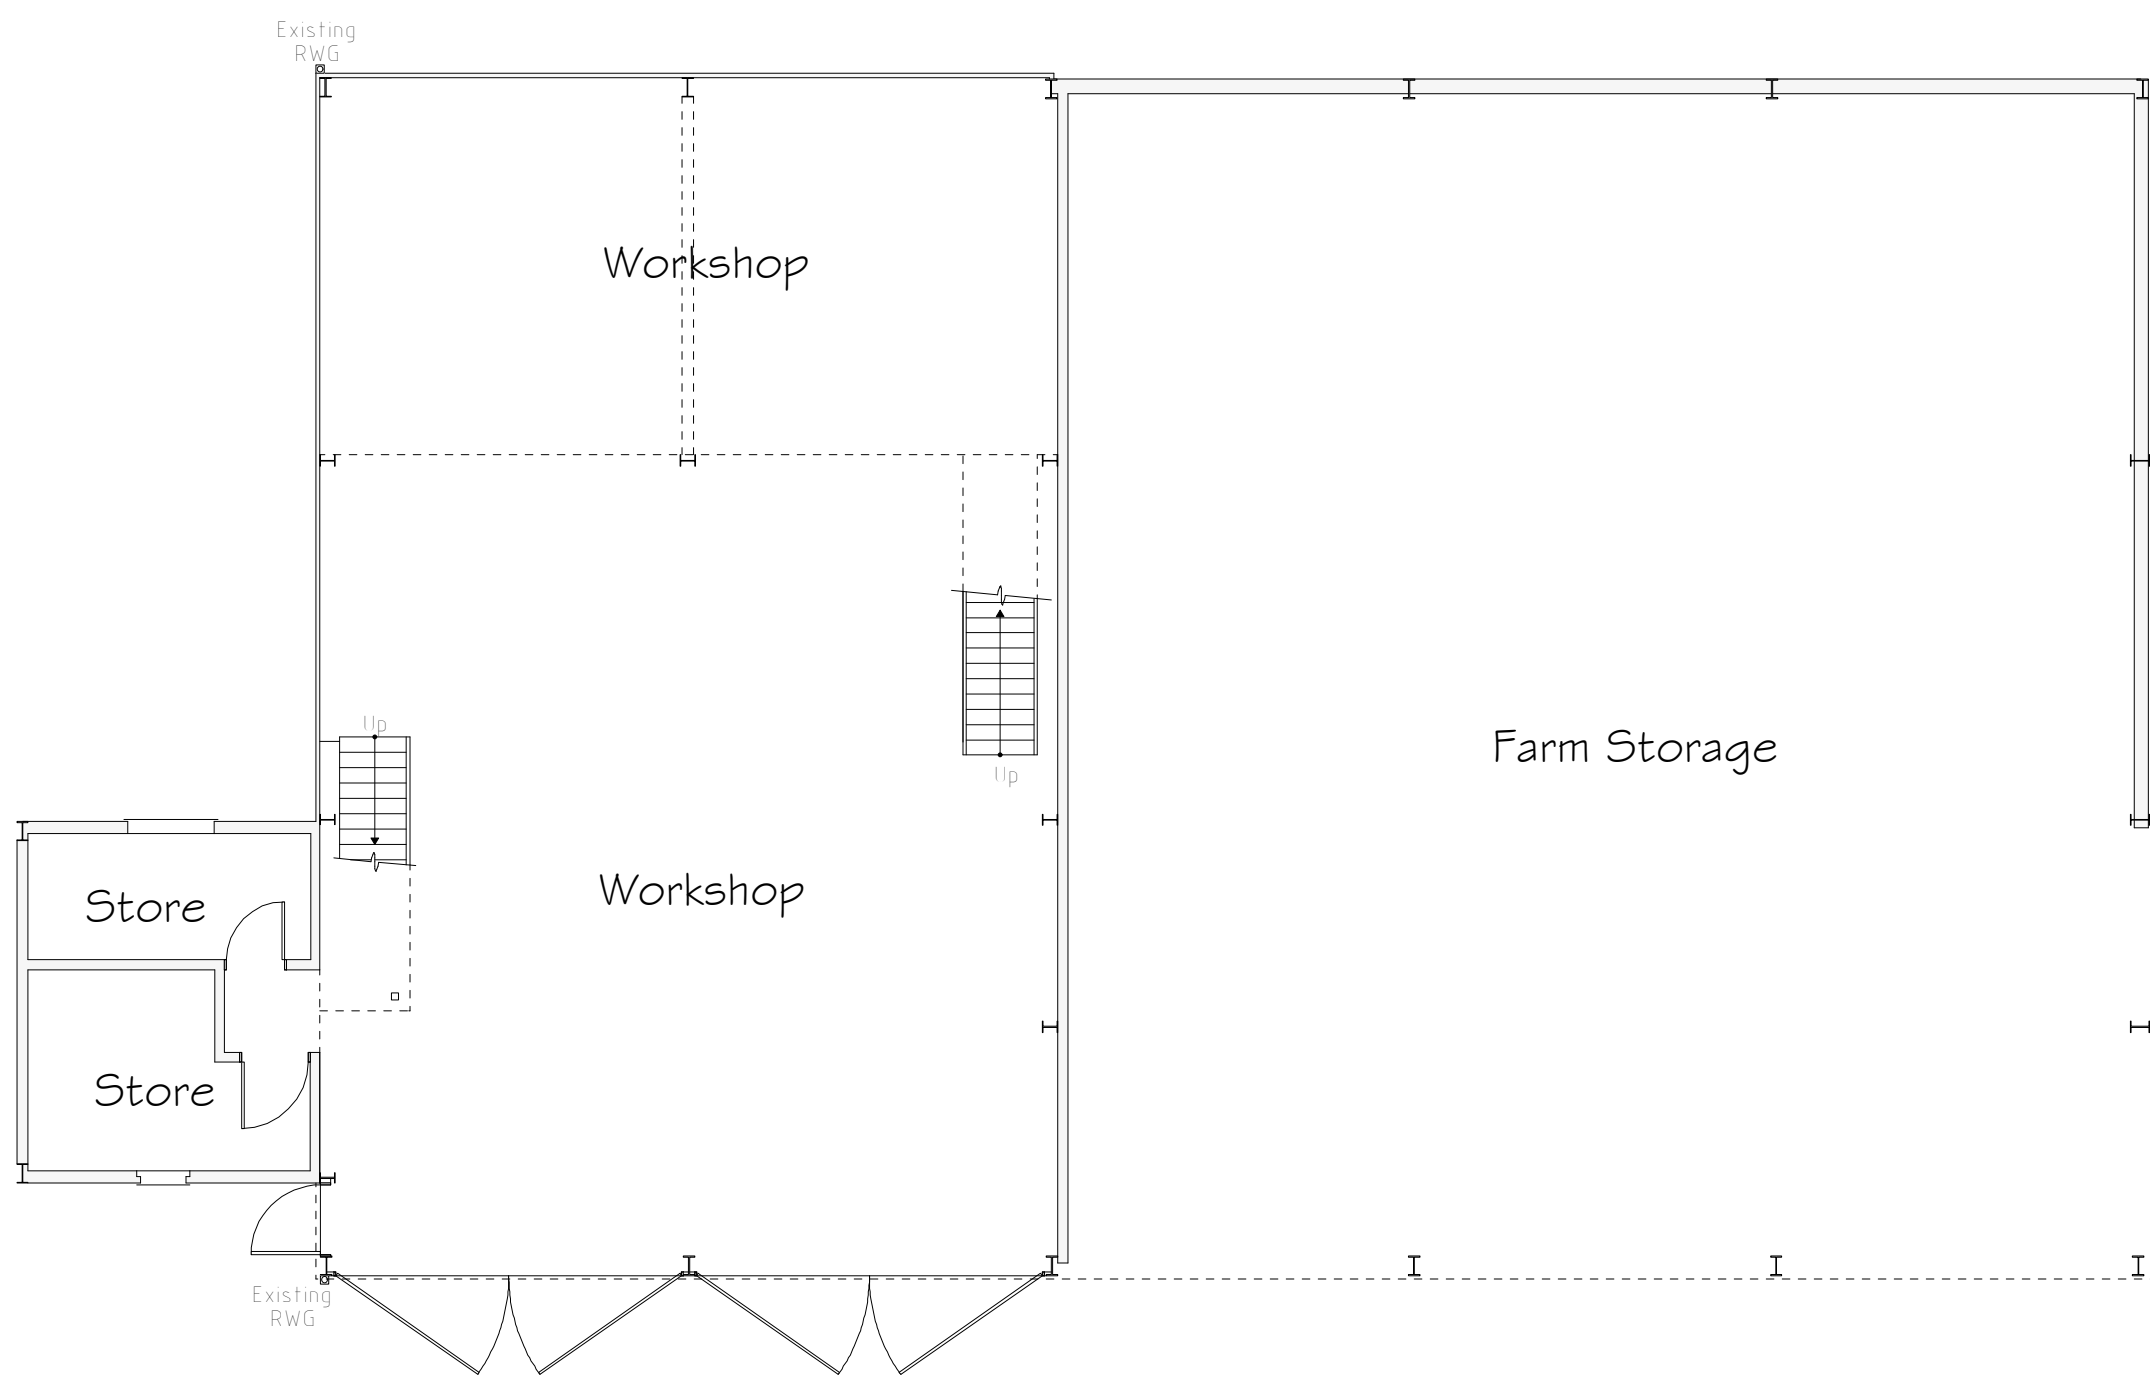

Ground Floor Plan

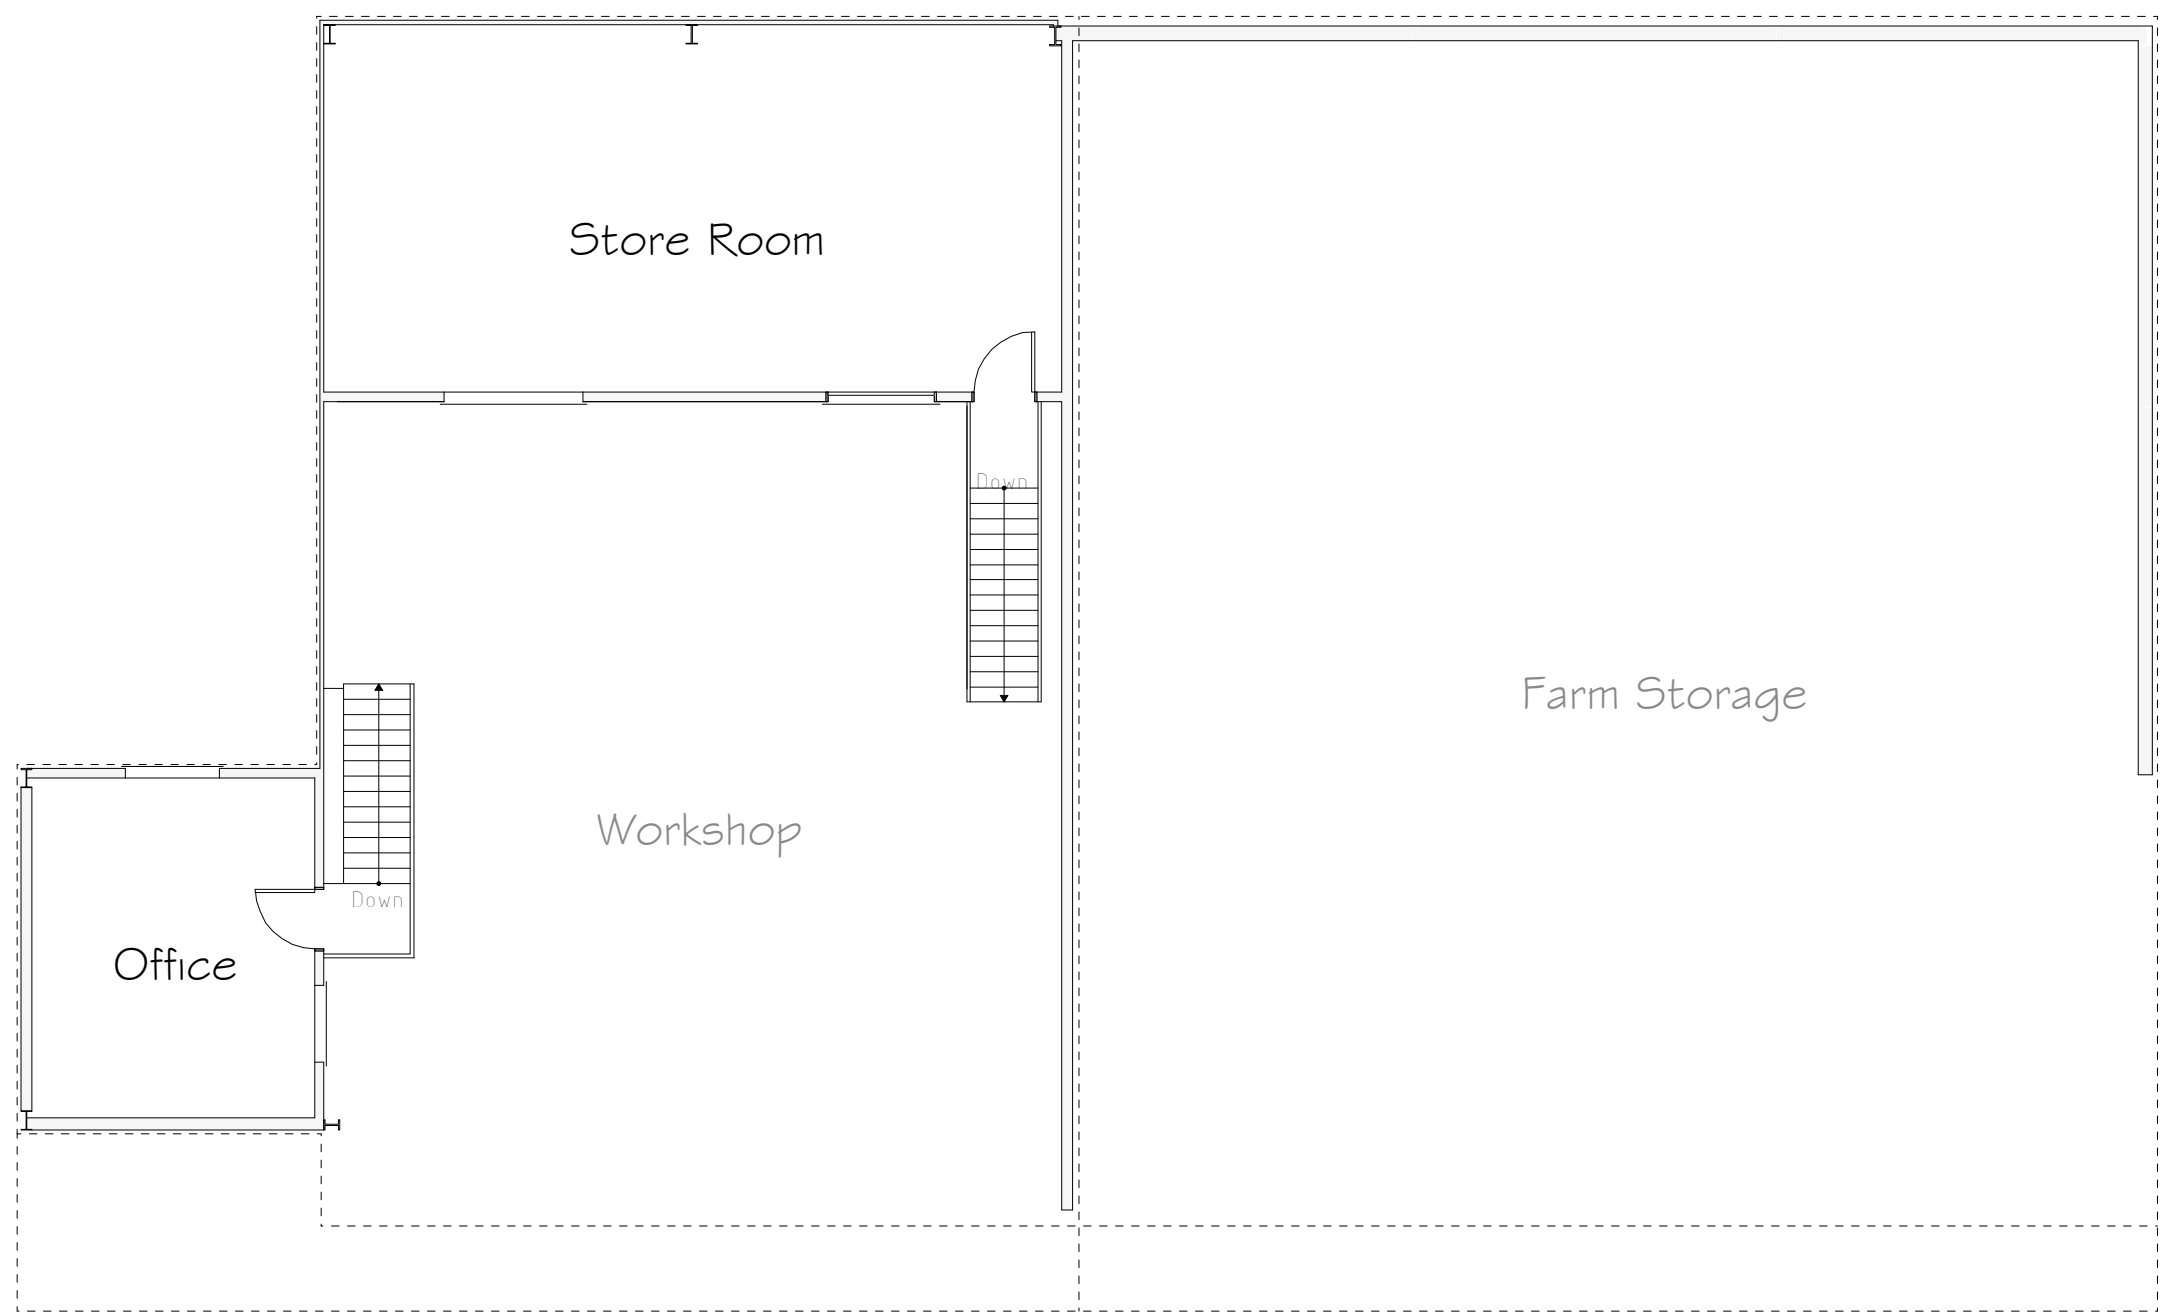

First Floor Plan

External Facing Materials
External walls comprise steel sheet cladding and blockwork.

Roofing Materials
Roof coverings comprise corrugated roof sheets.

Windows comprise sealed double glazed units set in uPVC frames.

Rainwater collected in uPVC guttering and uPVC downpipes, to discharge to soakaways.

Services Key			
MH	Existing Man Hole Position		
☒	Existing Rain Water Gully (RWG) Position		
O	Existing Soil Vent Pipe (SVP) Position		

Rev	Date	Detail	Initial

Project: As Built drawings at, Whalebone Cottage, Plassey Cottage, Willington, Malpas, SY14 7LS	
Title: As Built	Scale: (A1) 1 : 100
Drawn By: E.M.Jackson	Date: July 2023
Drawing No: C150/001	Sheet: 1 of 1