




Front Elevation 1:100

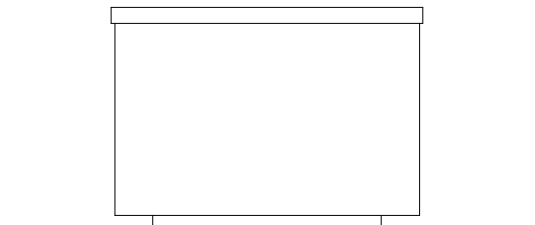



Side Elevation 1:100

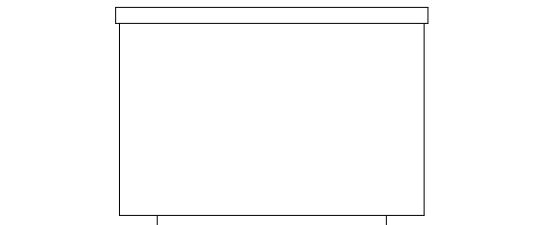


Side Elevation 1:100

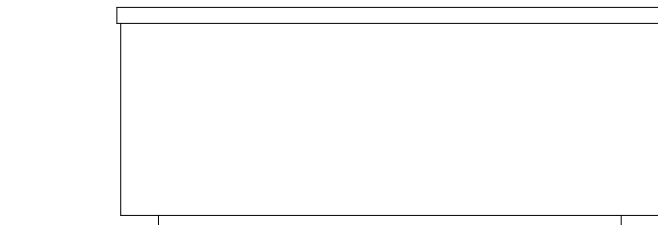

Rear Elevation 1:100

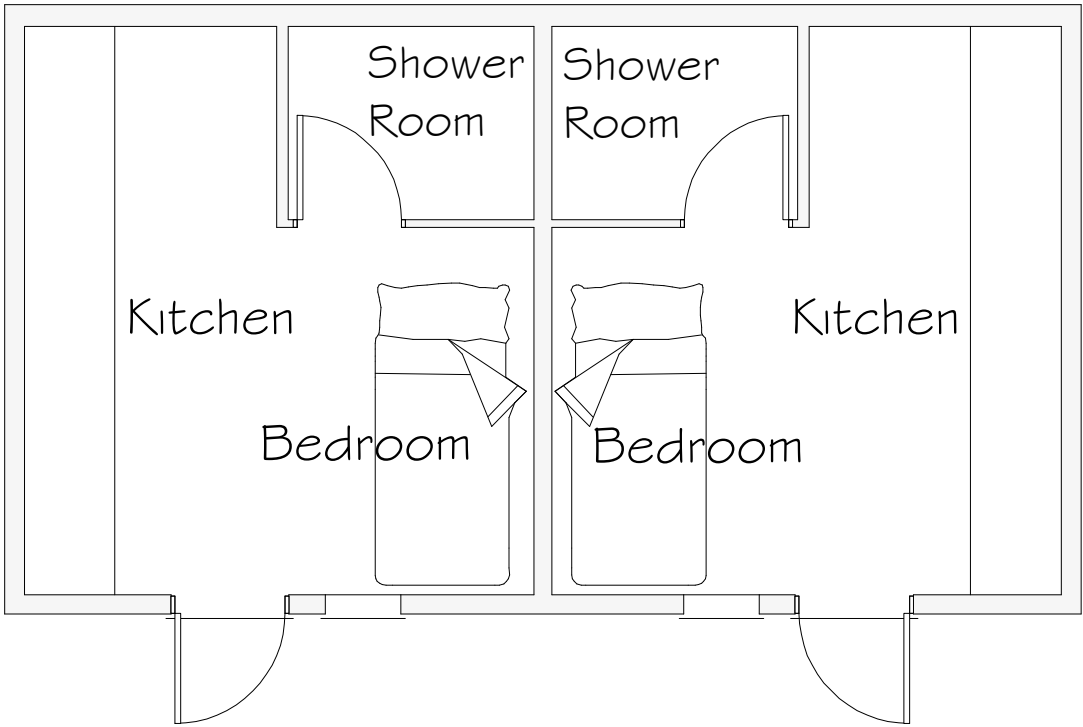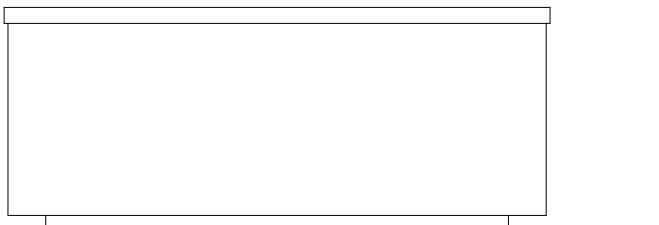

Ground Floor Plan 1:50

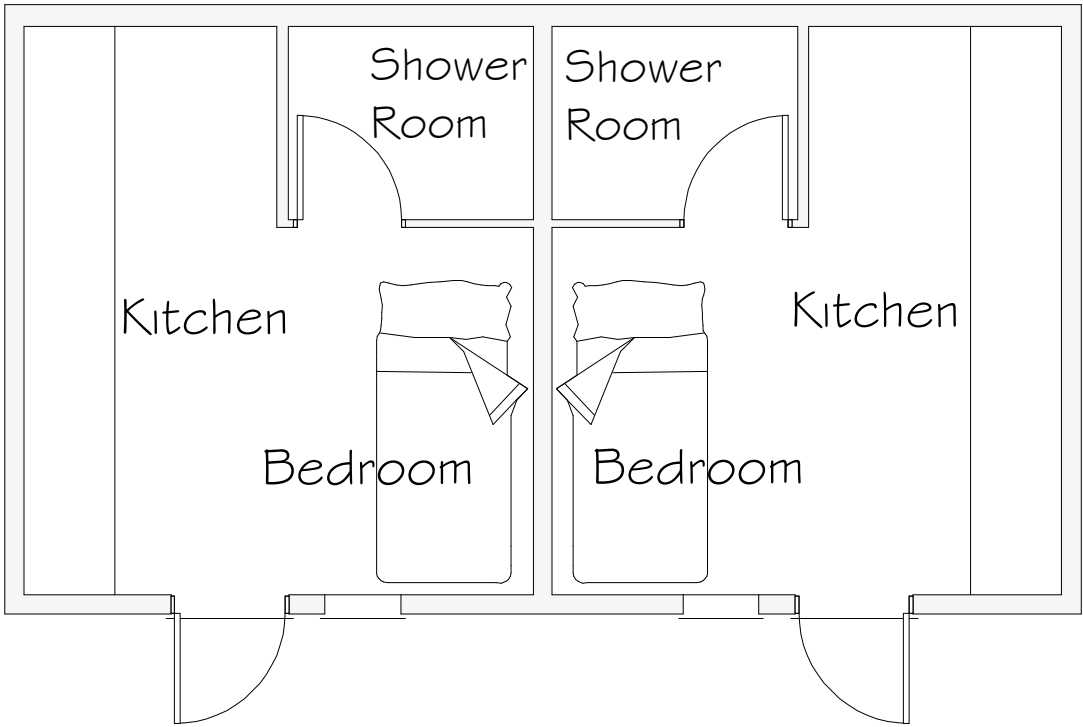

Rev	Date	Detail	Initial

Project: Maelor Abattoir Bedwell Road Wrexham LL13 0TS	
Title: As Built Pod	Scale: (A2) 1:50 & 1:100

Drawn By: L.Fowles	Date: Oct 2023
Drawing No: F053/001	Sheet: 1 of 1





Office 3K4,
Redwither Business Tower,
Wrexham. LL13 9XT
Tel: 01978 356500
www.blueprintarchitectural.com
© copyright all rights reserved