
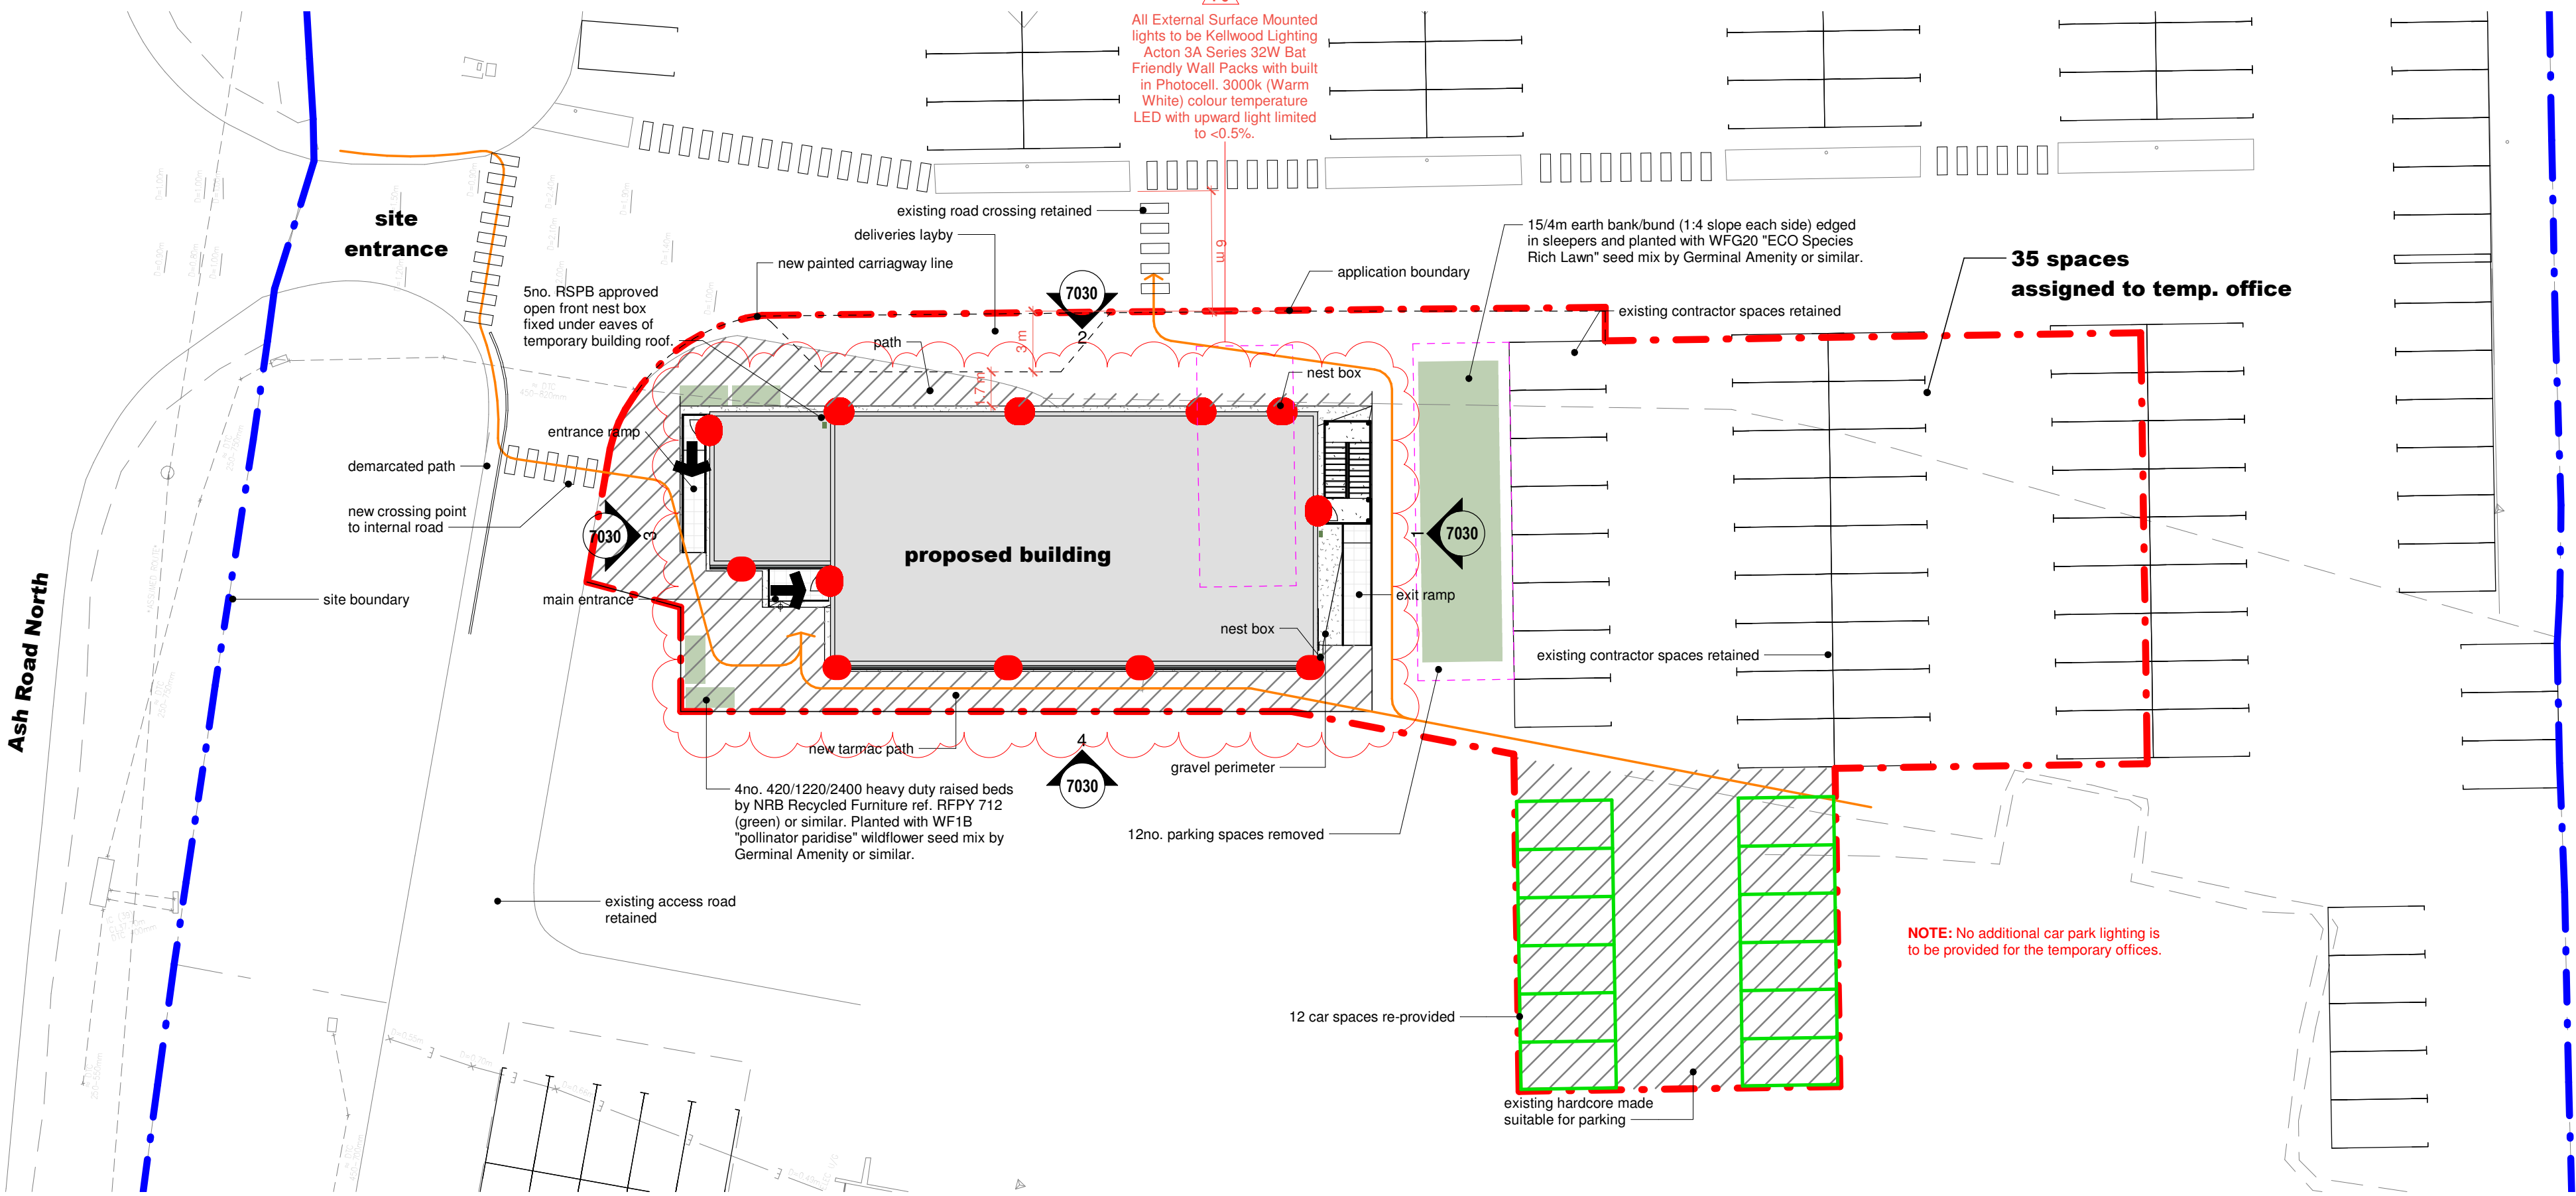


Notes

Figured dimensions are to be used in all case.
Dimensions should not be scaled from drawing
All existing dimensions should be checked on site before commencement of the work.
Any discrepancies in dimensions should be clarified with the Architect prior to commencement of the work.
No deviation from this drawing will be permitted without the prior written consent of the Architect.
This drawing is to be read in conjunction with all the relevant Mechanical and Electrical drawings.
This drawing is to be read in conjunction with the relevant Structural Engineer's drawings, structural calculations and recommendations.
This drawing is to be read in conjunction with the relevant Fire Safety Strategy drawings

This drawing is copyright and to be returned to the architect on completion of the contract.

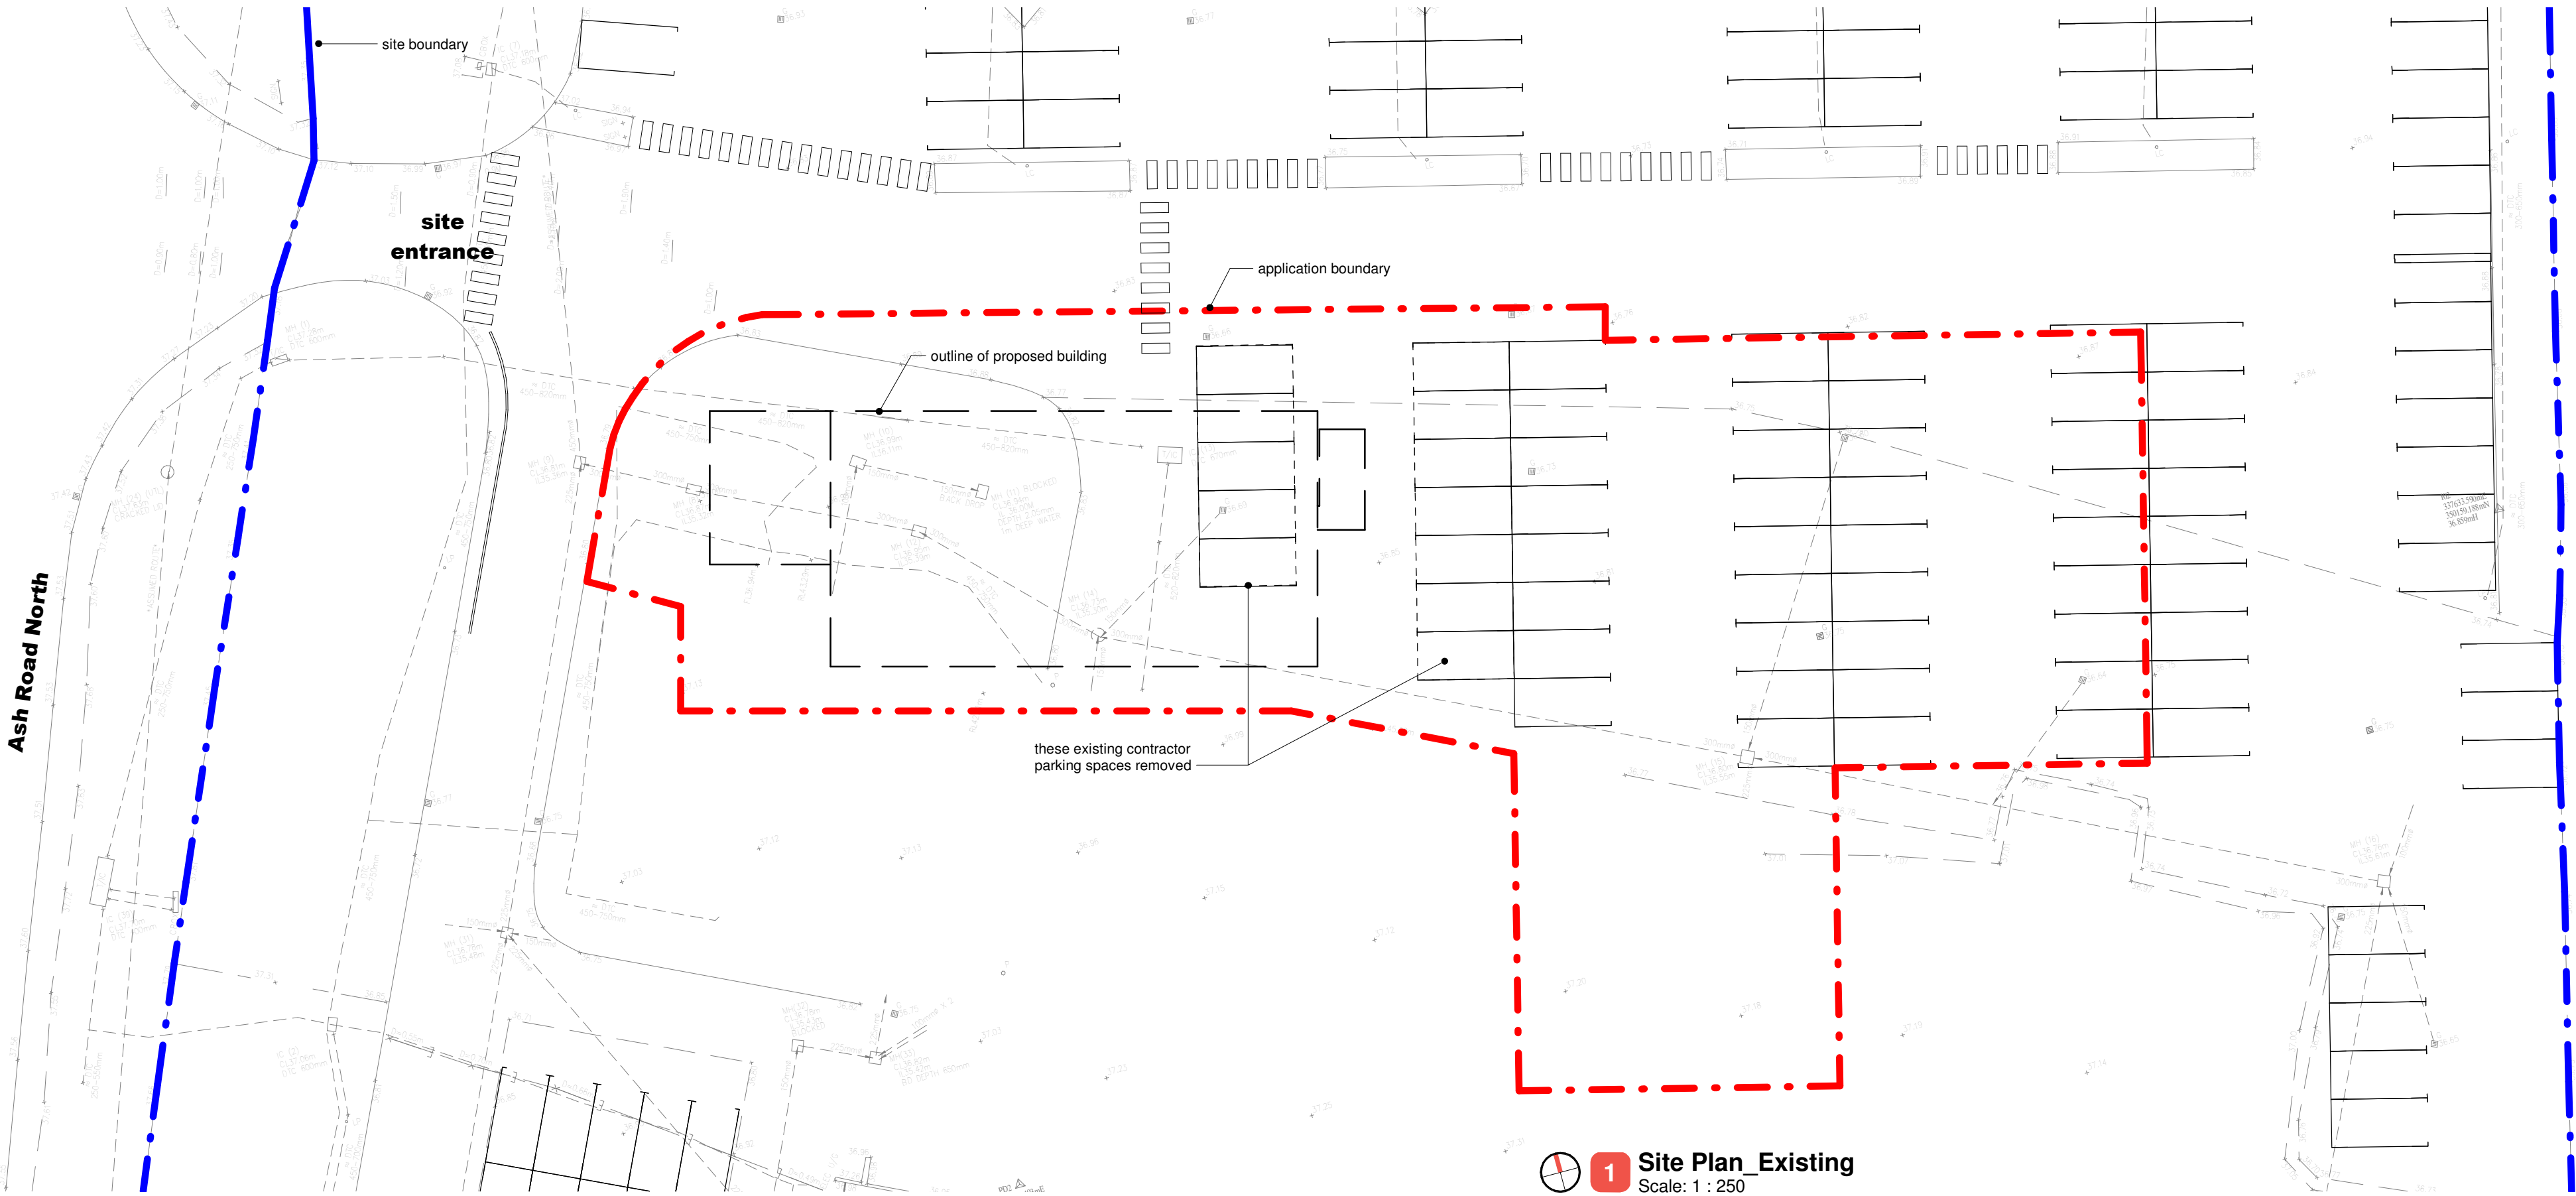

P8	Kellwood Lighting Acton 3A Series 32W Bat Friendly bulkhead lighting added. Note added to car park.	MhR	CR	230807
P7	Biodiversity enhancements added	EmR	CR	230609
P6	redline boundary amended to include car spaces	EmR	CR	230602
P5	12 car spaces re-provided	EmR	CR	230511
P4	updated building location, northpoint amended	EmR	CR	230320
P3	updated building location	EmR	CR	230320
P2	updated building location	EmR	CR	230320
P1	First Issue of Drawing-Issued for Planning	EmR	CR	230223
Rev.	Revision description	Drawn	Checked	Date



Lovelock Mitchell Architects
3 Stanley Street, Chester, CH1 2LS
Tel +44 (0) 1244 404321

e-mail: admin@lovelockmitchell.com
web: www.lovelockmitchell.com

Project
**Ipsen Temporary Offices
Wrexham**

Title
Site_Plans

LMA Project	Drawing number							Rev.
	Project	Originator	Zone	Level	Type	Role	DrawingNumber	
2261	ITO	LMA	XX	XX	DR	A	7010	P8