


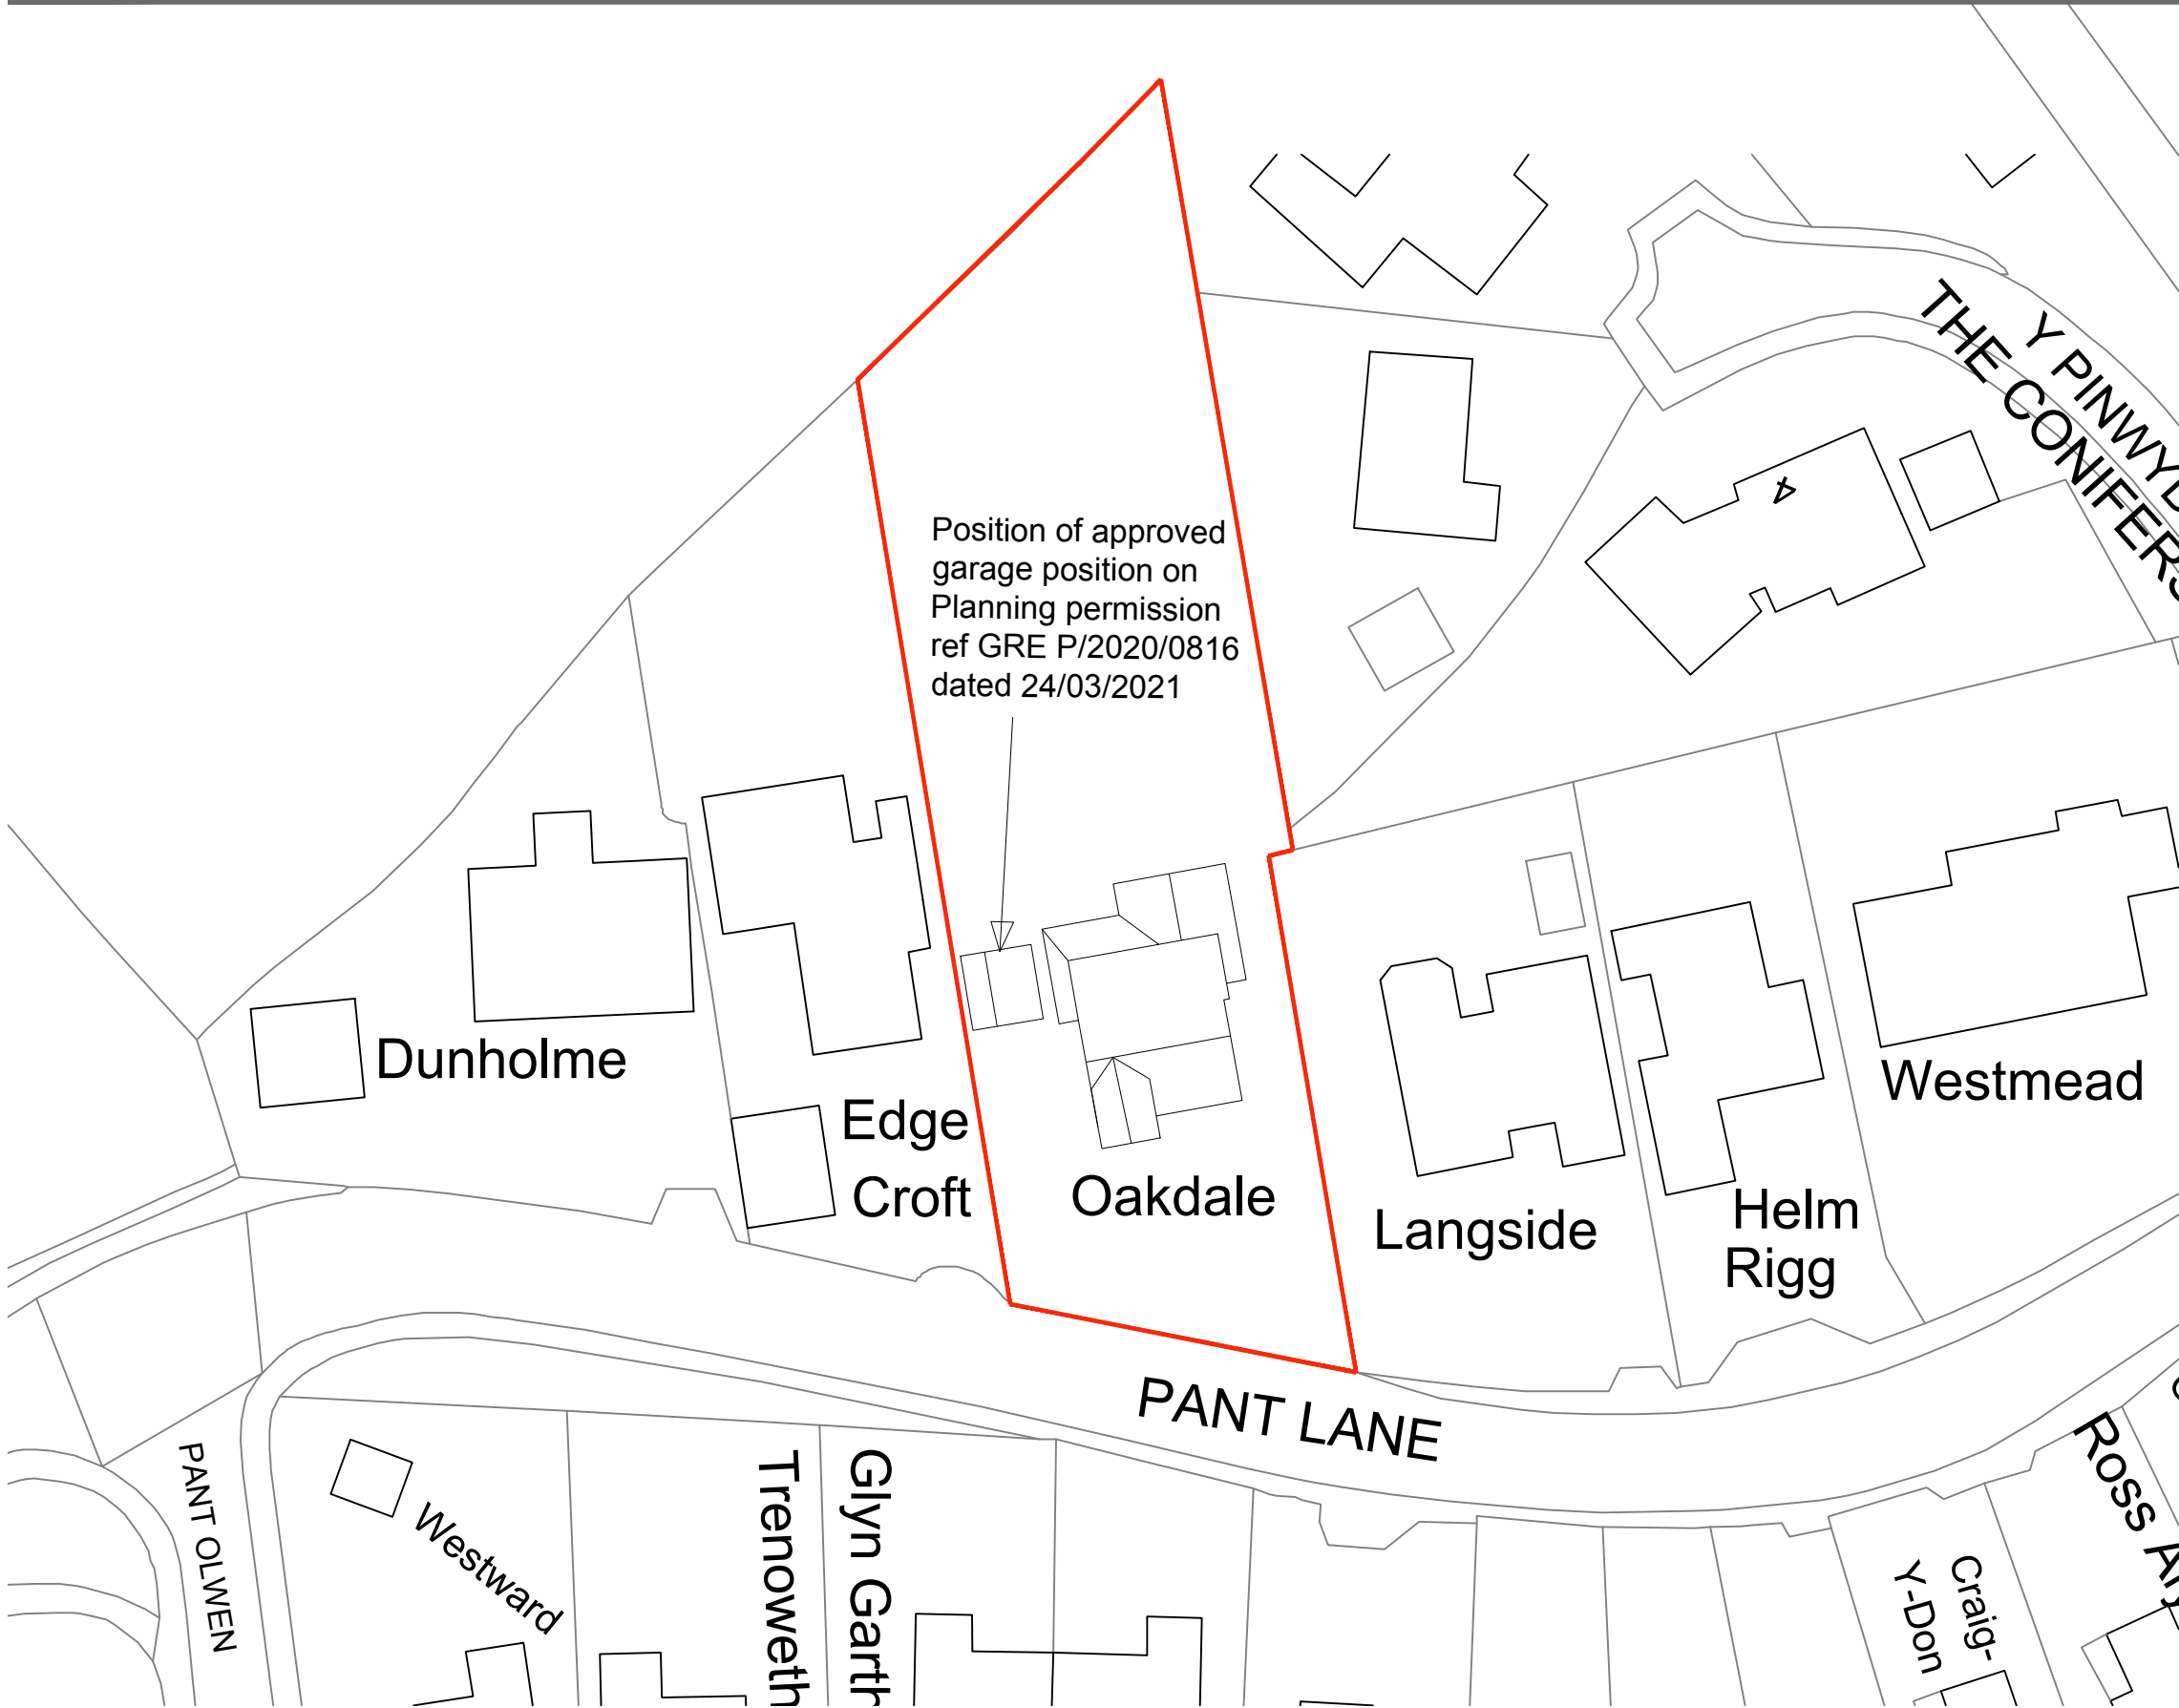

GENERAL NOTES.


ALL CONTRACTORS MUST VISIT THE SITE AND BE RESPONSIBLE FOR FAMILIARISING THEMSELVES WITH THE FULL EXTENT OF THE WORKS AS INDICATED AND / OR TAKING AND CHECKING DIMENSIONS RELATIVE TO THE WORKS SHOWN.

DO NOT SCALE FROM THIS DRAWING, USE FIGURED DIMENSIONS ONLY.

ALL DIMENSIONS TO BE AGREED WITH CLIENT ON SITE.

SPECIFICATION.

REFER TO PLANNING APPLICATION.

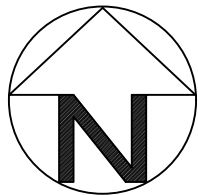

Site plan (1:500)

BOUNDARY SHOWN IN RED

CLIENT MR & MRS TYSON	
PROJECT OAKDALE PANT LANE GRESFORD WREXHAM LL12 8HB	
DESCRIPTION OF WORKS PROPOSED REPOSITIONING OF GARAGE AND STORE	
SHEET TITLE SITE PLAN - WITH POSITION OF PREVIOUS APPROVED POSITION AND SIZE OF GARAGE DATED 24/03/2021 - REF - GRE P/2020/0816	
SCALE 1:500@A3	
DATE MAR 2024	No. 006.1



ACS88 ARCHITECTURE
Tel: 07414145345
Website: www.ACS88.co.uk

© THIS DRAWING IS COPYRIGHT.
WORKING UNDER THE REGISTERED NAME CW9 BWW CAD Services LTD. REGISTERED COMPANY
THIS DRAWING AND THE BUILDING WORKS DEPICTED ARE THE COPYRIGHT OF CW9 BWW CAD
SERVICES
LIMITED AND MAY NOT BE REPRODUCED OR AMENDED EXCEPT BY WRITTEN PERMISSION.
NO LIABILITY WILL BE ACCEPTED FOR AMENDMENTS MADE BY OTHER PERSONS.