


P/2023/0849

Please provide a description of the approved development as shown on the decision letter, including application reference number and date of decision in the sections below. Please also provide the original application type:


Original Window was 120mm x 90mm New Window 120 x 130
Been Living here for five years

as built

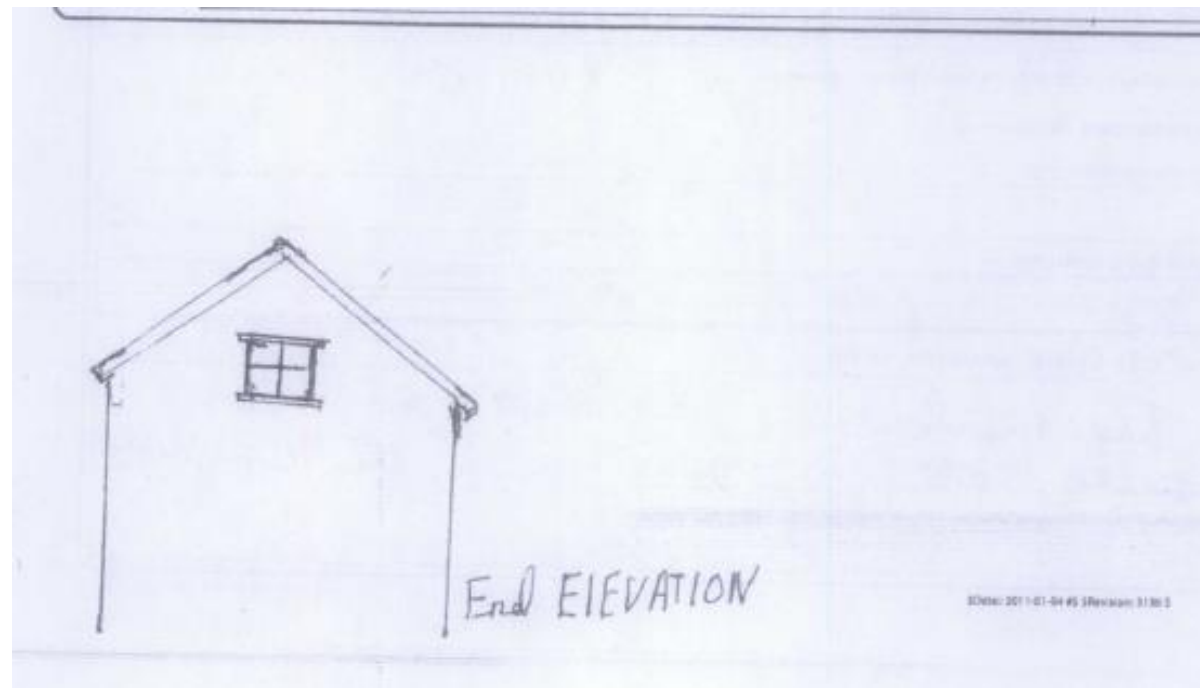

As built

ONLY TO BE USED.
TO BE CHECKED ON SITE BY CONTRACTOR,
TO BE IMMEDIATELY REPORTED TO THE AGENT
ARIFICATION.
ARRIED OUT TO THE SATISFACTION OF THE
NNING AND BUILDING CONTROL OFFICERS.

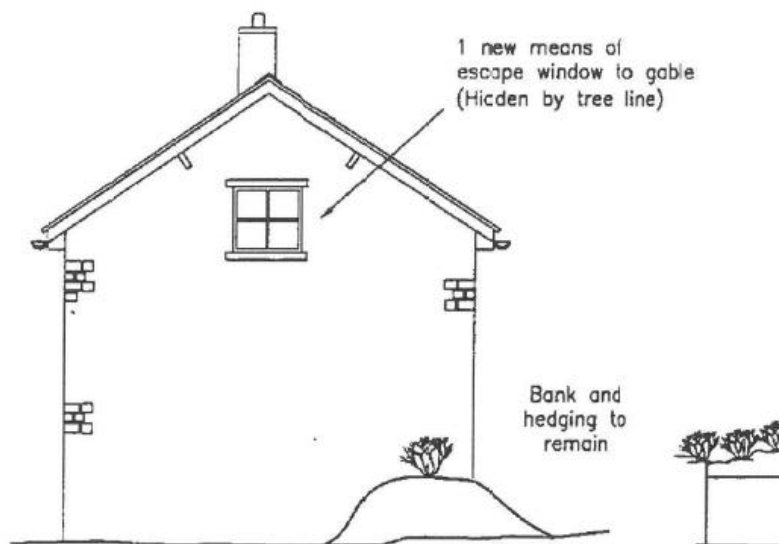

HIGH END ELEVATION (1:100)



As approved