

TOTAL SCALE: 1/2" = 1'-0"
ALL DIMENSIONS TO BE CHECKED ON SITE.
COPYRIGHT PROTECTED.

FOR INFORMATION


This store was constructed Post 2000. The importation, supply and use of asbestos was prohibited on the 24th November 1999. Therefore, asbestos should not have been used on M&S premises and an asbestos survey is not required.

PLEASE NOTE:
LUMINANCE LEVEL FOR A STANDARD M&S EXTERNAL TOTEM IS 300 CD/SDM

KEY


PROPOSED TOTEM LOCATION

PLEASE NOTE:
1No. EXTERNAL TOTEM
INSTALLED.


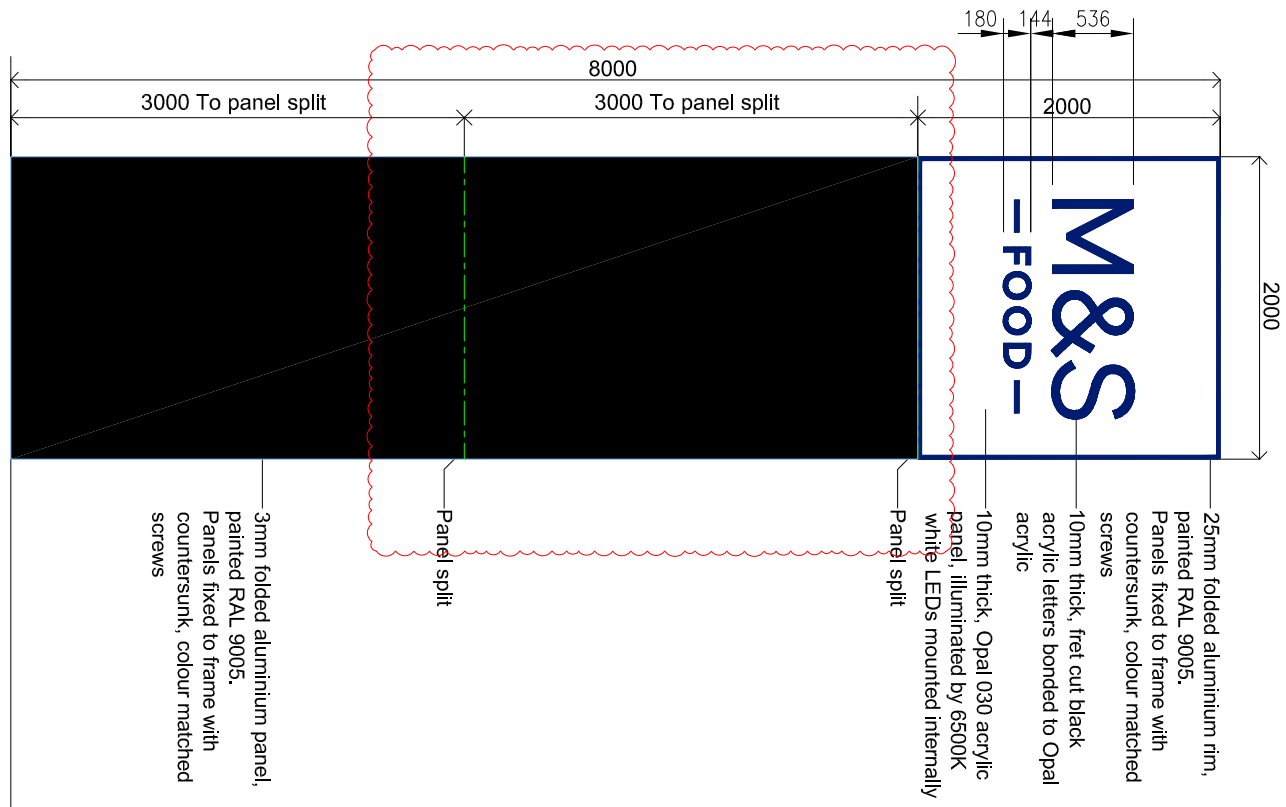


Totem Elevation (Food)
Scale 1:50


Totem Frame Section
Scale 1:50

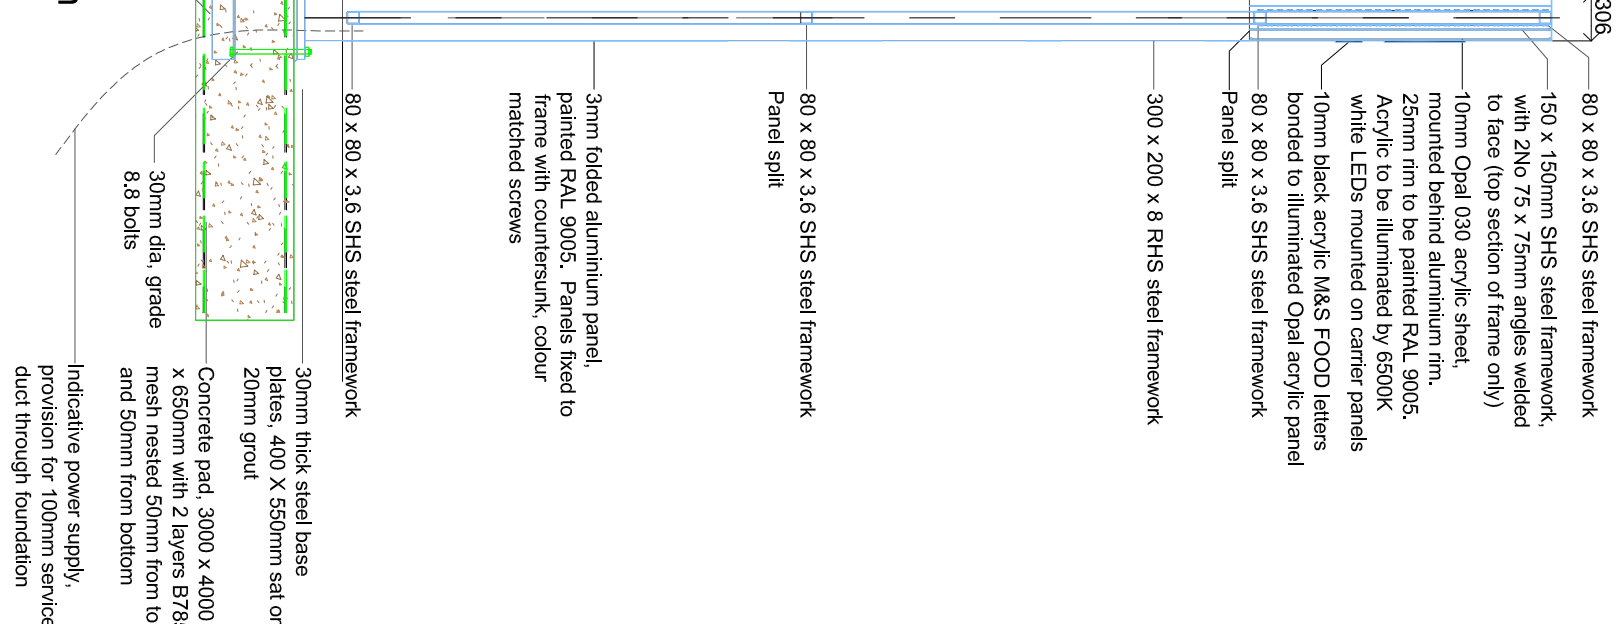


Totem Frame
Scale 1:50

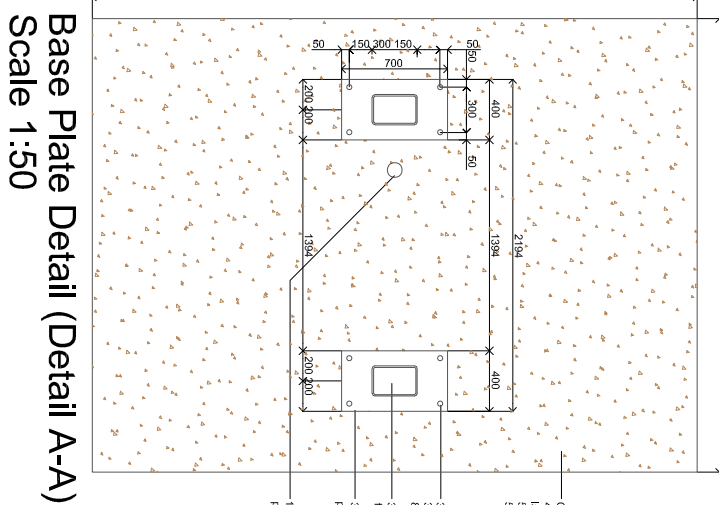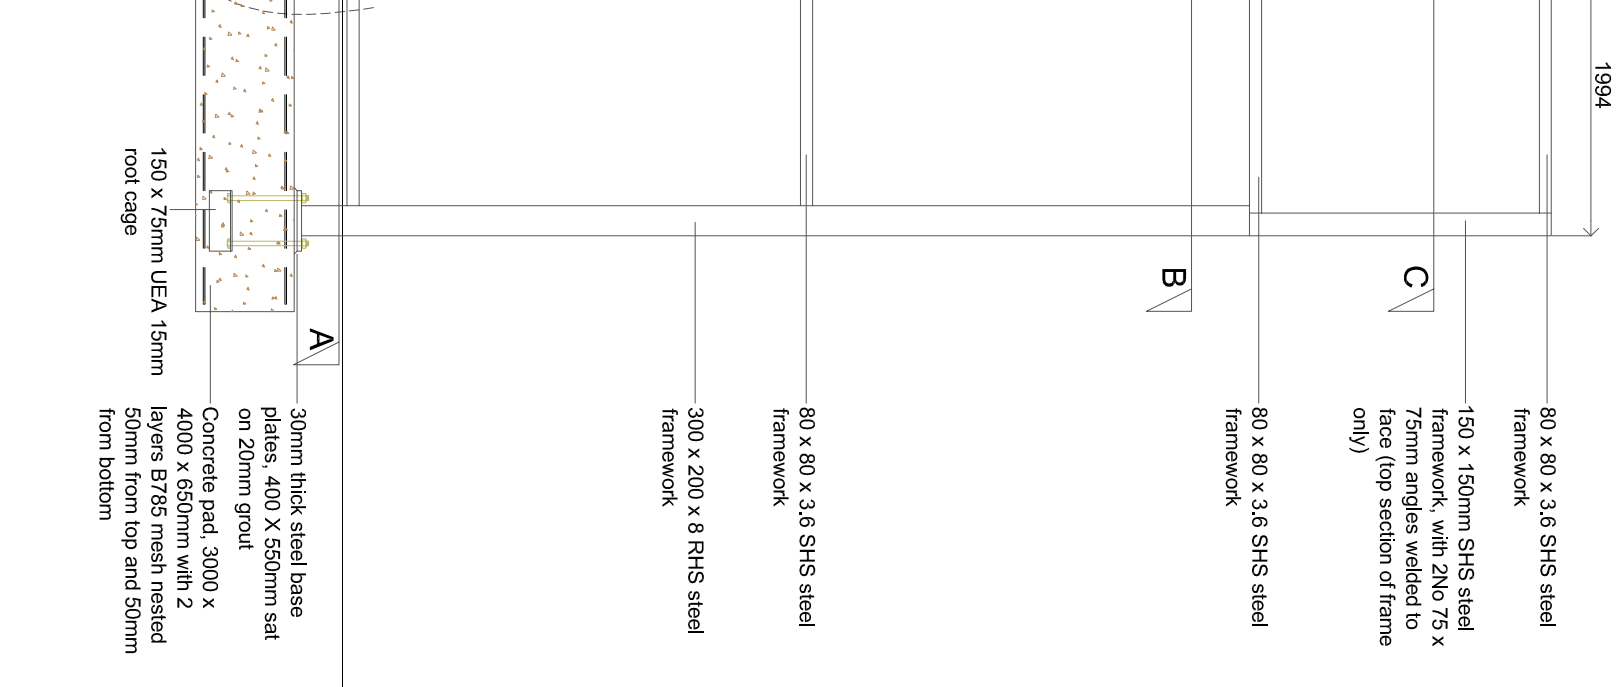


Base Plate Detail (Detail A-A)
Scale 1:50

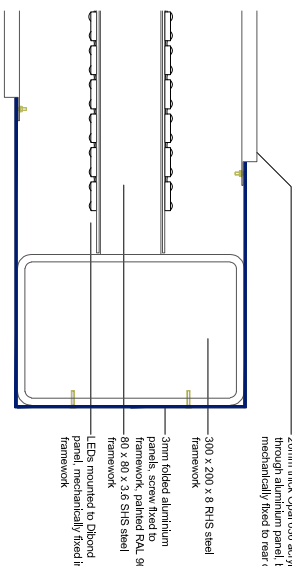


Push Through Detail (Detail B-B)
Scale 1:10

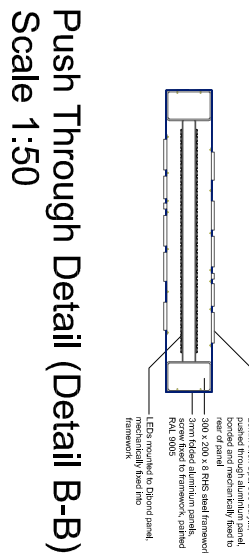


Push Through Detail (Detail B-B)
Scale 1:50

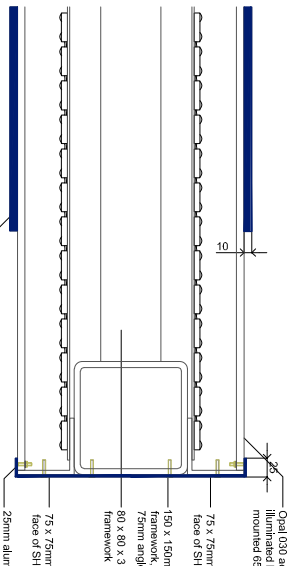

Acrylic Letter Detail (Detail C-C)
Scale 1:10

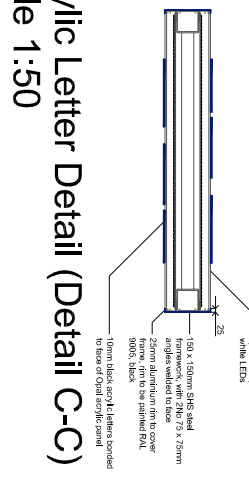

Acrylic Letter Detail (Detail C-C)
Scale 1:50

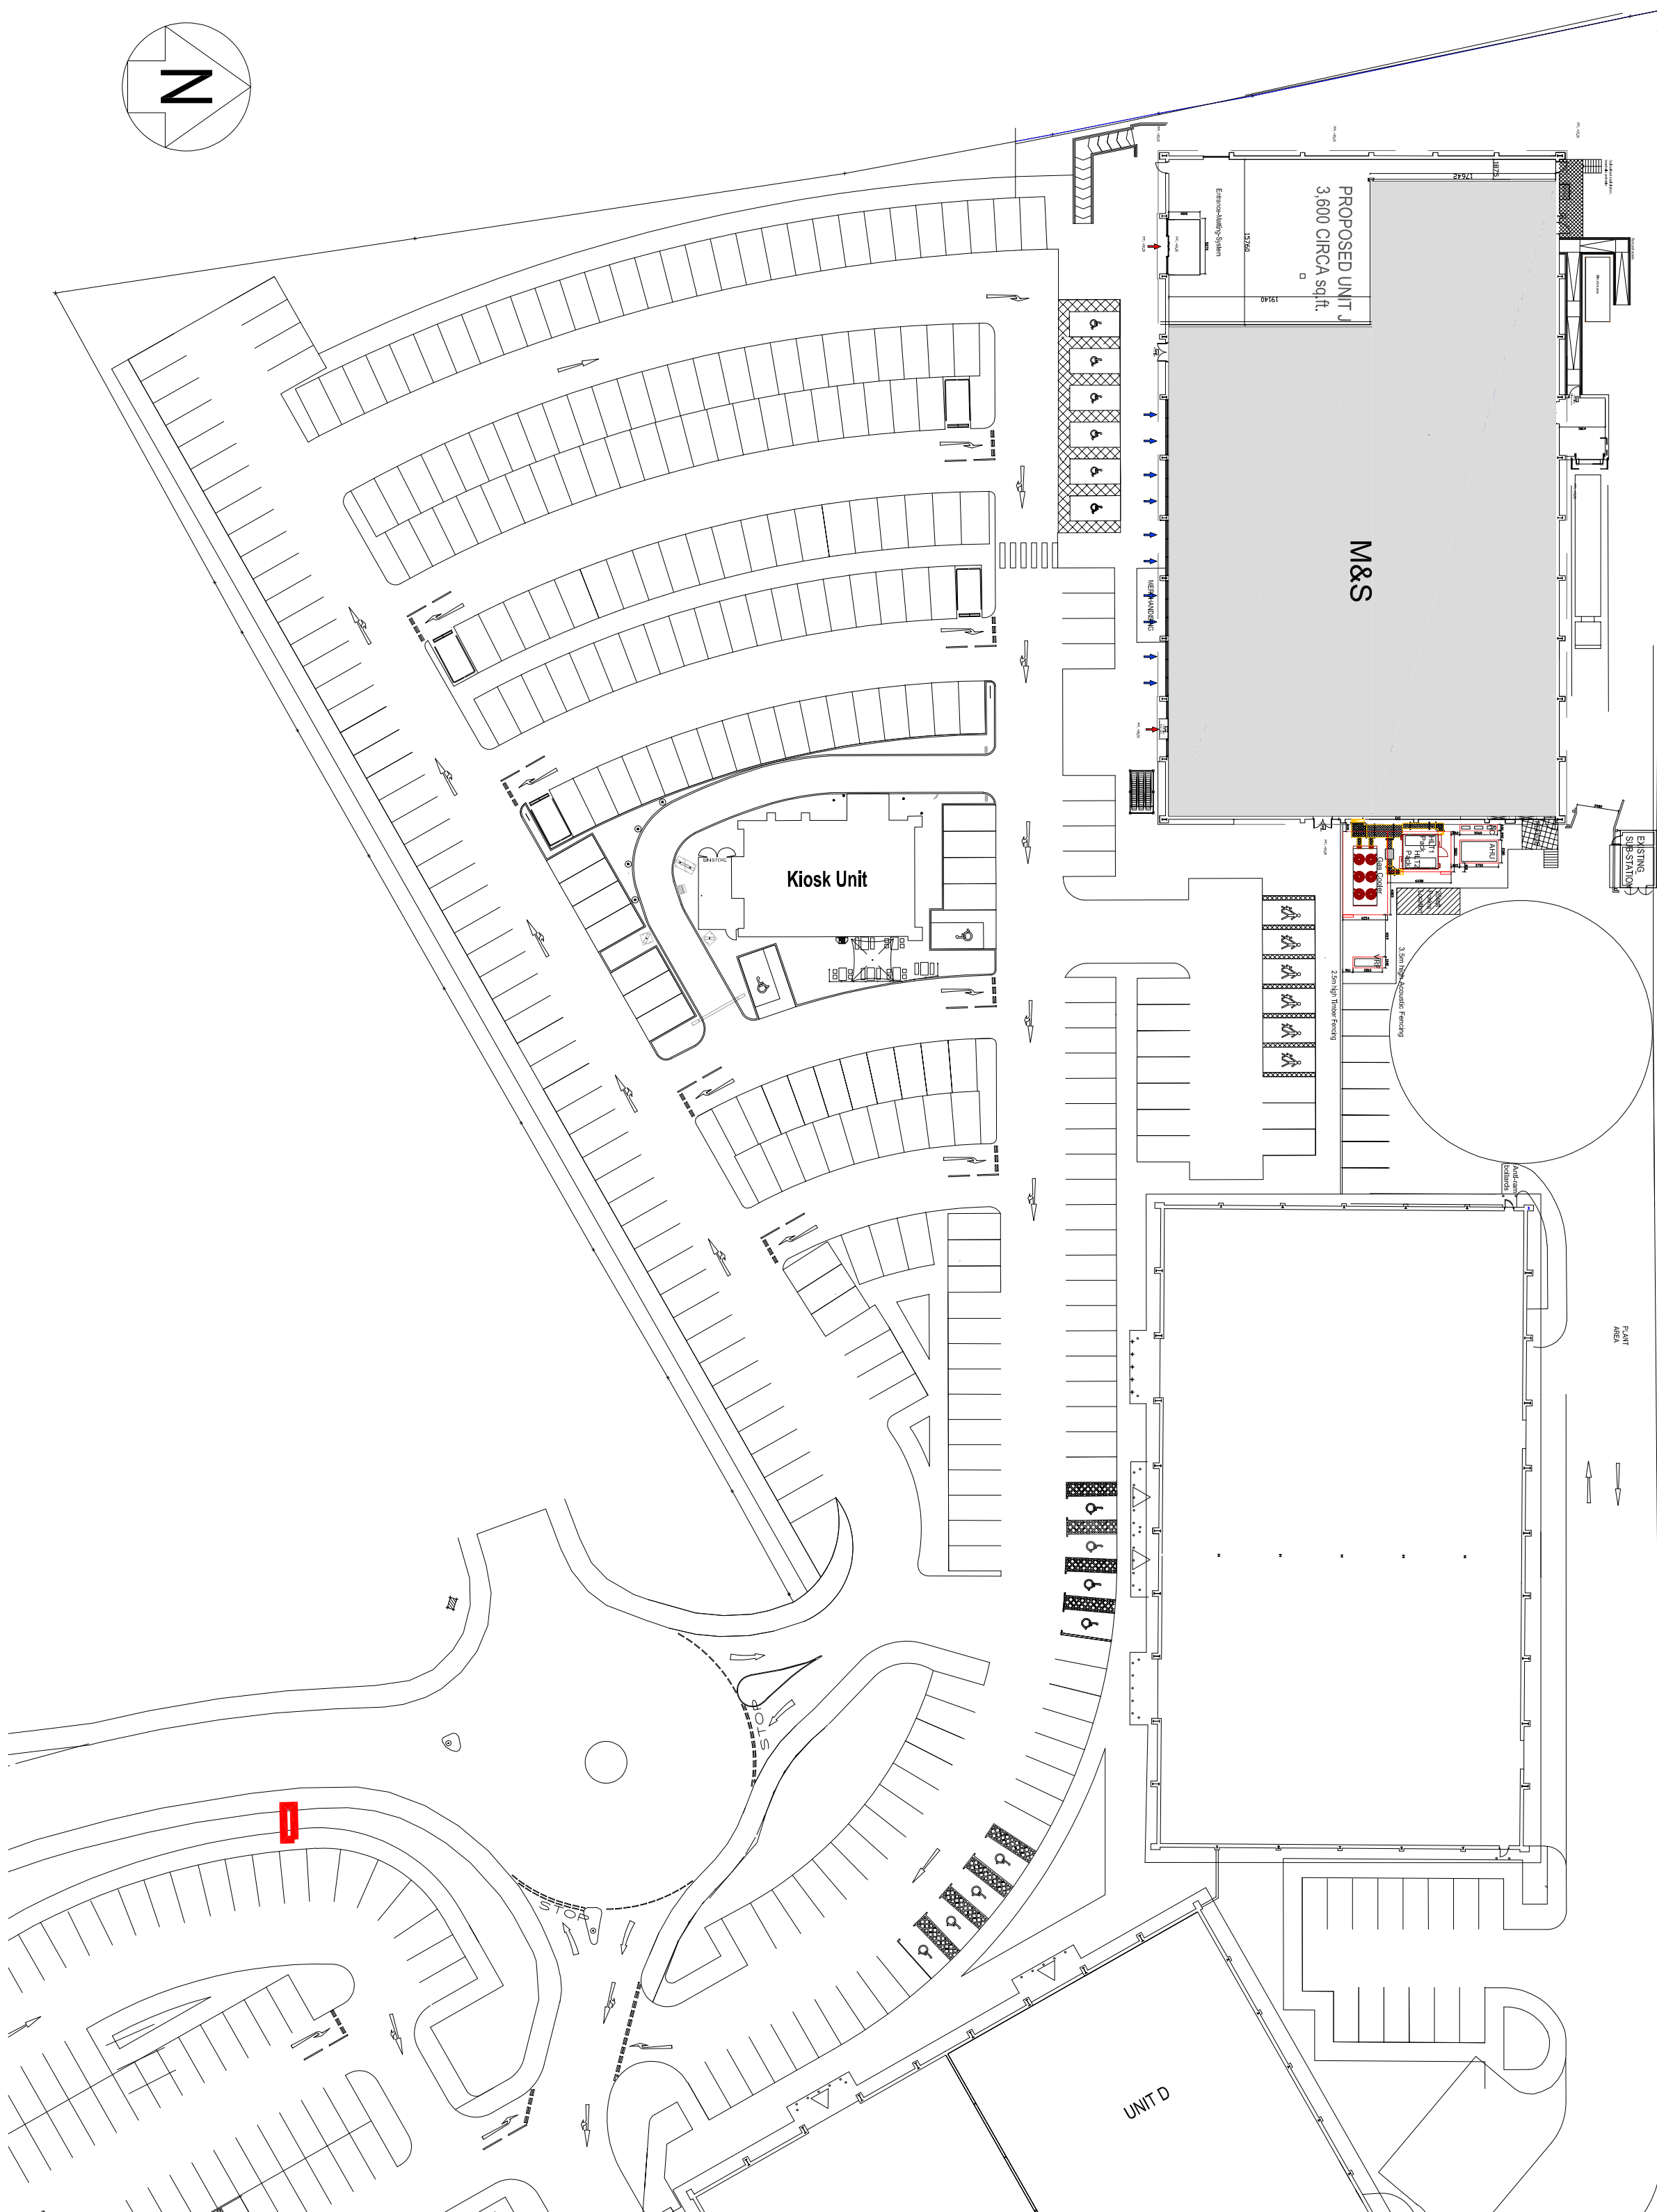

TOTEM SIGN LOCATION PLAN
Scale 1:500

STORE NAME
M&S Wrexham
COUNTY
United Kingdom
PROJECT
Marks and Spencer
New Store
DRAWINGS
Proposed
Illuminated Totem
Details

CONSULTANT
DB3 Ltd
DRAWING DESCRIPTION
Architect
CONSULTANT LOGO

LEGEND
1/4" Floor, 10 South Parade, Leeds LS1 5QS.
T: 0113 2446931 www.dammondh.com

SCALE
PAPER SIZE DATE DRAWN CHECKED
Various A1 14.06.23 DH SW
STORE NUMBER PROJECT No DRAWING No
0191 WRE001 A 9001
CONSULTANT PROJECT No STATUS REVISION
15287 I 02