

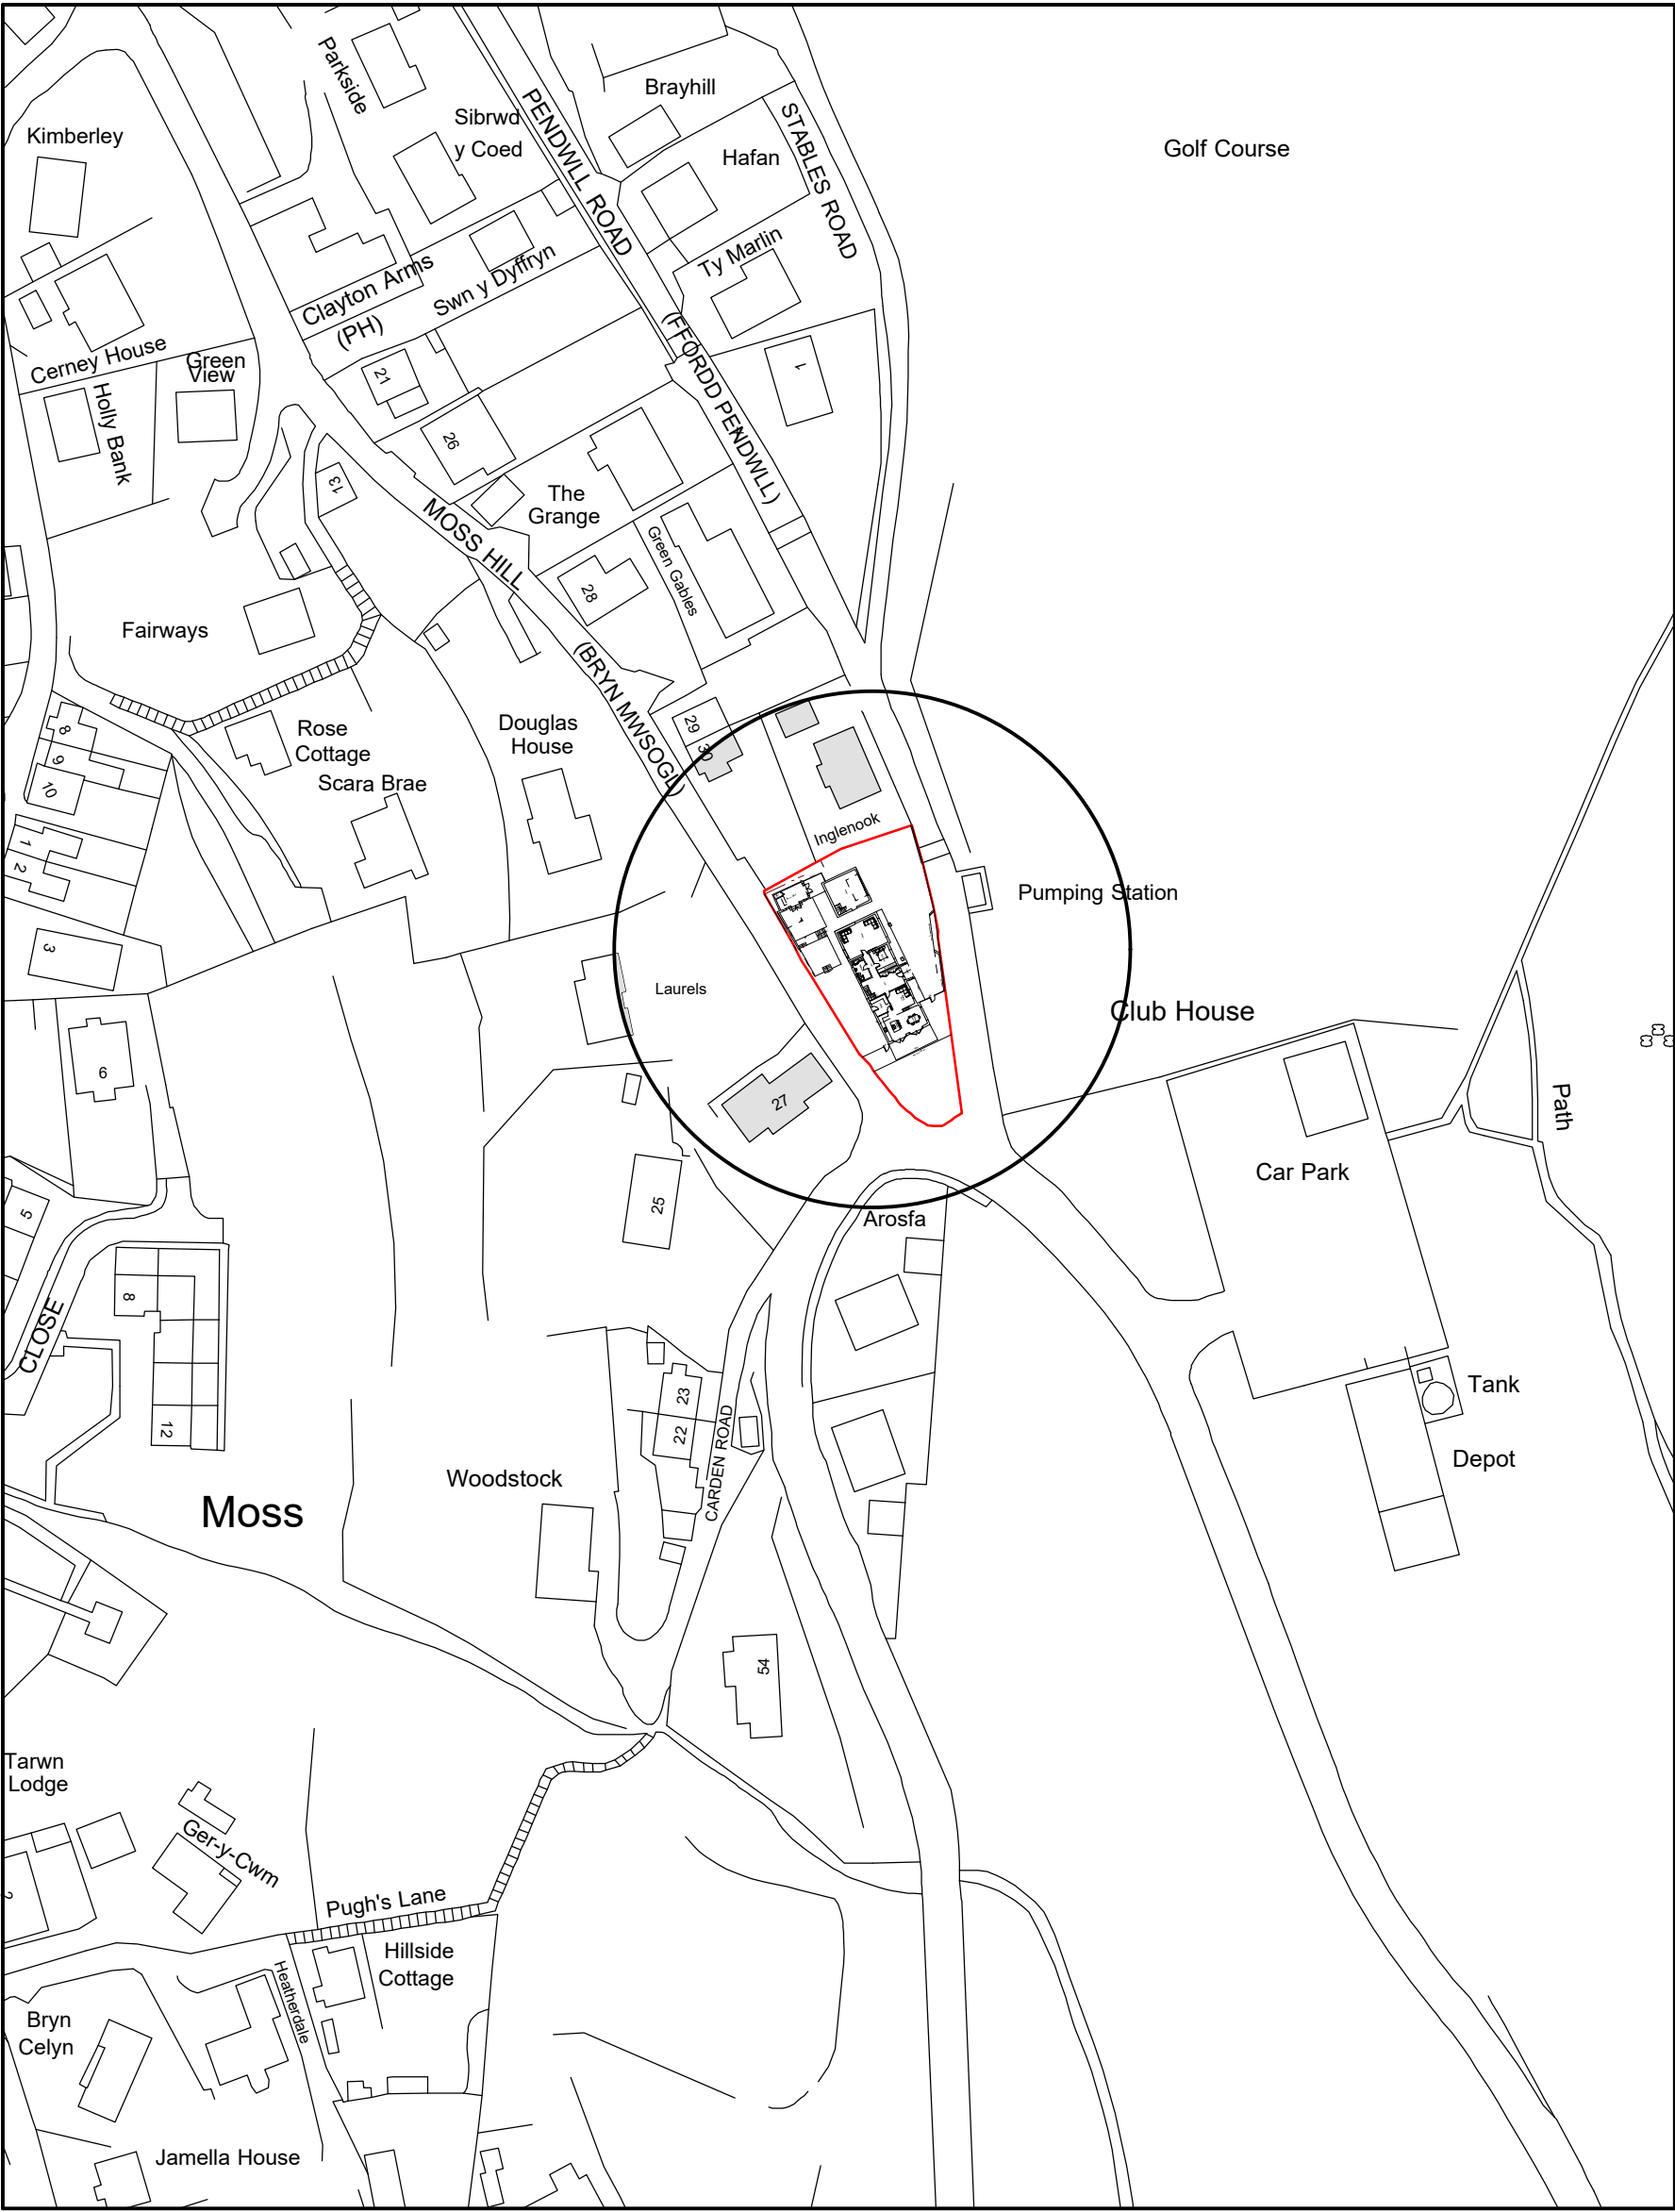


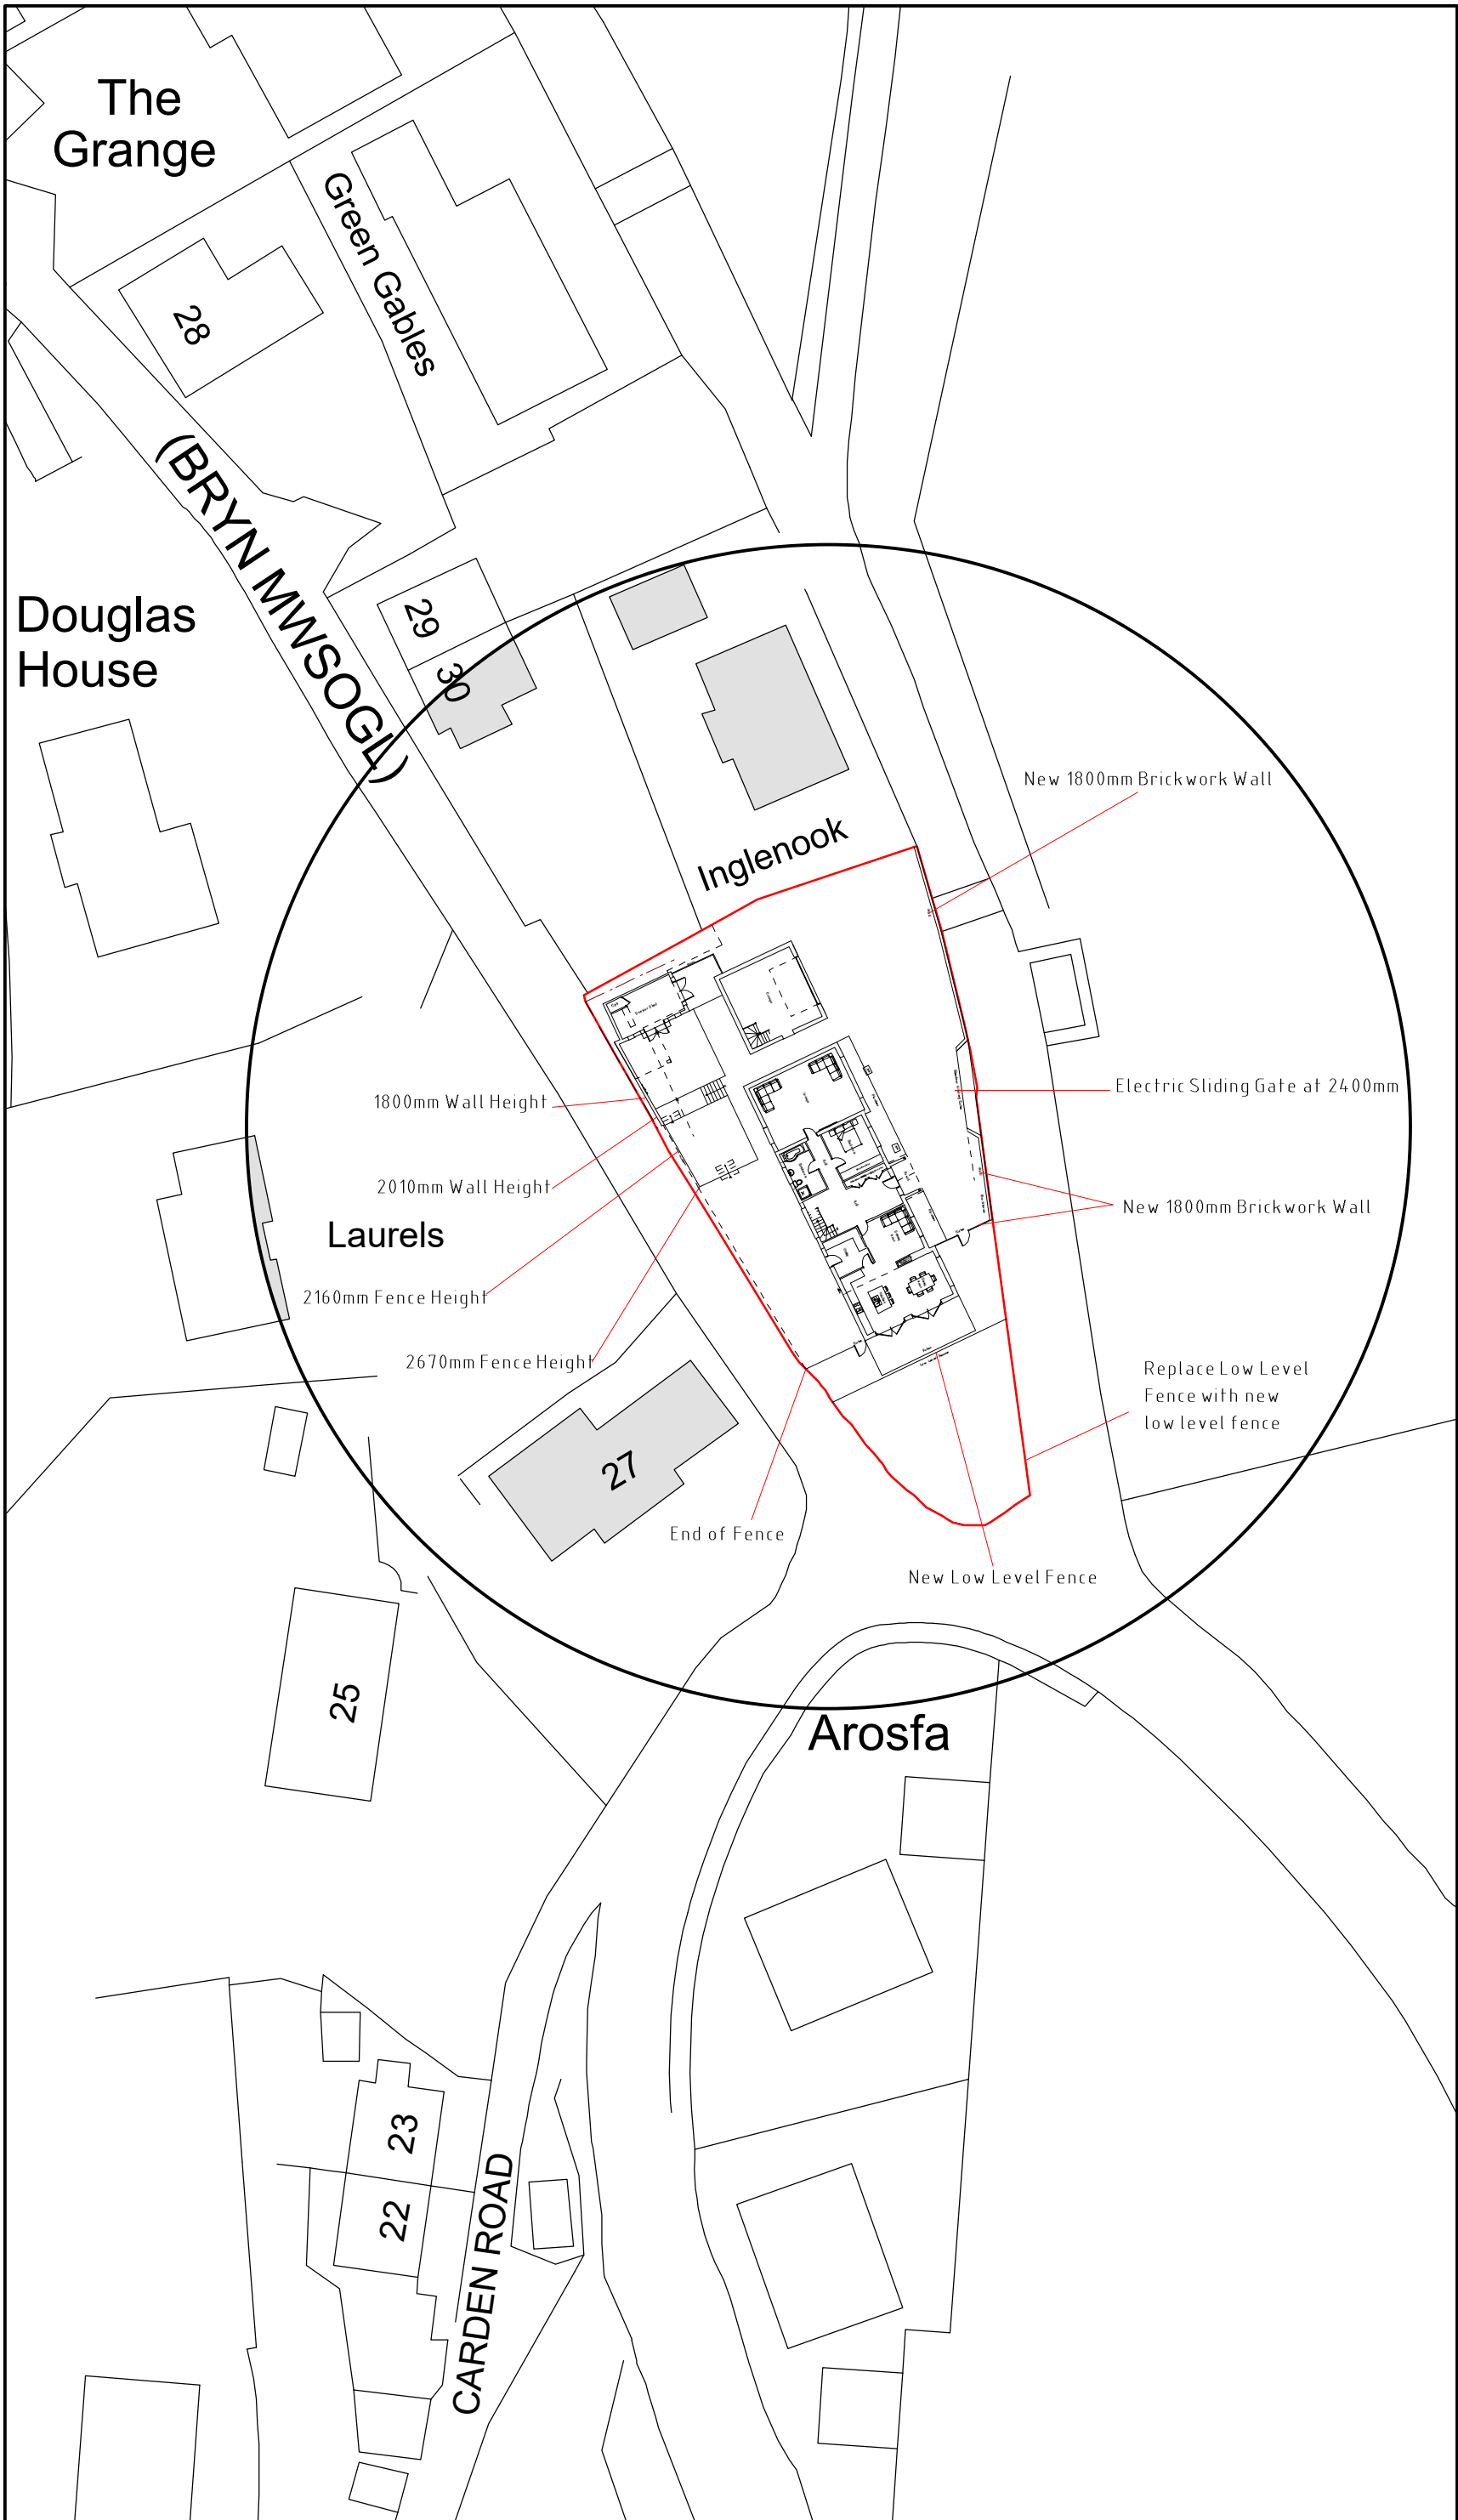

Location Plan 1:1250

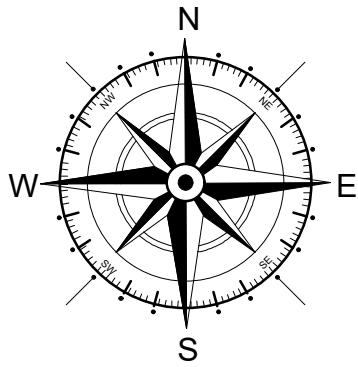

Key	
	Surrounding Buildings
	Application Site

A	07/23	Update		E M J
Rev	Date	Detail		Initial

Project:
Proposed Alterations to,
33 Moss Hill, Moss,
Pentre Broughton,
Wrexham, LL11 6ES.

Title:
As Built: Site &
Location Plan

Scale: (A2)
1:500 &
1:1250

Drawn By:
A.Valentine

Date:
July 2023

Drawing No:
J186/002

Sheet:
1 of 1

blueprint
architectural services



Office 3K4,
Redwither Business Tower,
Wrexham. LL13 9XT
Tel: 01978 356500
www.blueprintarchitectural.com

© copyright all rights reserved