


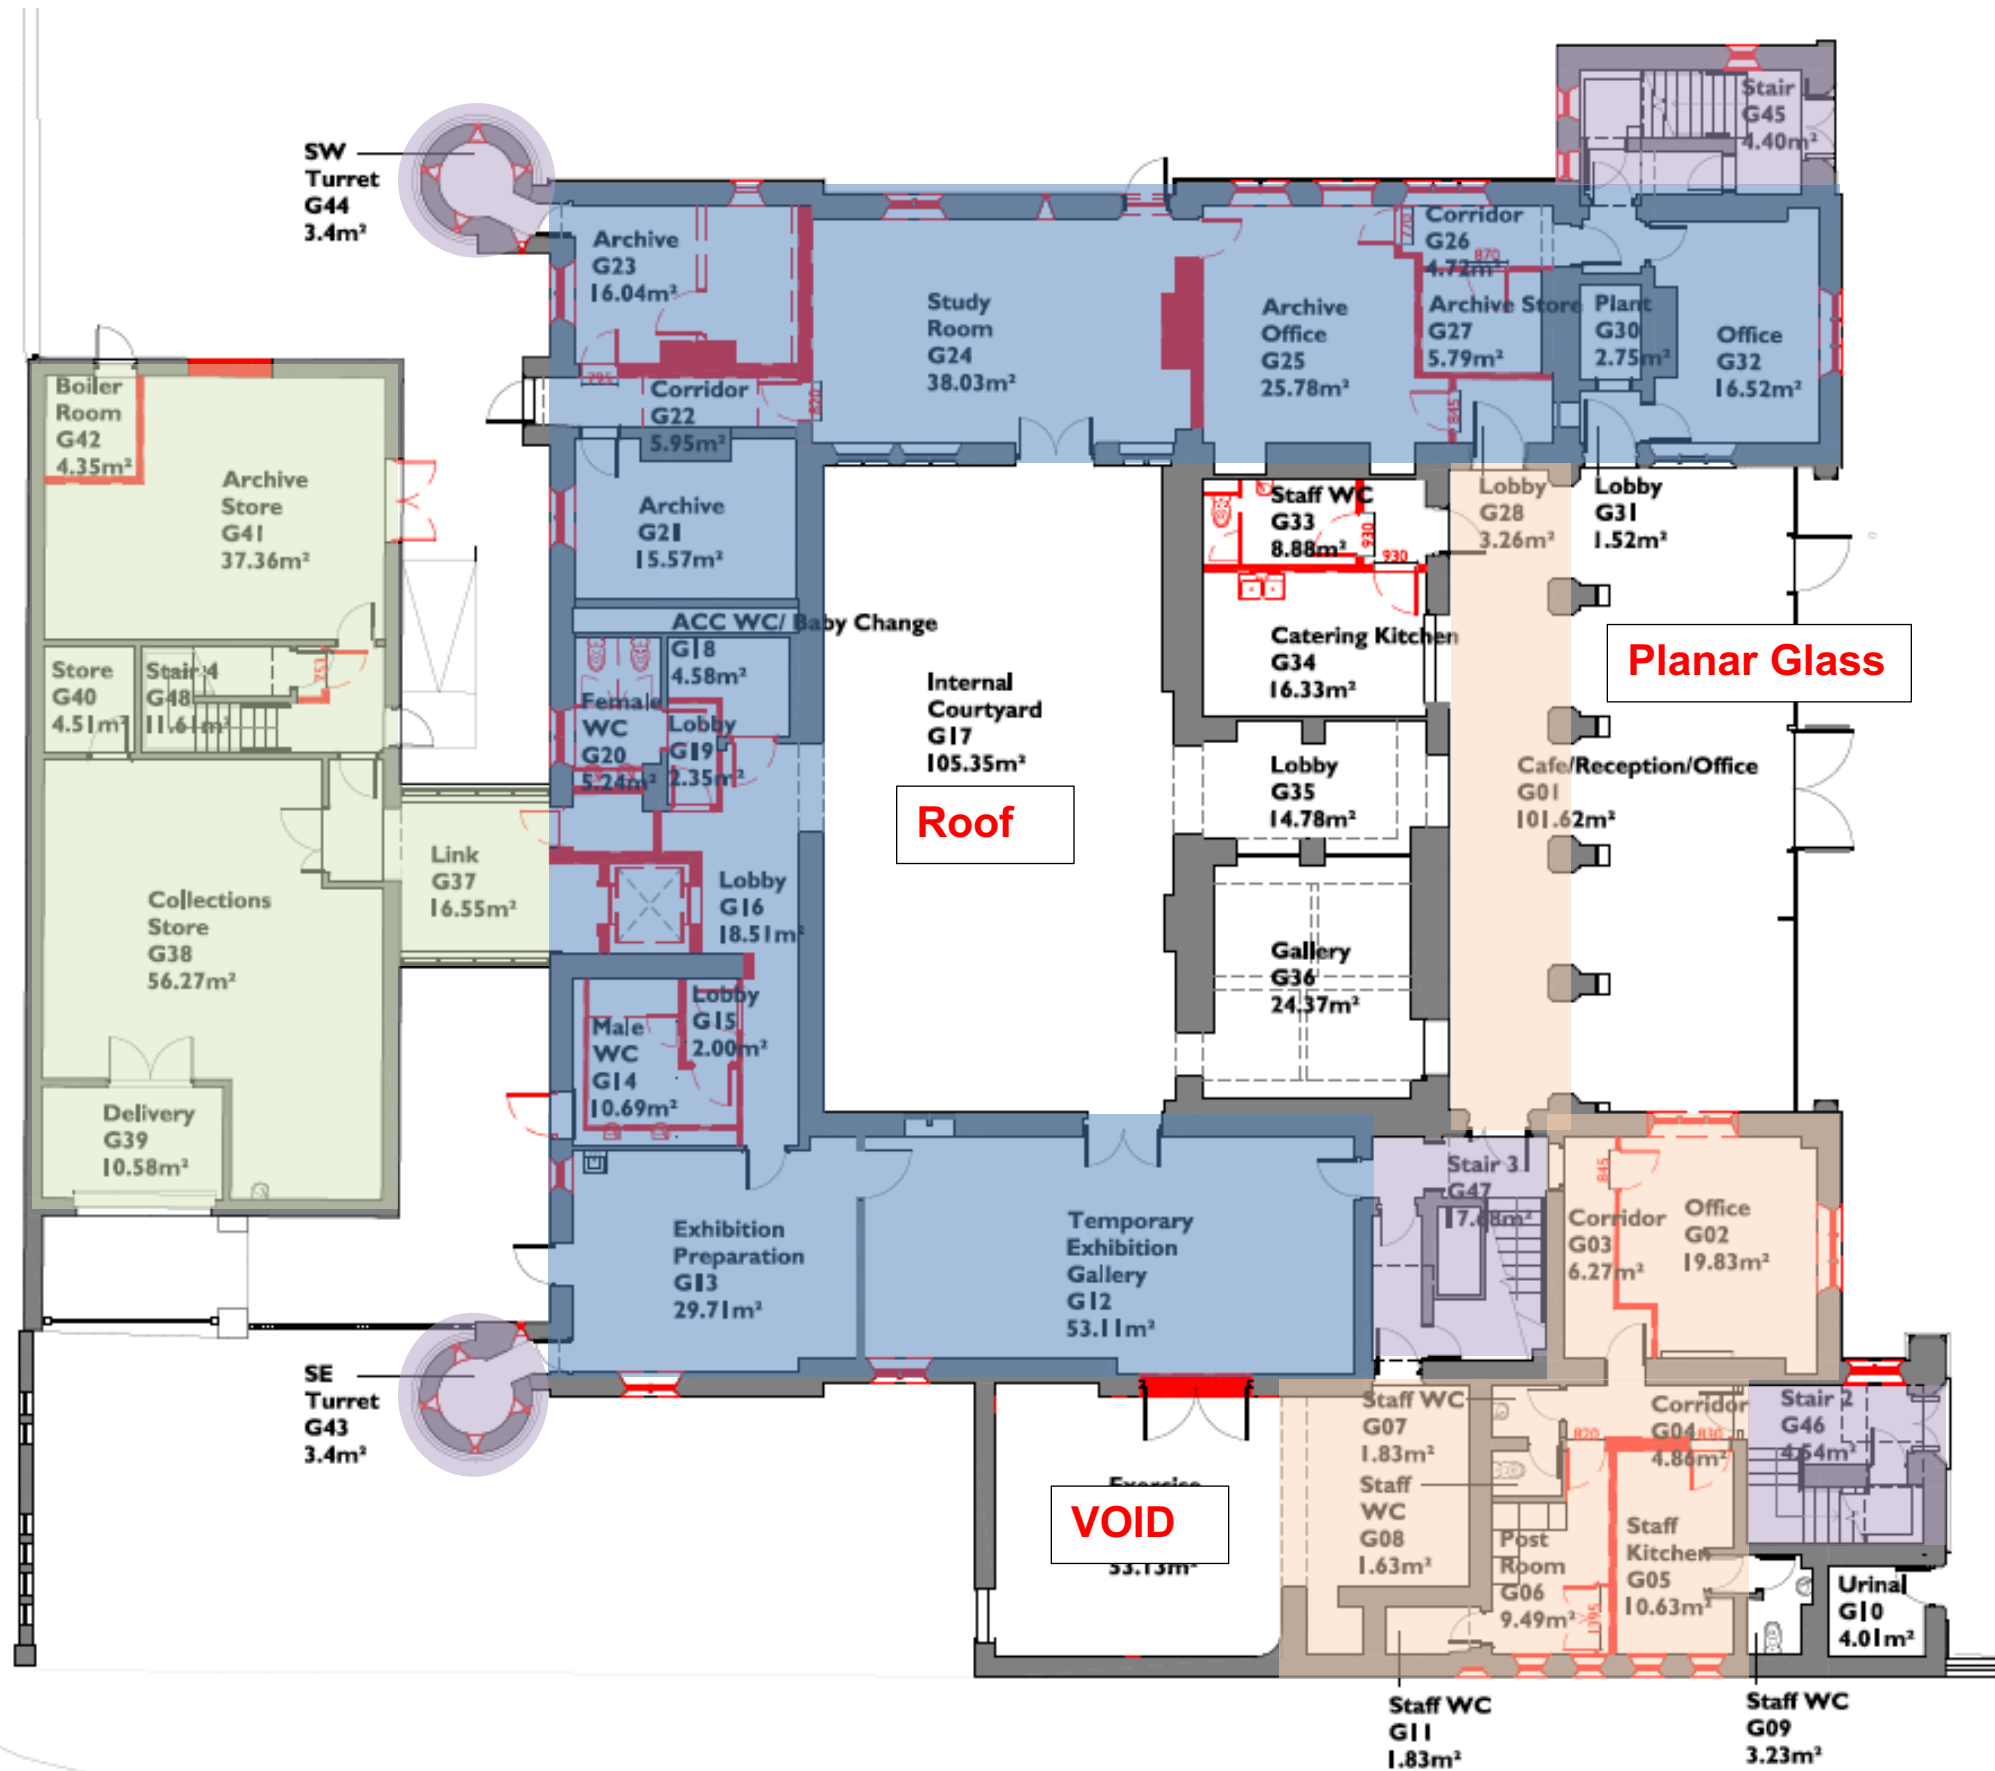

Existing Ground Floor Plan – Used for Mark Up

KEY

Brick Jack Arch & Cast Iron Beam Floor

Timber Joist Floor

Precast Concrete Unit Floor

Unknown (white / clear)

Staircases are stone

Rev A – May 2023 – Initial Issue.



Blackett-Ord Conservation Engineering

5th Floor, Horton House, Exchange Flags, Liverpool, L2 3PF
Tel: 0151 353 7130 - email: ian@blackett-ordconservation.co.uk

Wrexham Museum
Structural Investigations
First Floor Construction Types

Job No: X73 Date: May 2023 Drg No SK37 Rev A