


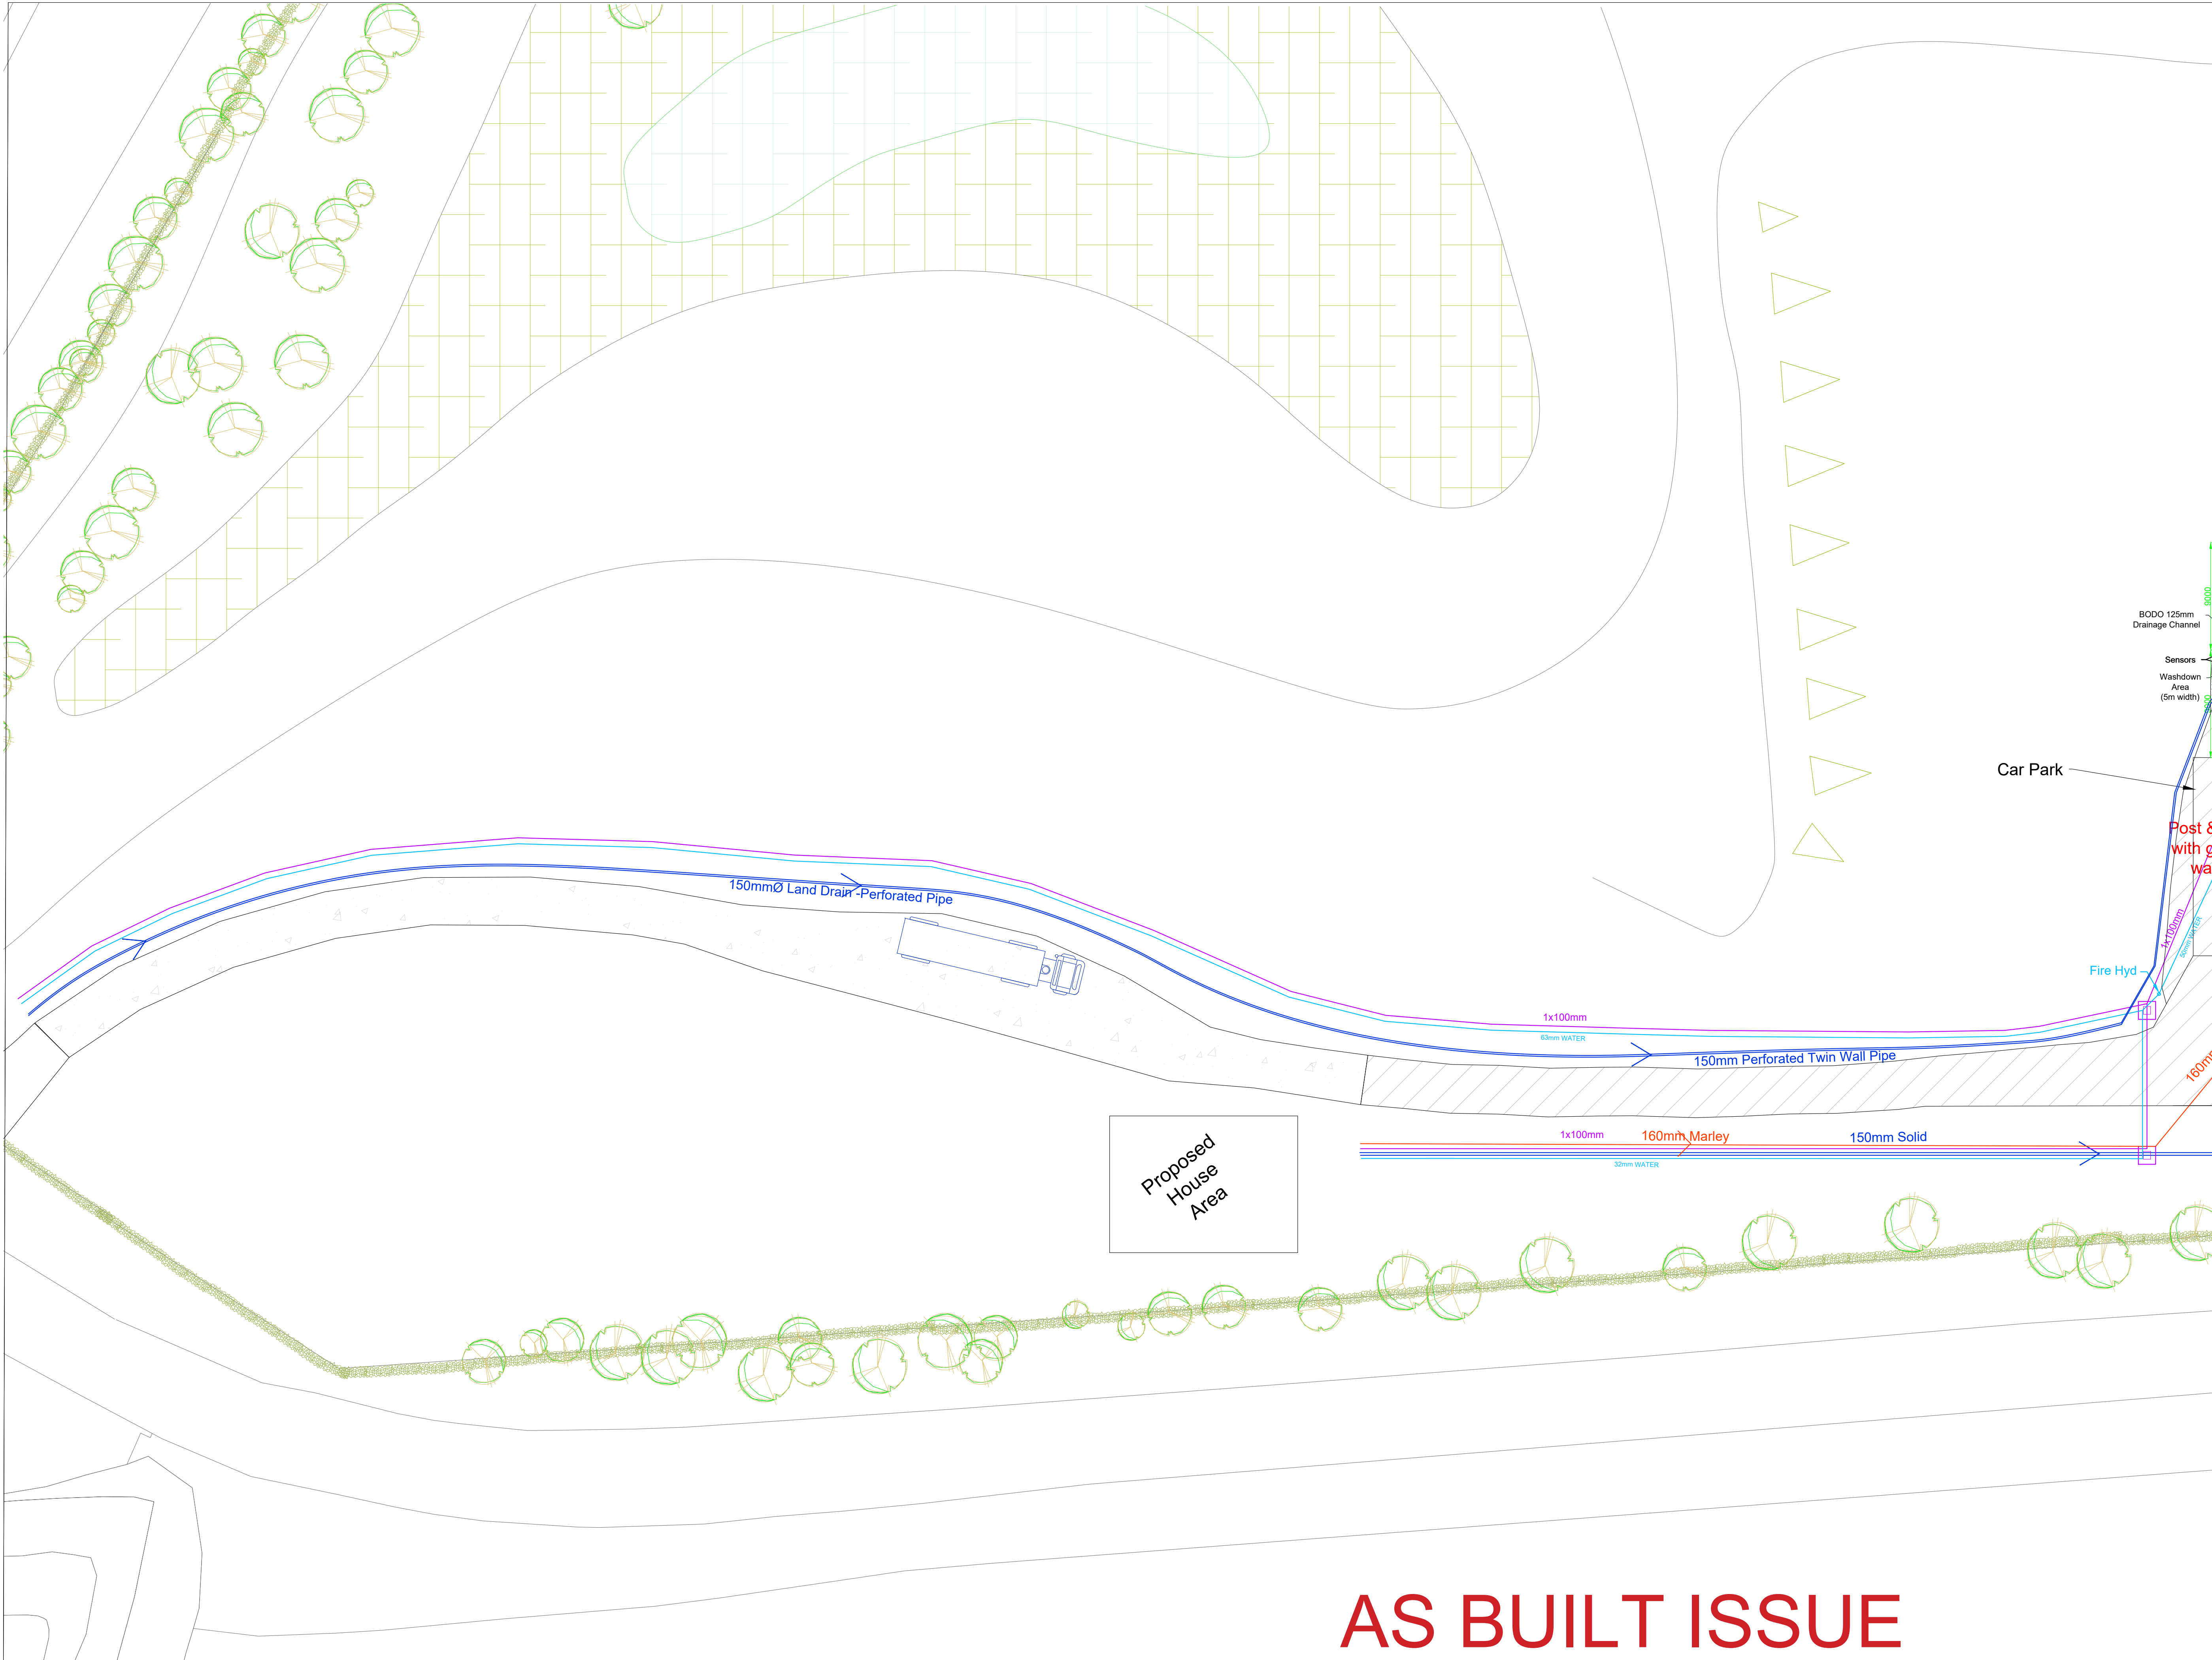

GENERAL NOTES:

- THIS DRAWING IS PRELIMINARY.
- All dimensions are in millimeters (mm). all levels are in metres (m) unless noted otherwise.
- Discrepancies or omissions are to be reported to the Engineer prior to work commencing.
- Materials and workmanship are to comply in all respects with current British Standard Specifications, Codes of Practice and Building Regulations Approved Documents.
- The copyright of this drawing is vested in the engineer and must not be copied or reproduced without written consent.
- The Contractor is to check and verify all building and site dimensions, levels and sewer invert levels at connection points before work commences.
- This drawing is to be read in conjunction with all relevant specifications and drawings issued by the Engineer, Architect and other Specialists.
- Unless we have expressly included for design within our contract this drawing is supplied purely to demonstrate our pricing methodology or for operational purposes.
- Unless we have expressly included for design within our contract Knights Construction Ltd accept no design liability.

Key

Water services	Materials
Water pipe (Size noted)	Concrete
	20 / 40mm single size
Electrical services	Clean drainage
Duct pipe (Size noted)	French Drain
600mm duct chamber	Solid twin wall
Duct Ring Chamber (Diameter noted)	Inspection chamber (450mm Dia)
	Inspection chamber (600mm Dia)
Products	Dirty drainage
Square Hopper	Marley pipe (size noted)
Yard gully (740 x 450mm Plastic Road Gully)	PPIC (600mm dia)
Sweeping 90° bend pipe	PPIC Ring (1000mm dia)
45° bend pipe	Galvanised washout channel with sweeping 90°
30° bend pipe	Dirty Water Tank
15° bend pipe	
Single 'Y' Branch pipe	Gas services
Reducer	Gas pipeline

KNIGHTS CONSTRUCTION

Knights Construction Ltd.
Hafod Y Bwch Farm
Middle Sontely
Wrexham
LL13 0YP
United Kingdom
Tel: 01978 846 841

Client:

Aviagen Llay

Project Address:

Aviagen,
Rackery Lane,
Llay,
Wrexham,
LL12 0PB

Scale A1:	Date:
1:250	06/02/2019
Drawn By:	
SM	

Sheet Number:	Revision:
10 of 11	AB1
	Drawing number:
	Q562 2291 - AB1 -ACC

Drawing Title:

All Works Access Road

AS BUILT ISSUE