


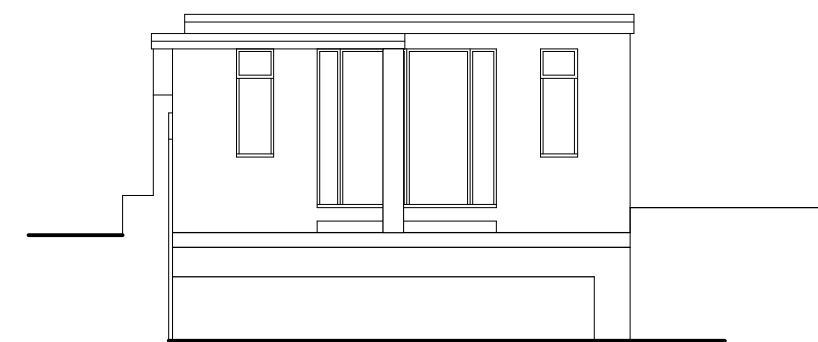


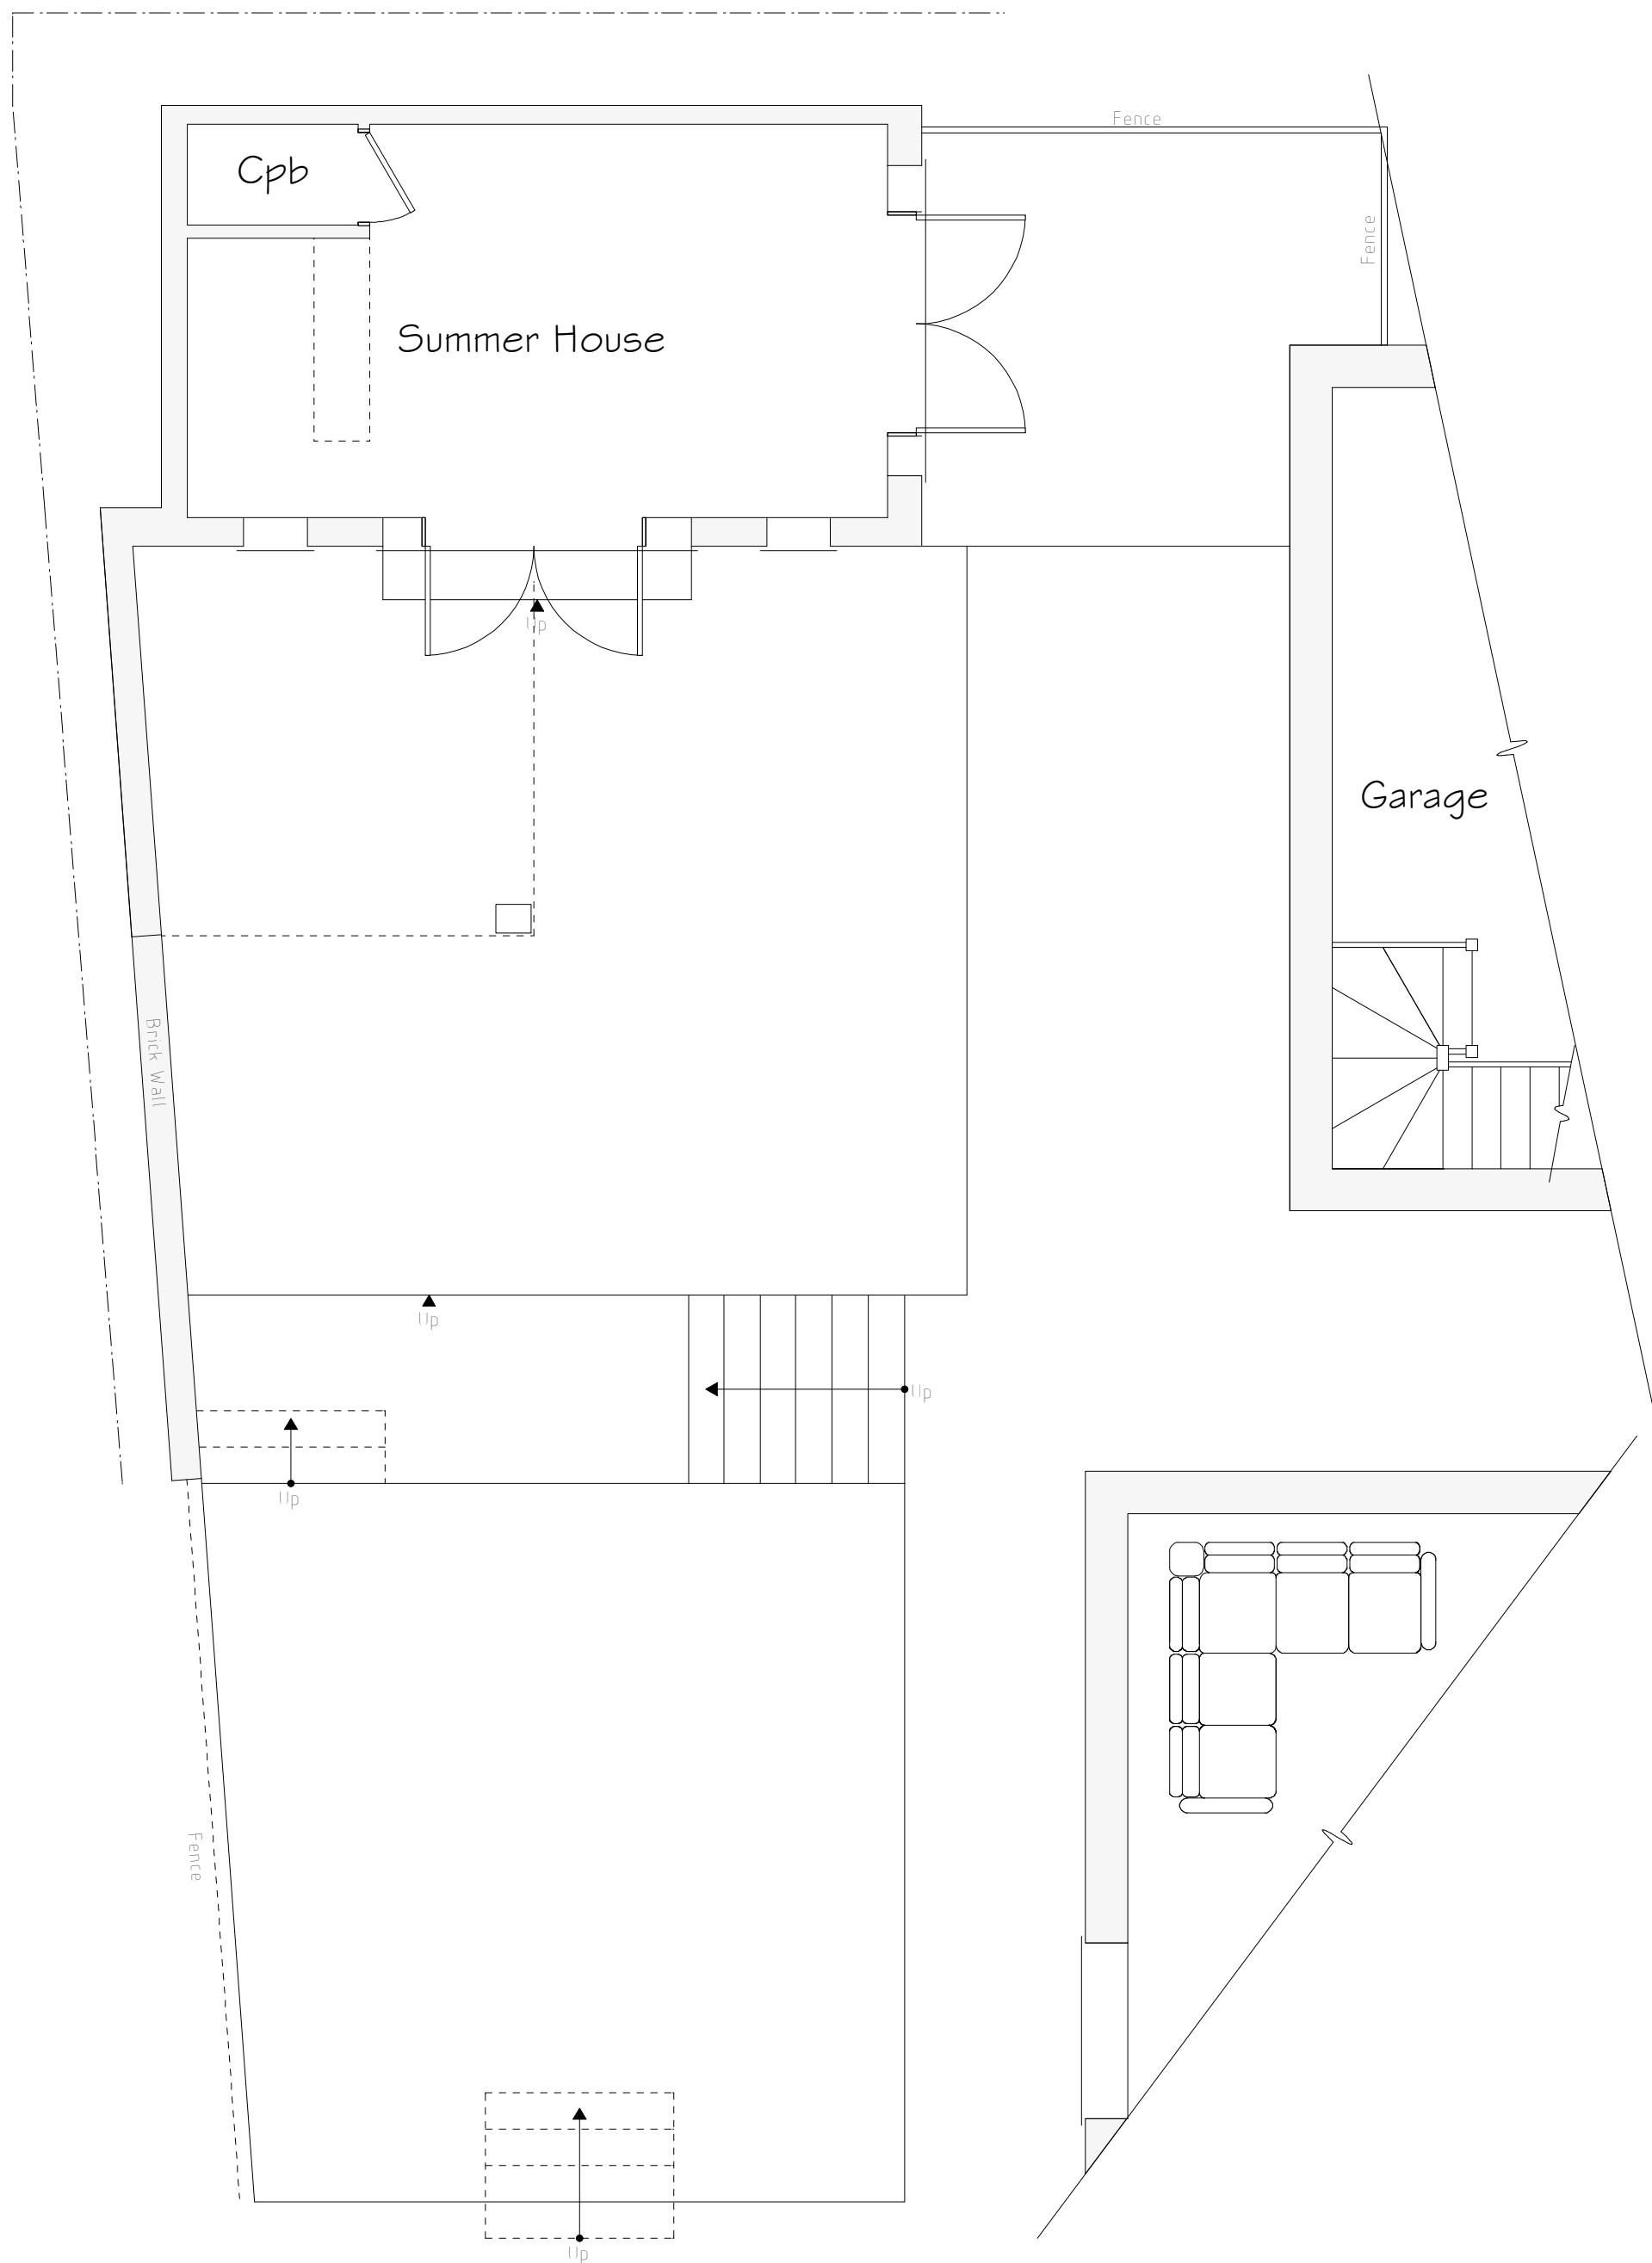


Front Elevation 1:100

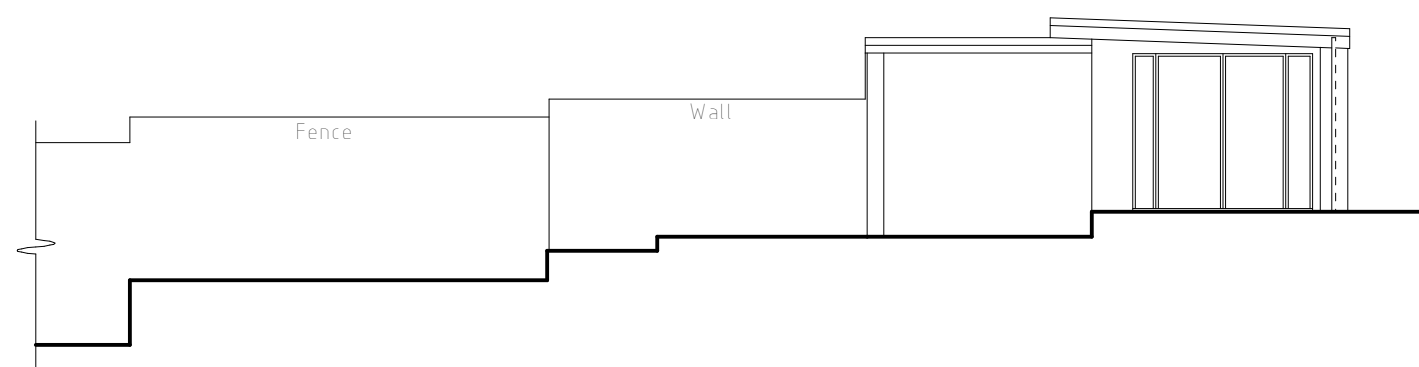

Side Elevation 1:100

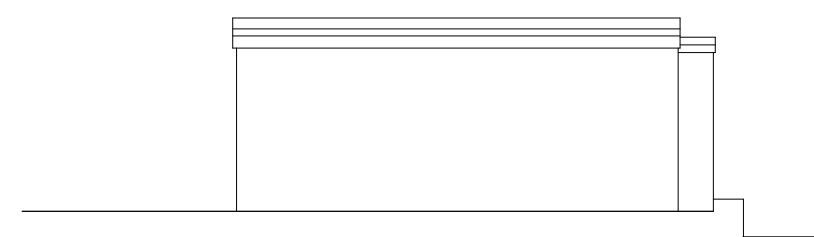

Rear Elevation 1:100

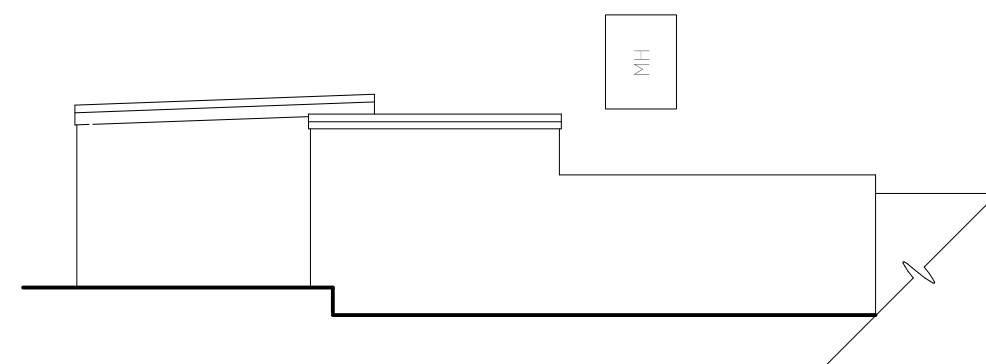

Side Elevation 1:100

Ground Floor Plan 1:50

Rev	Date	Detail	Initial

Project:	
Proposed Alterations to, 33 Moss Hill, Moss, Wrexham, LL11 6ES	
Title:	Scale: (A2)
As Built	1:50 & 1:100

Drawn By:	Date:
A.Valentine	July 2023
Drawing No:	Sheet:
J186/001	1 of 1

blueprint
architectural services

LABC partner

Office 3K4,
Redwither Business Tower,
Wrexham. LL13 9XT
Tel: 01978 356500
www.blueprintarchitectural.com

© copyright all rights reserved