
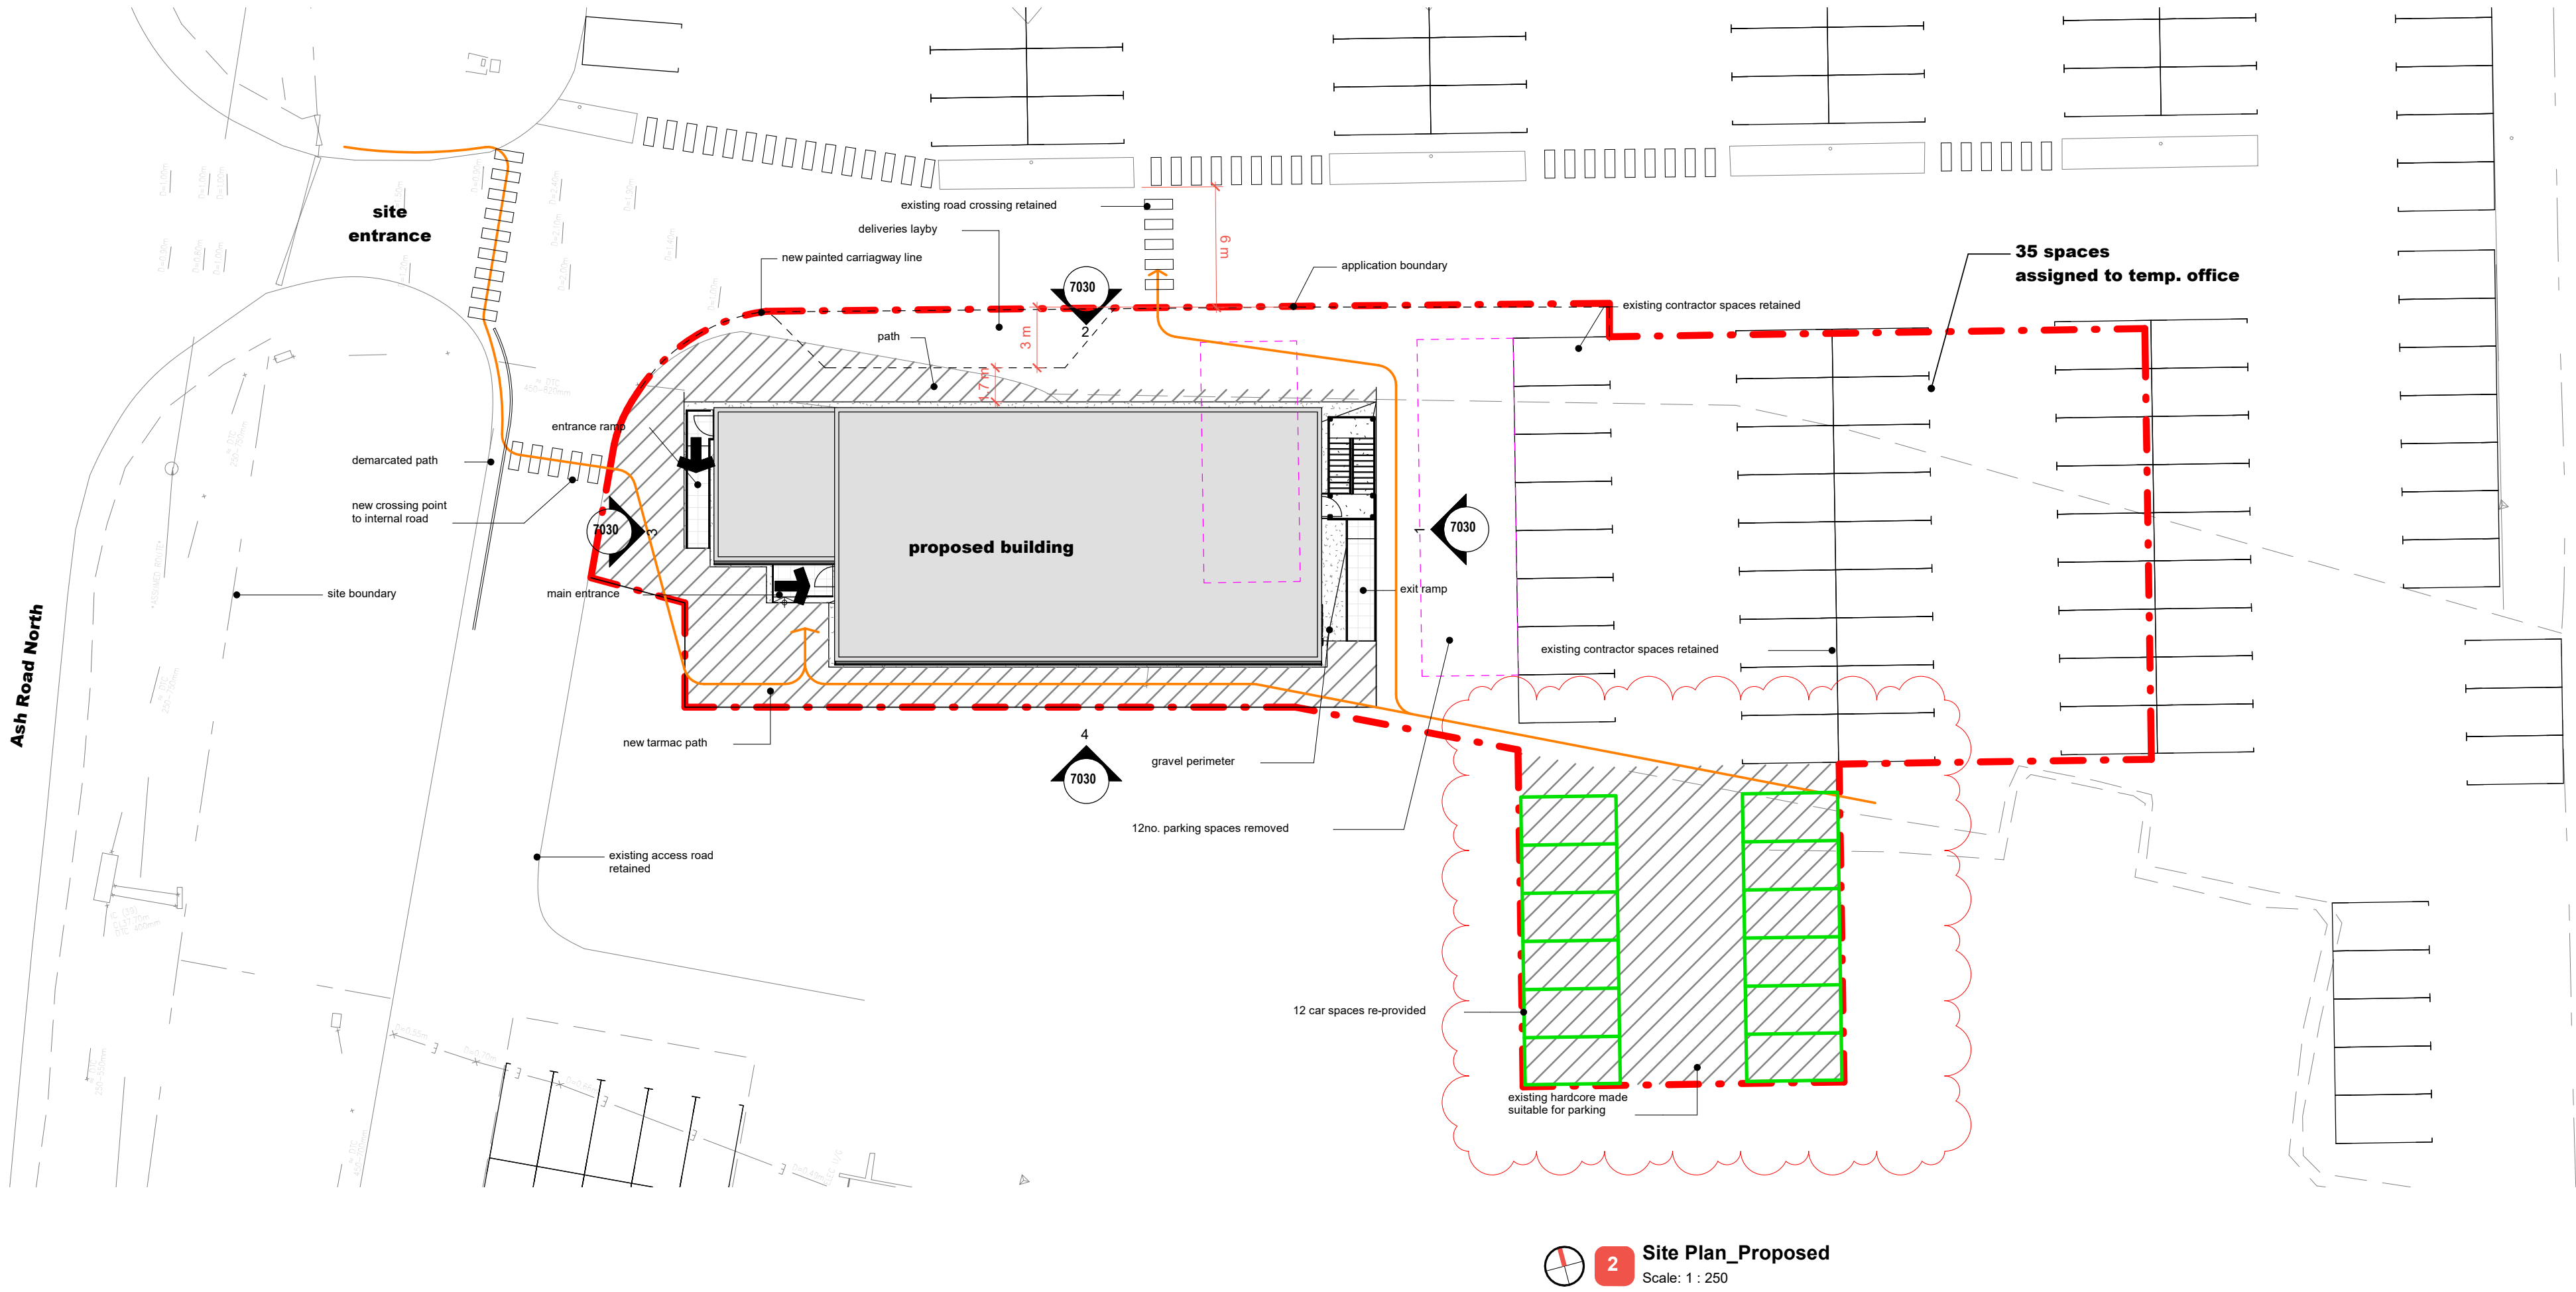


Notes

Figured dimensions are to be used in all cases.
Dimensions should not be scaled from drawing.
All existing dimensions should be checked on site before commencement of the work.
Any discrepancies in dimensions should be clarified with the Architect prior to commencement of the work.
No deviation from this drawing will be permitted without the prior written consent of the Architect.
This drawing is to be read in conjunction with all the relevant Mechanical and Electrical drawings.
This drawing is to be read in conjunction with the relevant Structural Engineer's drawings, structural calculations and recommendations.
This drawing is to be read in conjunction with the relevant Fire Safety Strategy drawings.
This drawing is copyright and to be returned to the architect on completion of the contract.

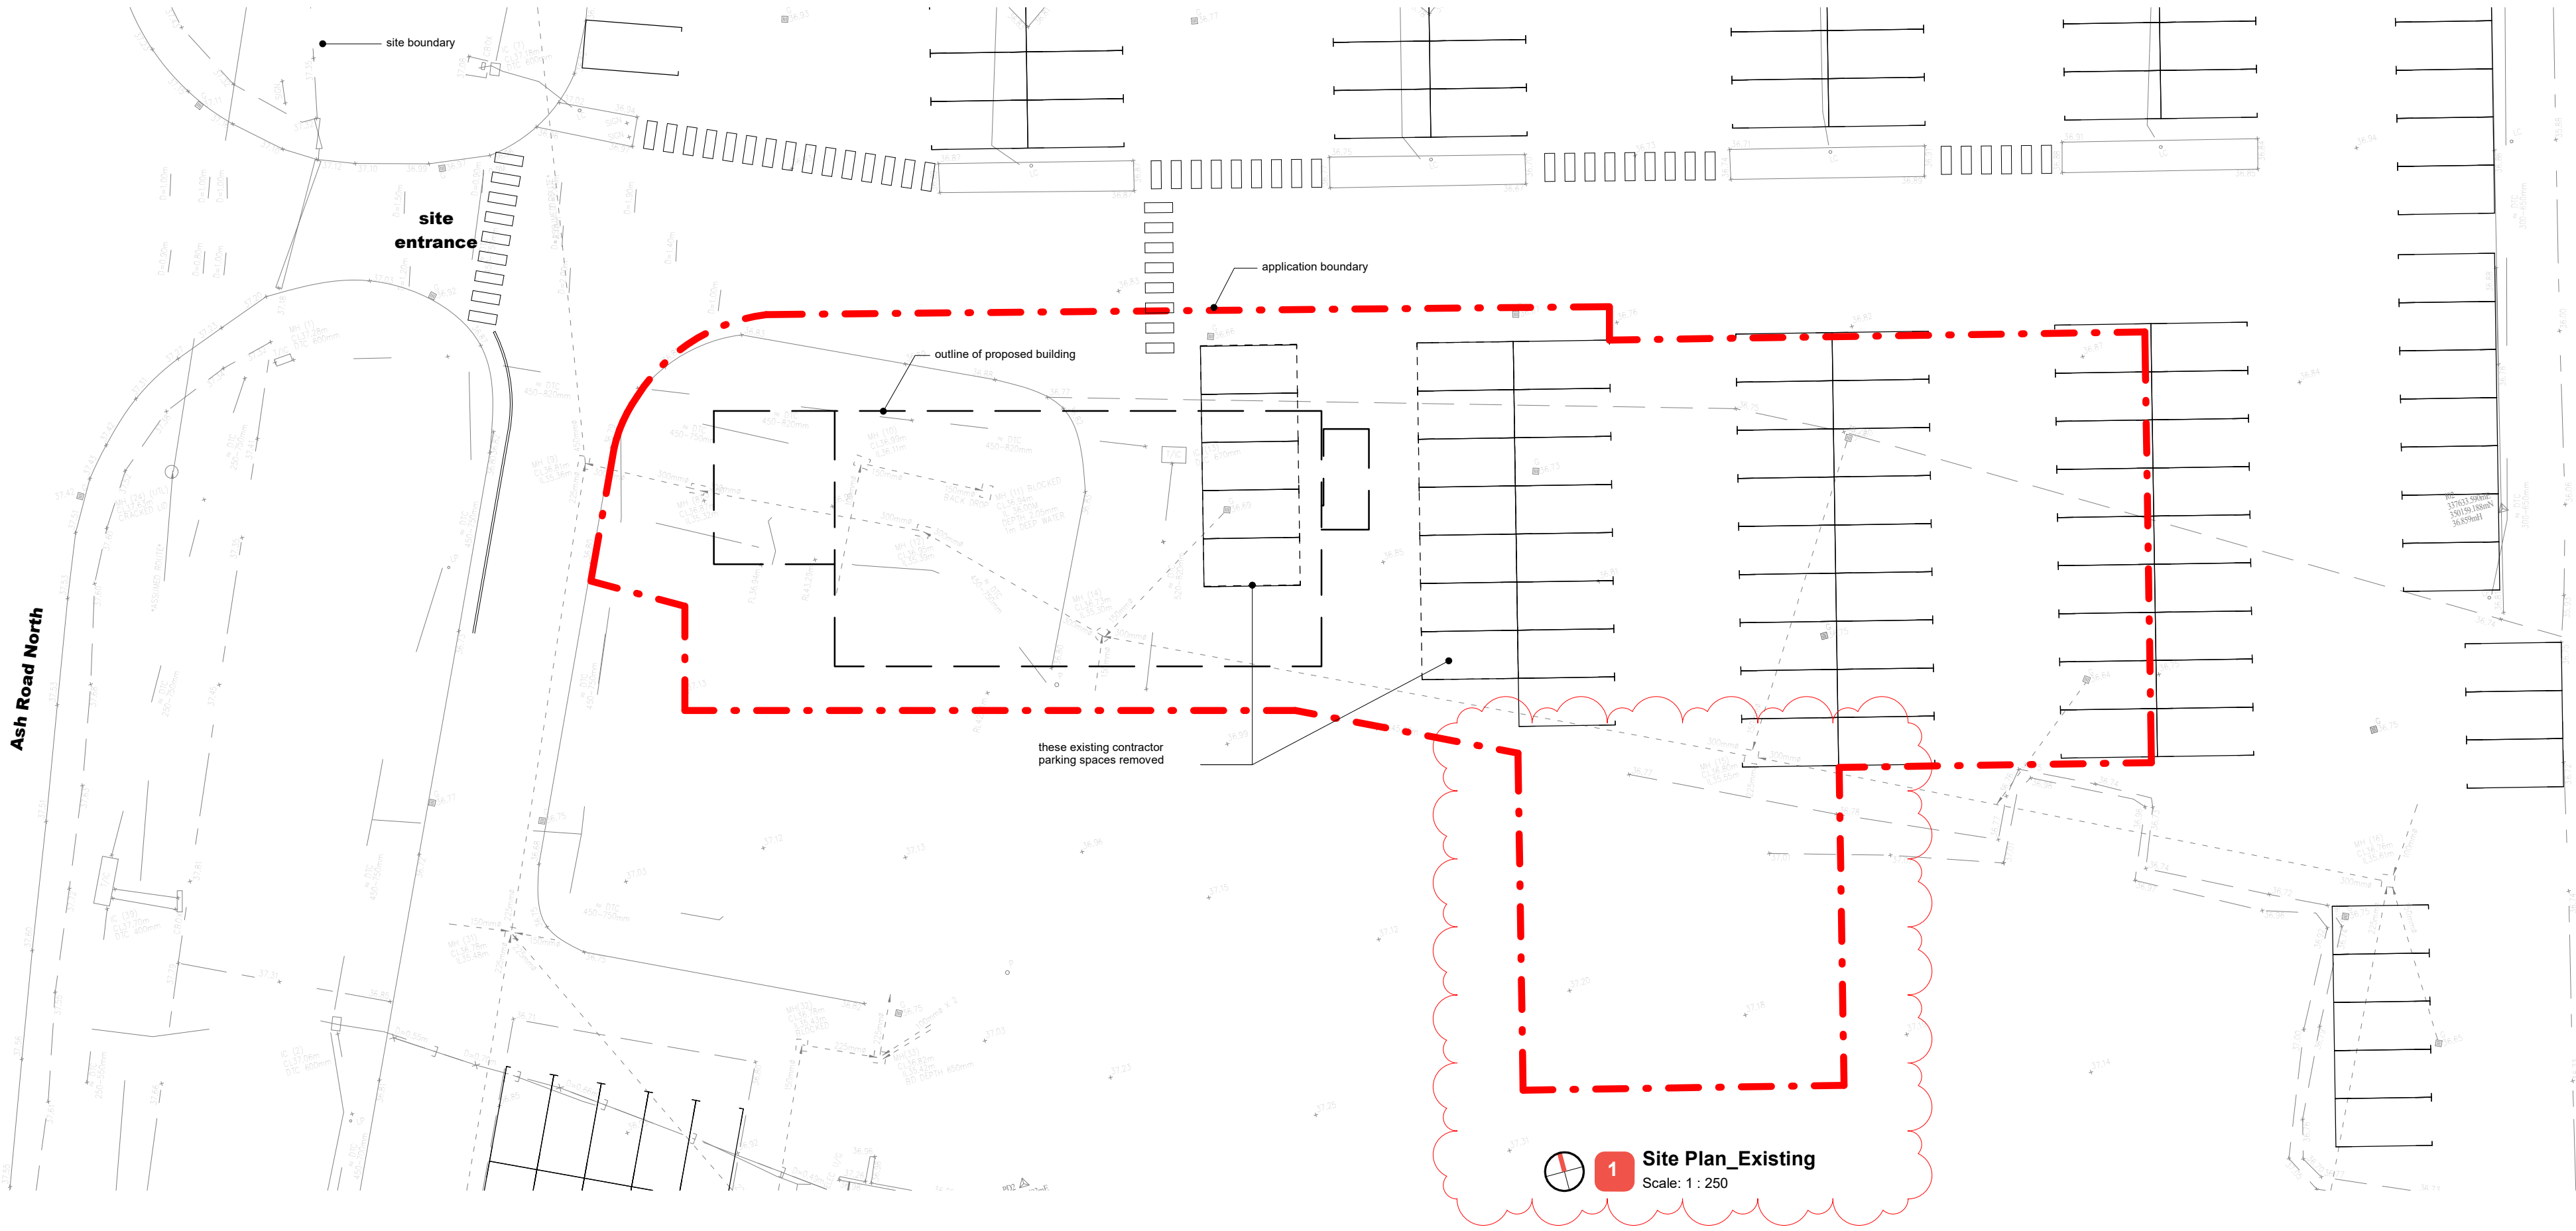

P6	redline boundary amended to include car spaces	EmR	CR	230002
P5	12 car spaces re-provided	EmR	CR	230031
P4	updated building location, northpoint amended	EmR	CR	230020
P3	updated building location	EmR	CR	230020
P2	updated building location	EmR	-	230020
P1	First Issue of Drawing- Issued for Planning	EmR	CR	230023
Rev.	Revision description	Drawn	Checked	Date

Lovelock Mitchell Architects
3 Stanley Street, Chester, CH1 2LS
Tel: +44 (0) 1244 404321
e-mail: admin@lovelockmitchell.com
web: www.lovelockmitchell.com

Project
Ipsen Temporary Offices
Wrexham

Title
Site Plans

LMA Project	Drawing number							Rev.
	Project	Original	Zone	Level	Size	Area	Overseer/Author	
2261	ITO	LMA	XX	XX	DR	A	7010	P6