




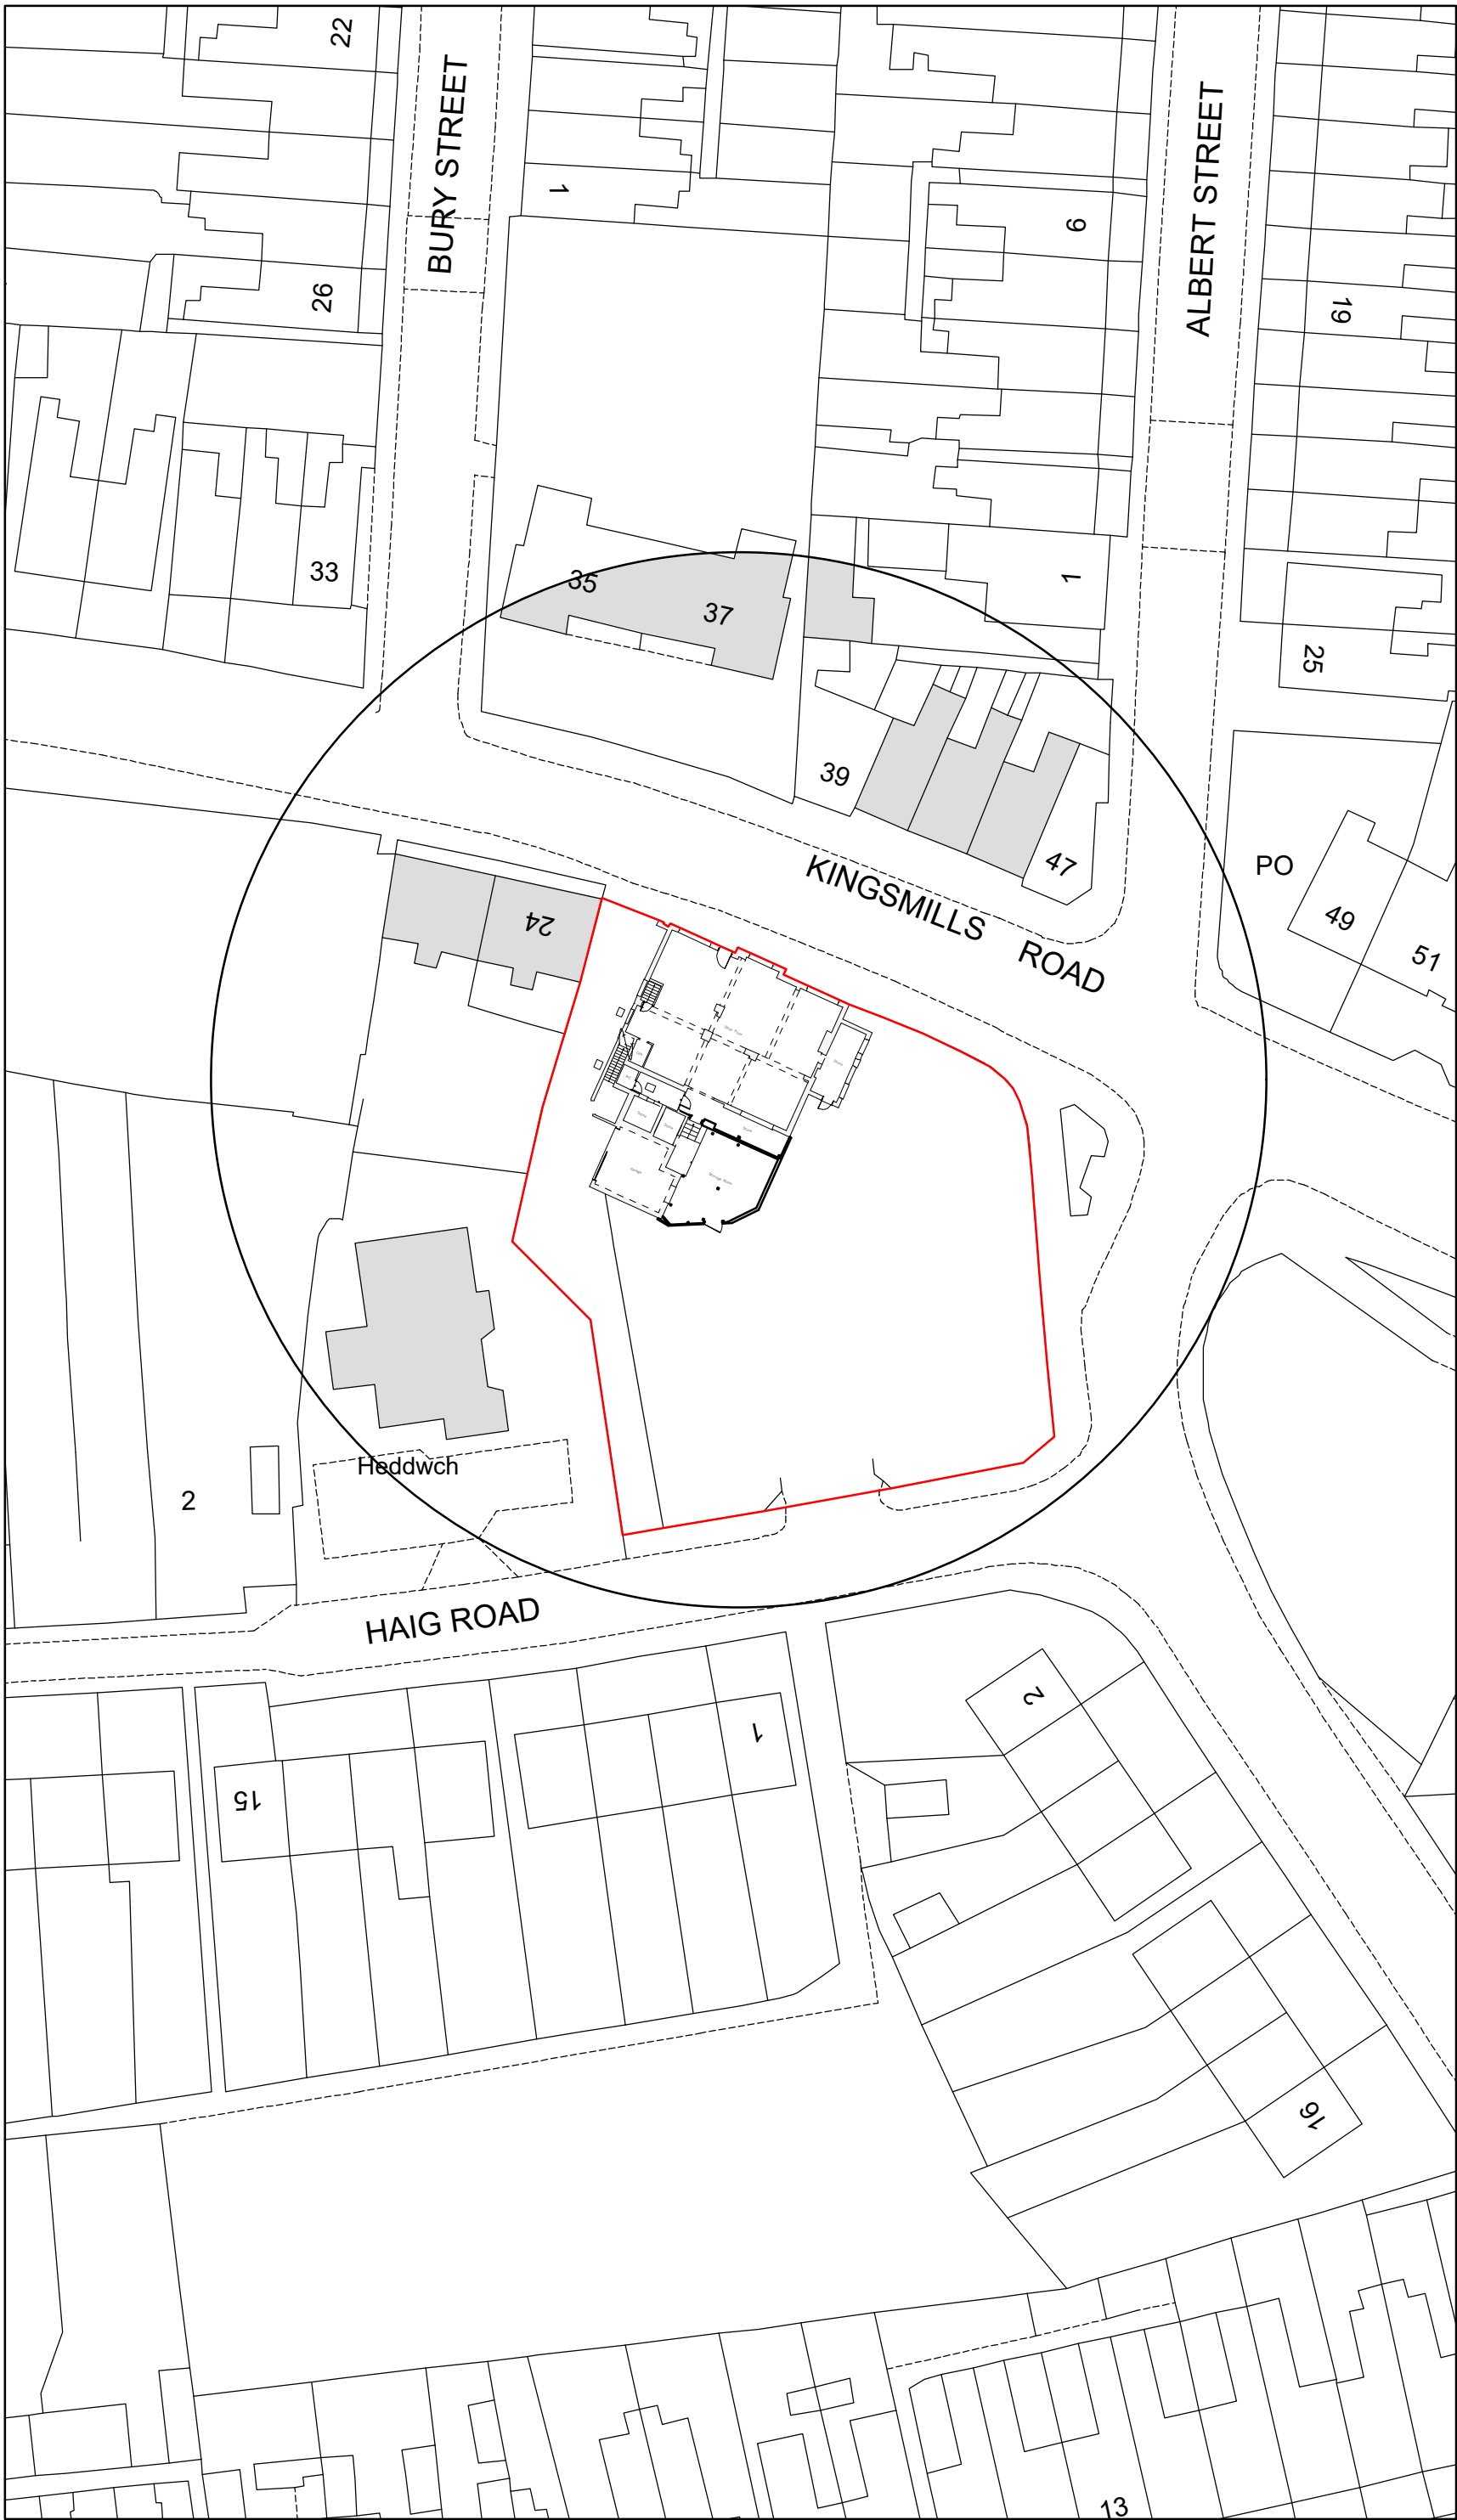

Site Plan 1:500

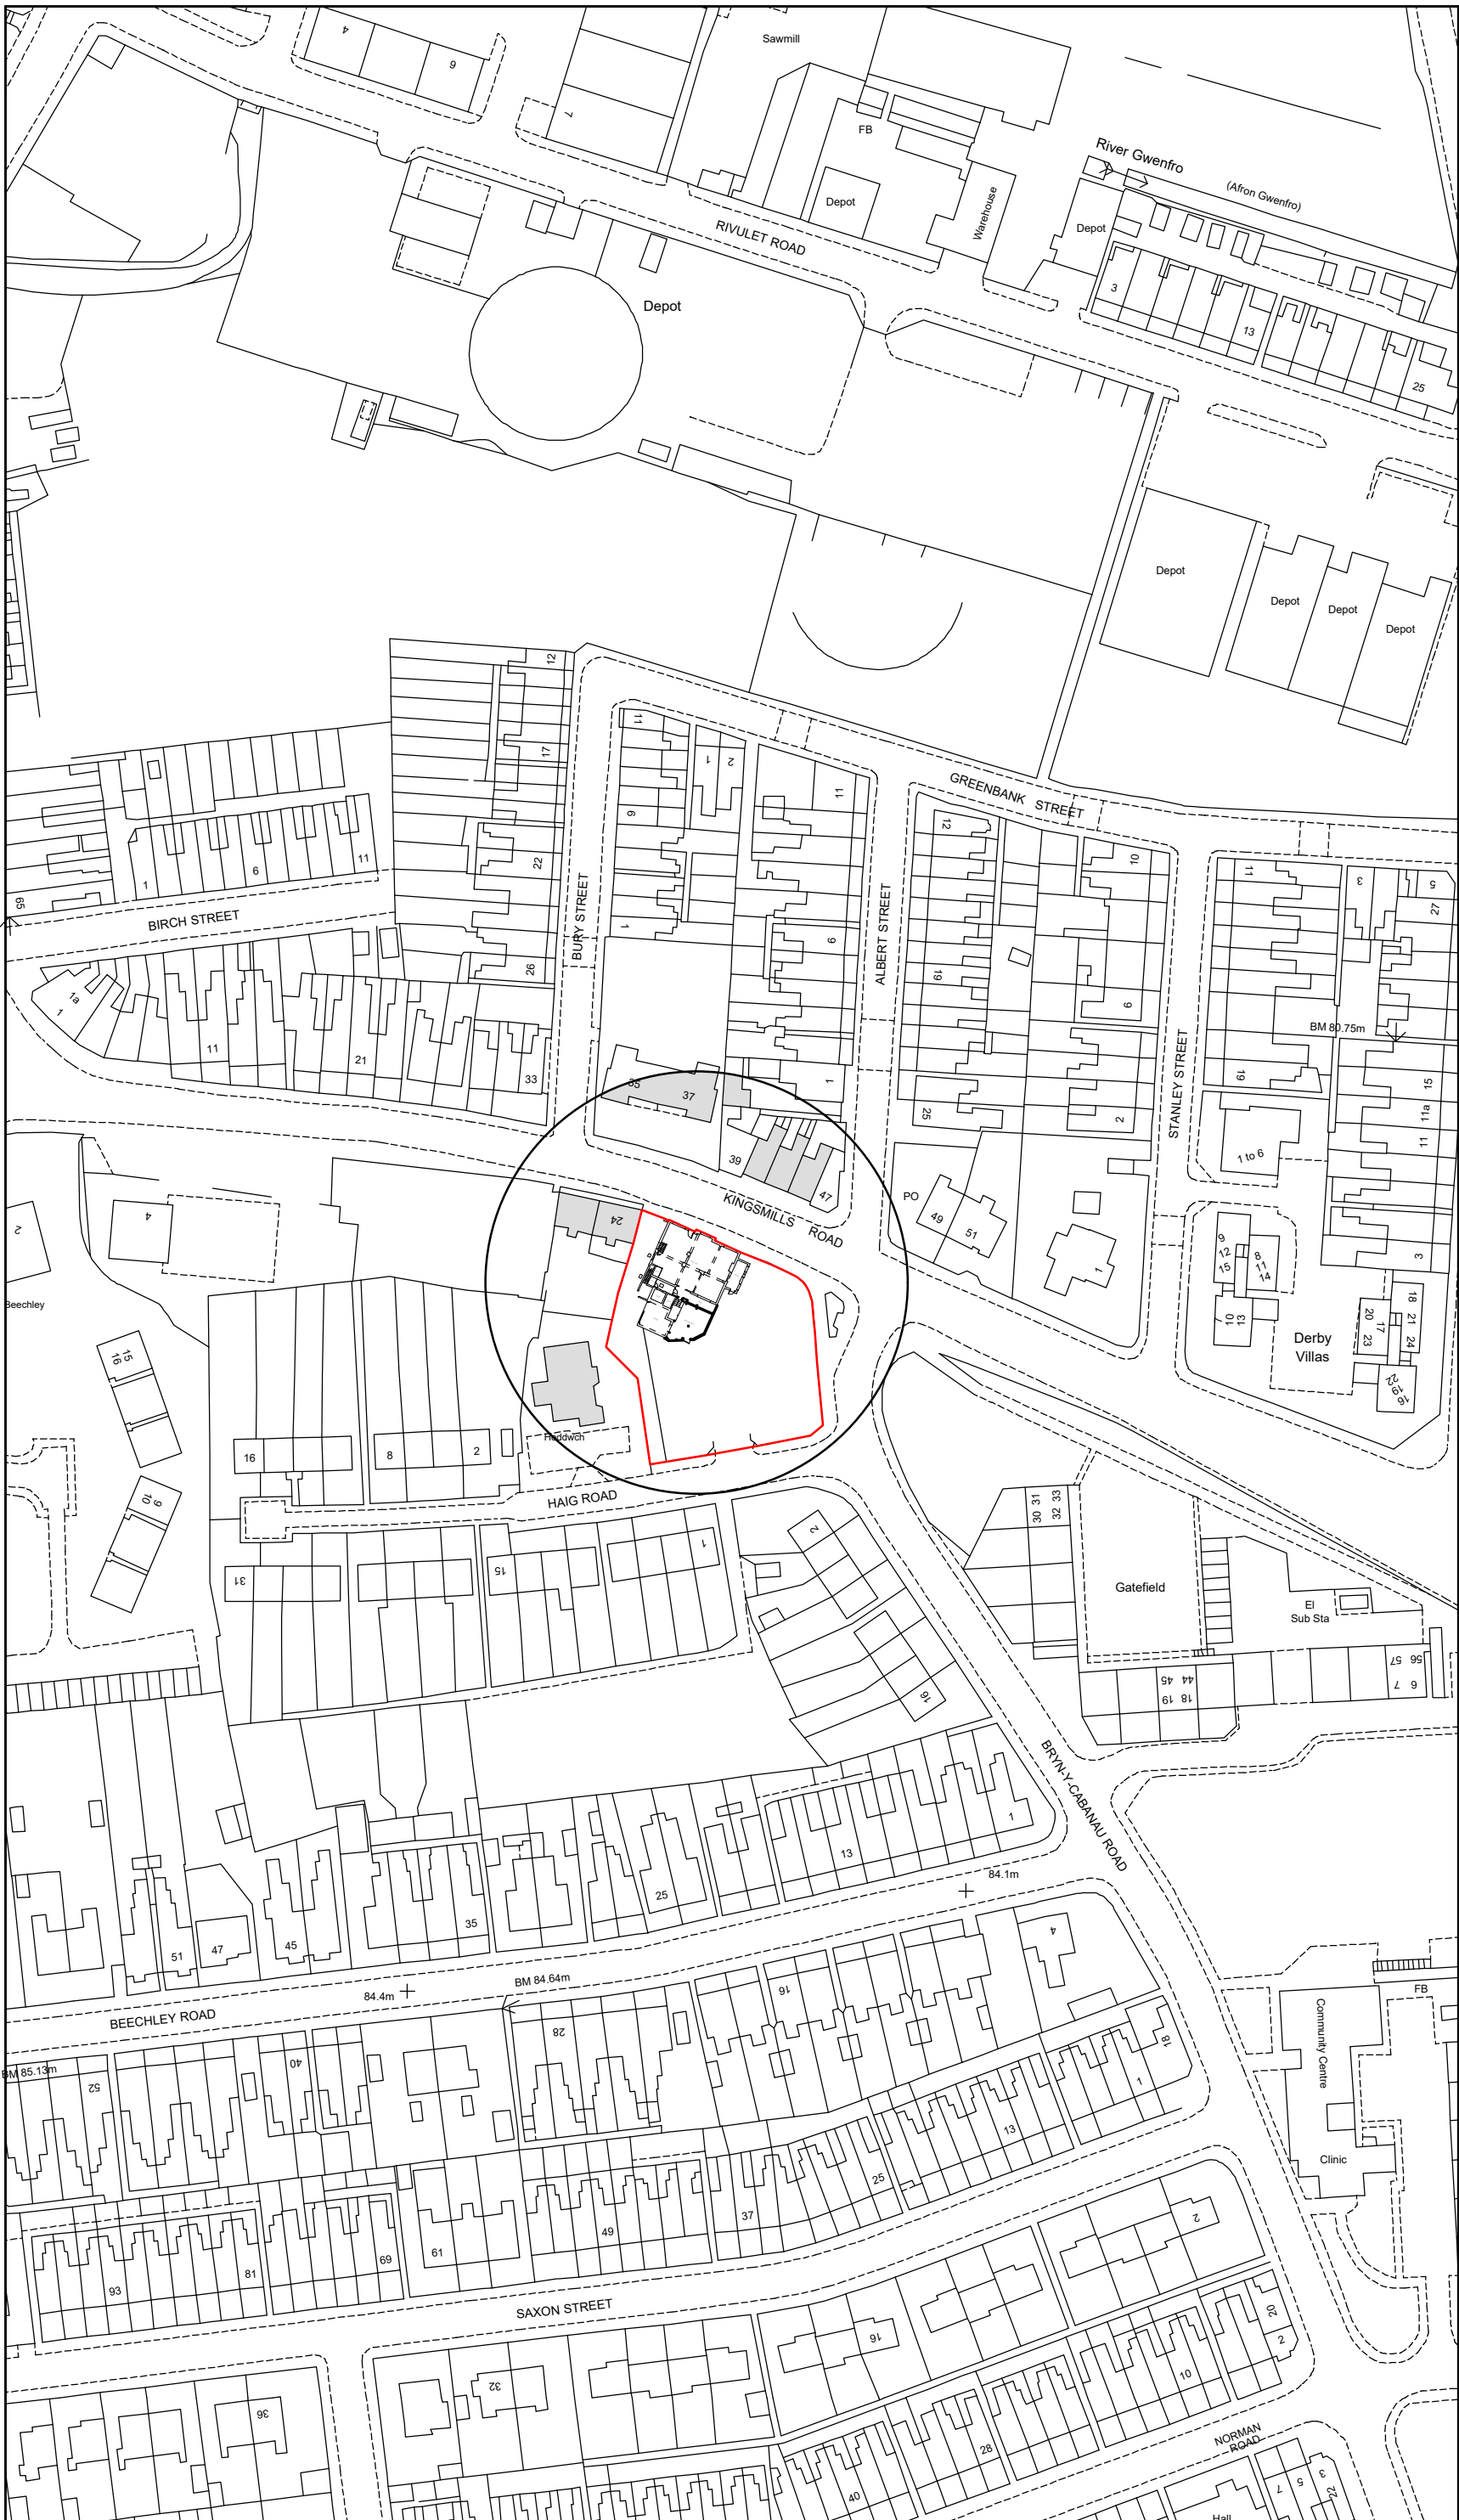

Location Plan 1:1250

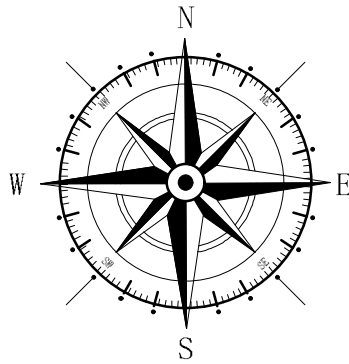

Key	
	Surrounding Buildings
	Application Site

Rev	Date	Detail	Initial

Project:
Proposed Alterations to,
Travellers Rest,
Kings Mill Road,
Wrexham, LL13 8NH

Title:
As Built:Site &
Location Plan

Scale: (A2)
1:500 &
1:1250

Drawn By:
E.M.Jackson

Date:
April 2023

Drawing No:
B169/003

Sheet:
1 of 1

blueprint
architectural services



Office 3K4,
Redwither Business Tower,
Wrexham. LL13 9XT
Tel: 01978 356500
www.blueprintarchitectural.com

© copyright all rights reserved