

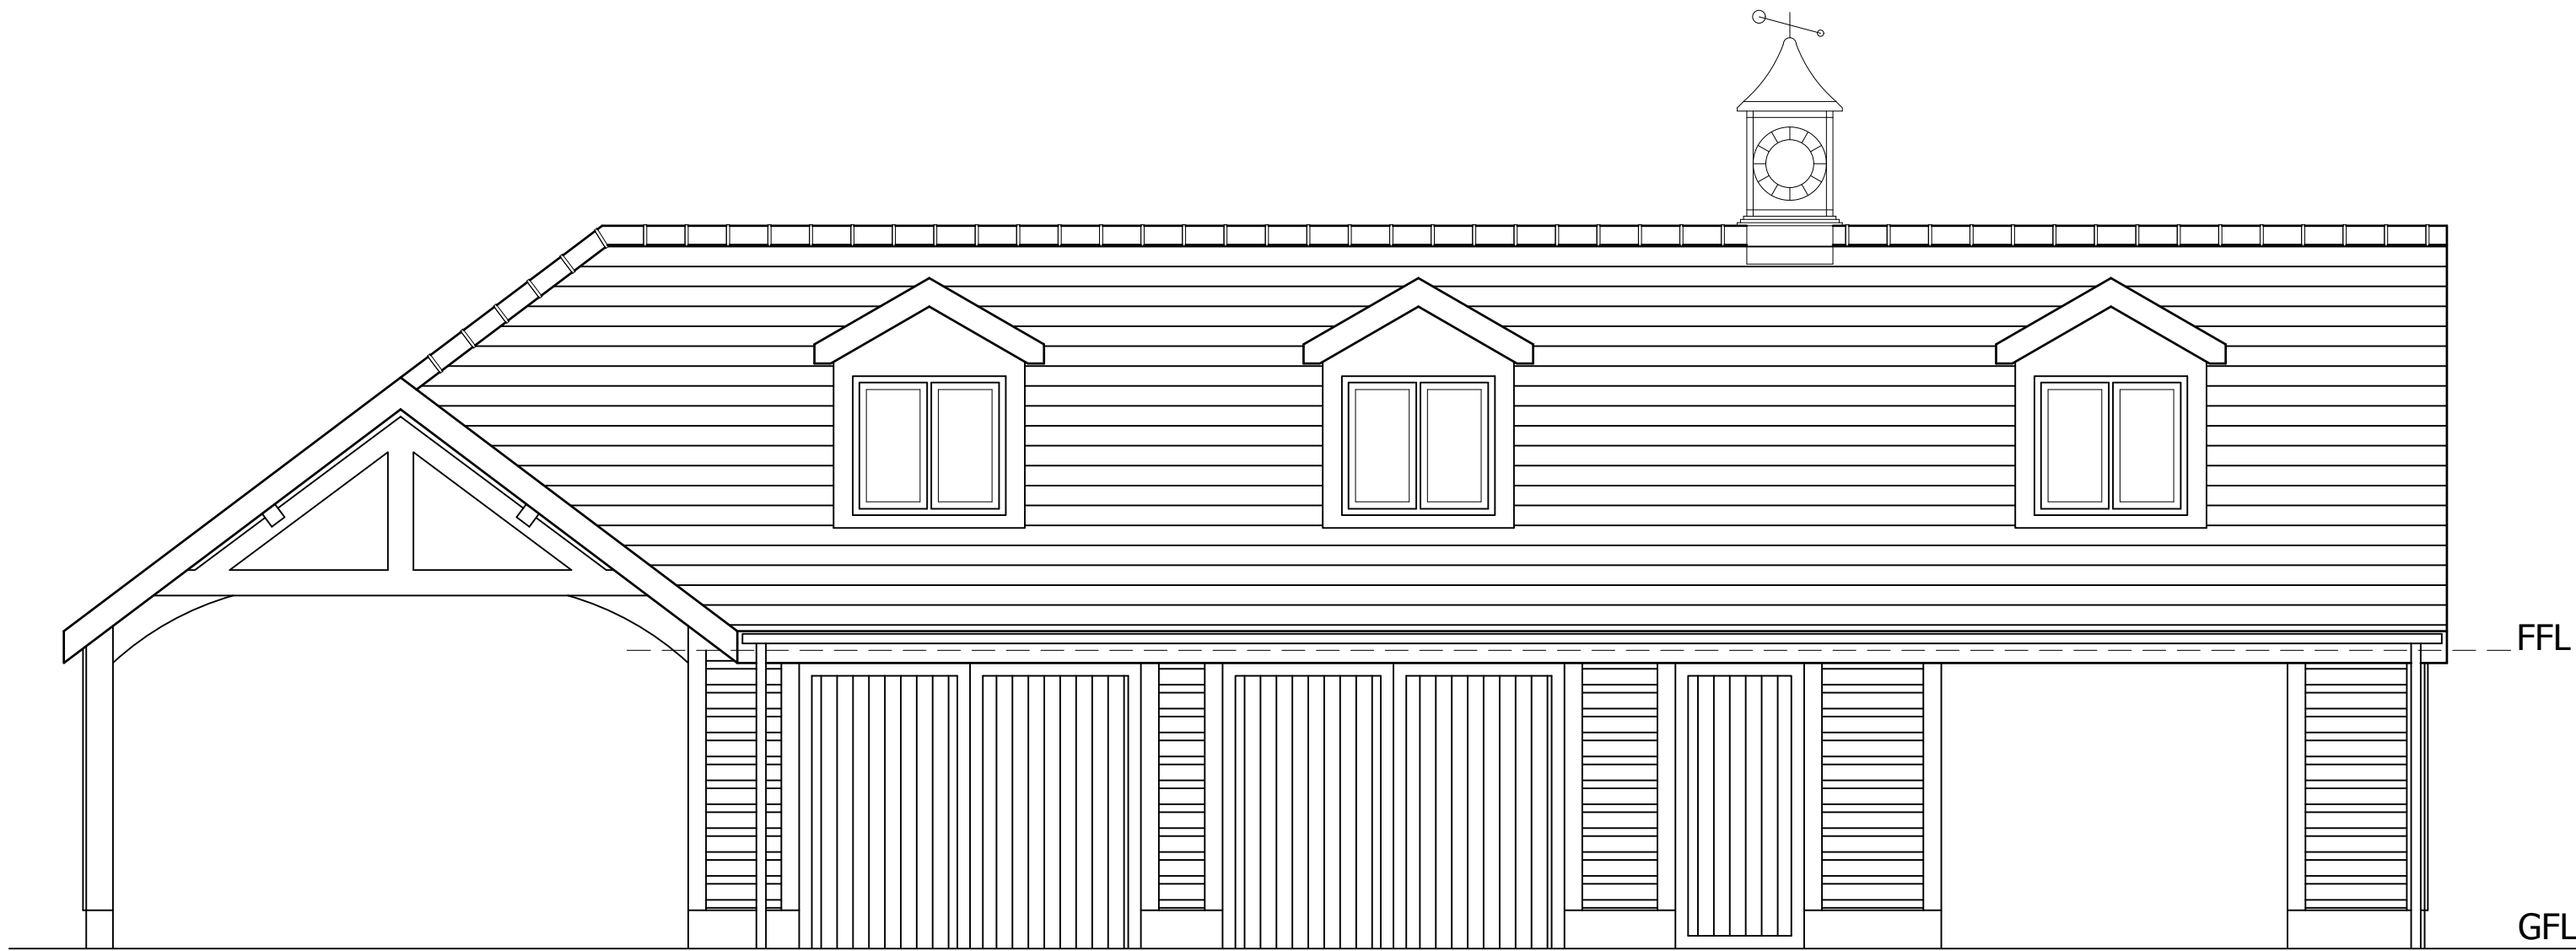




Note:
This drawing is copyright protected; do not scale off, all dimensions are to be checked on site by contractor. Contractor to report any discrepancies in dimensions, errors or omissions prior to commencing work. Portman Surveyors Ltd. take no responsibility for any unauthorised use of the information contained herein.

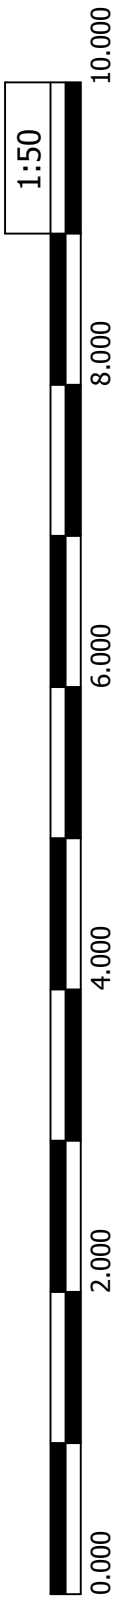


AS-BUILT
East Elevation

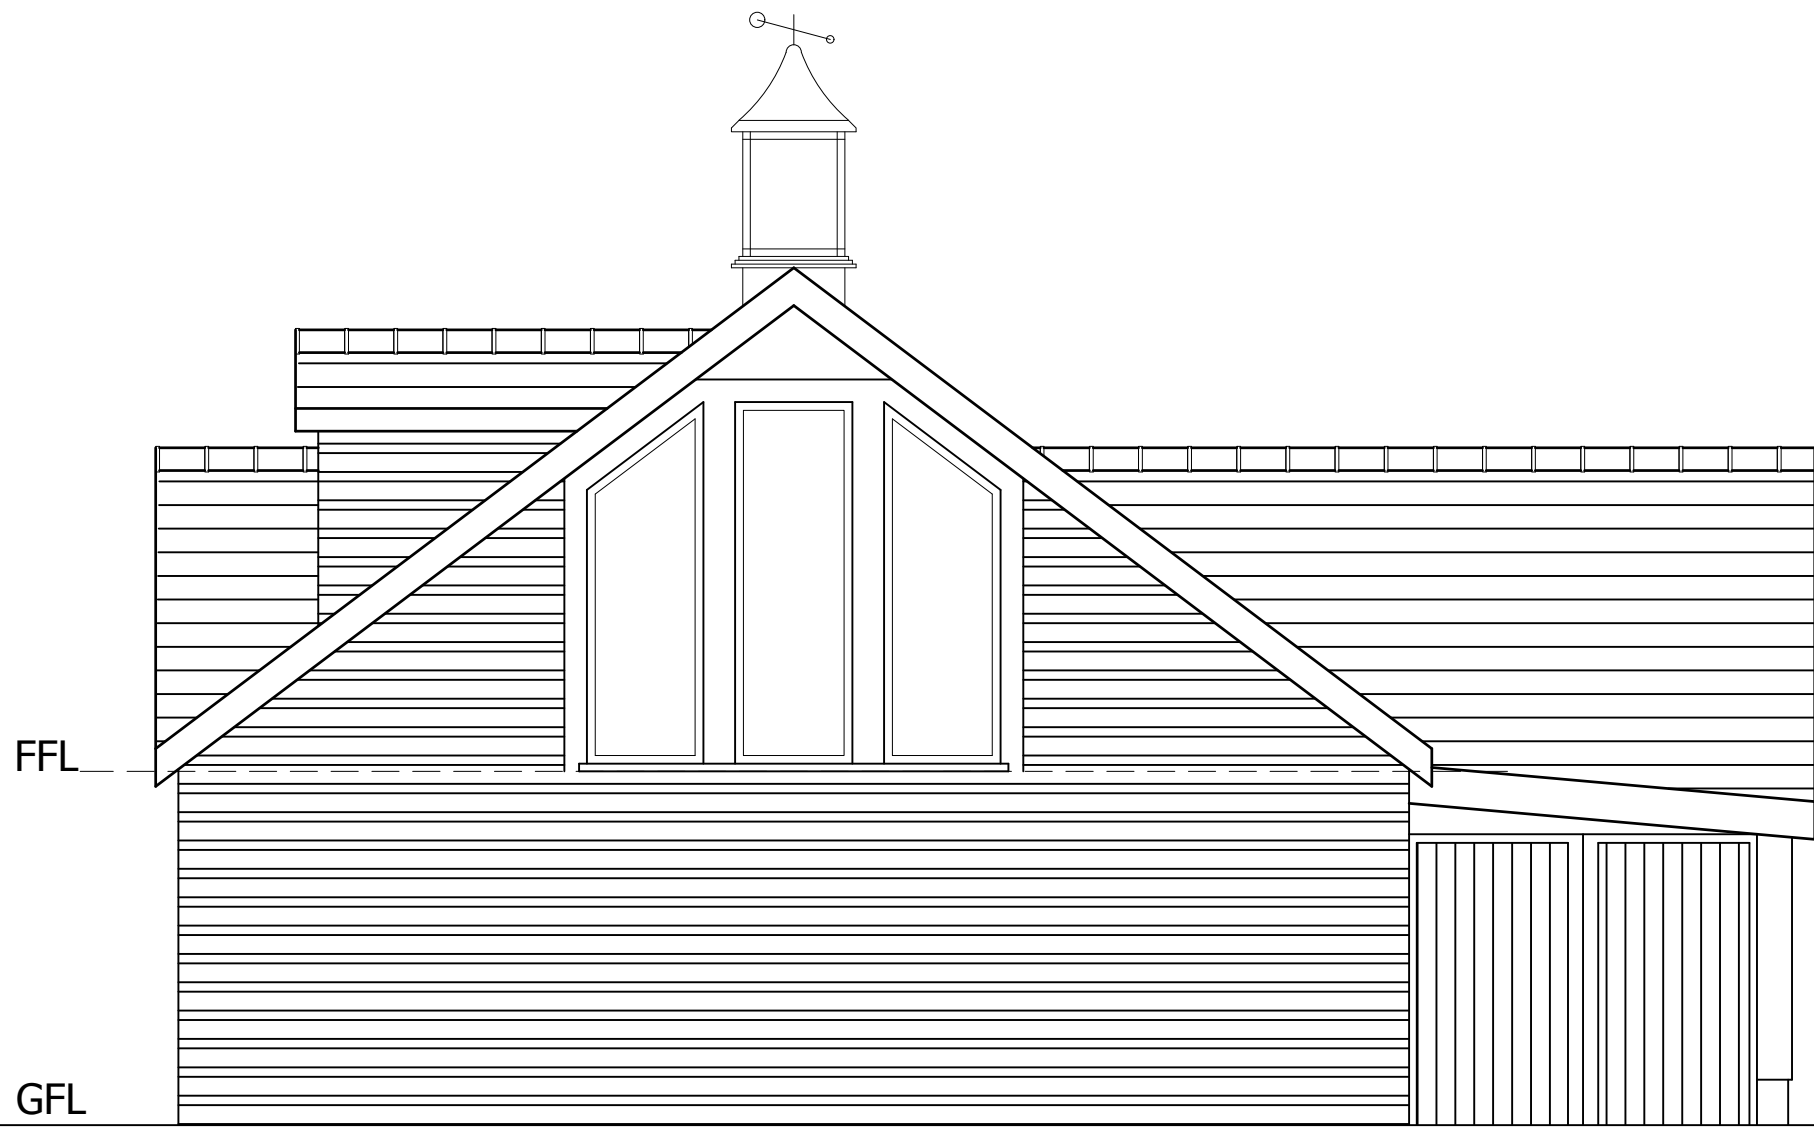

AS-BUILT
North Elevation

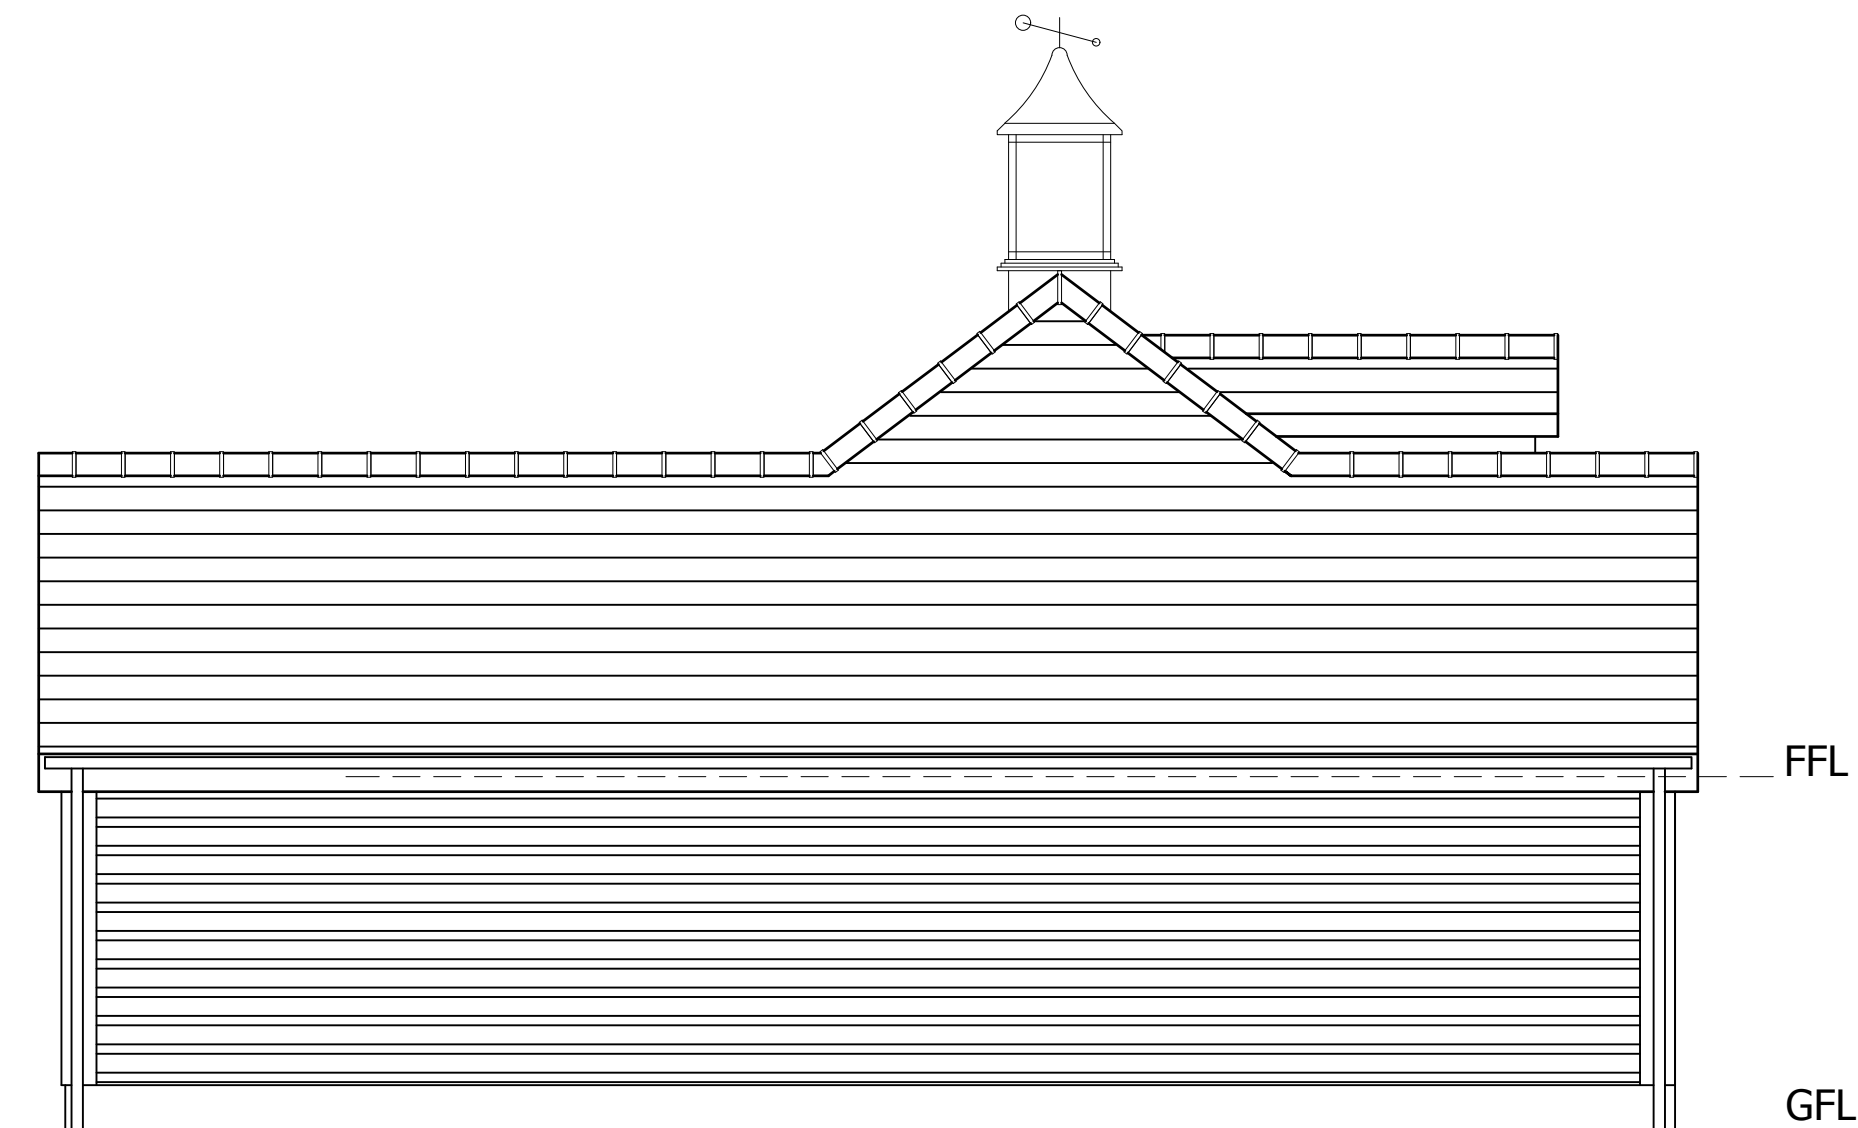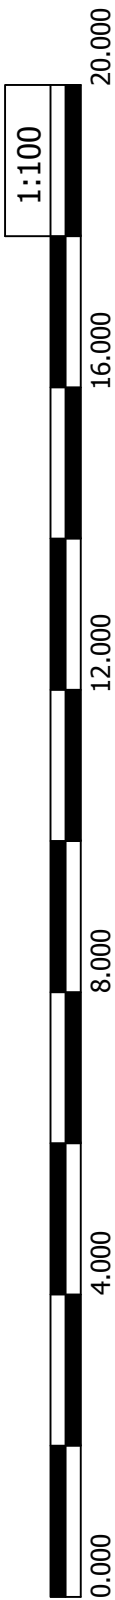

AS-BUILT
South Elevation

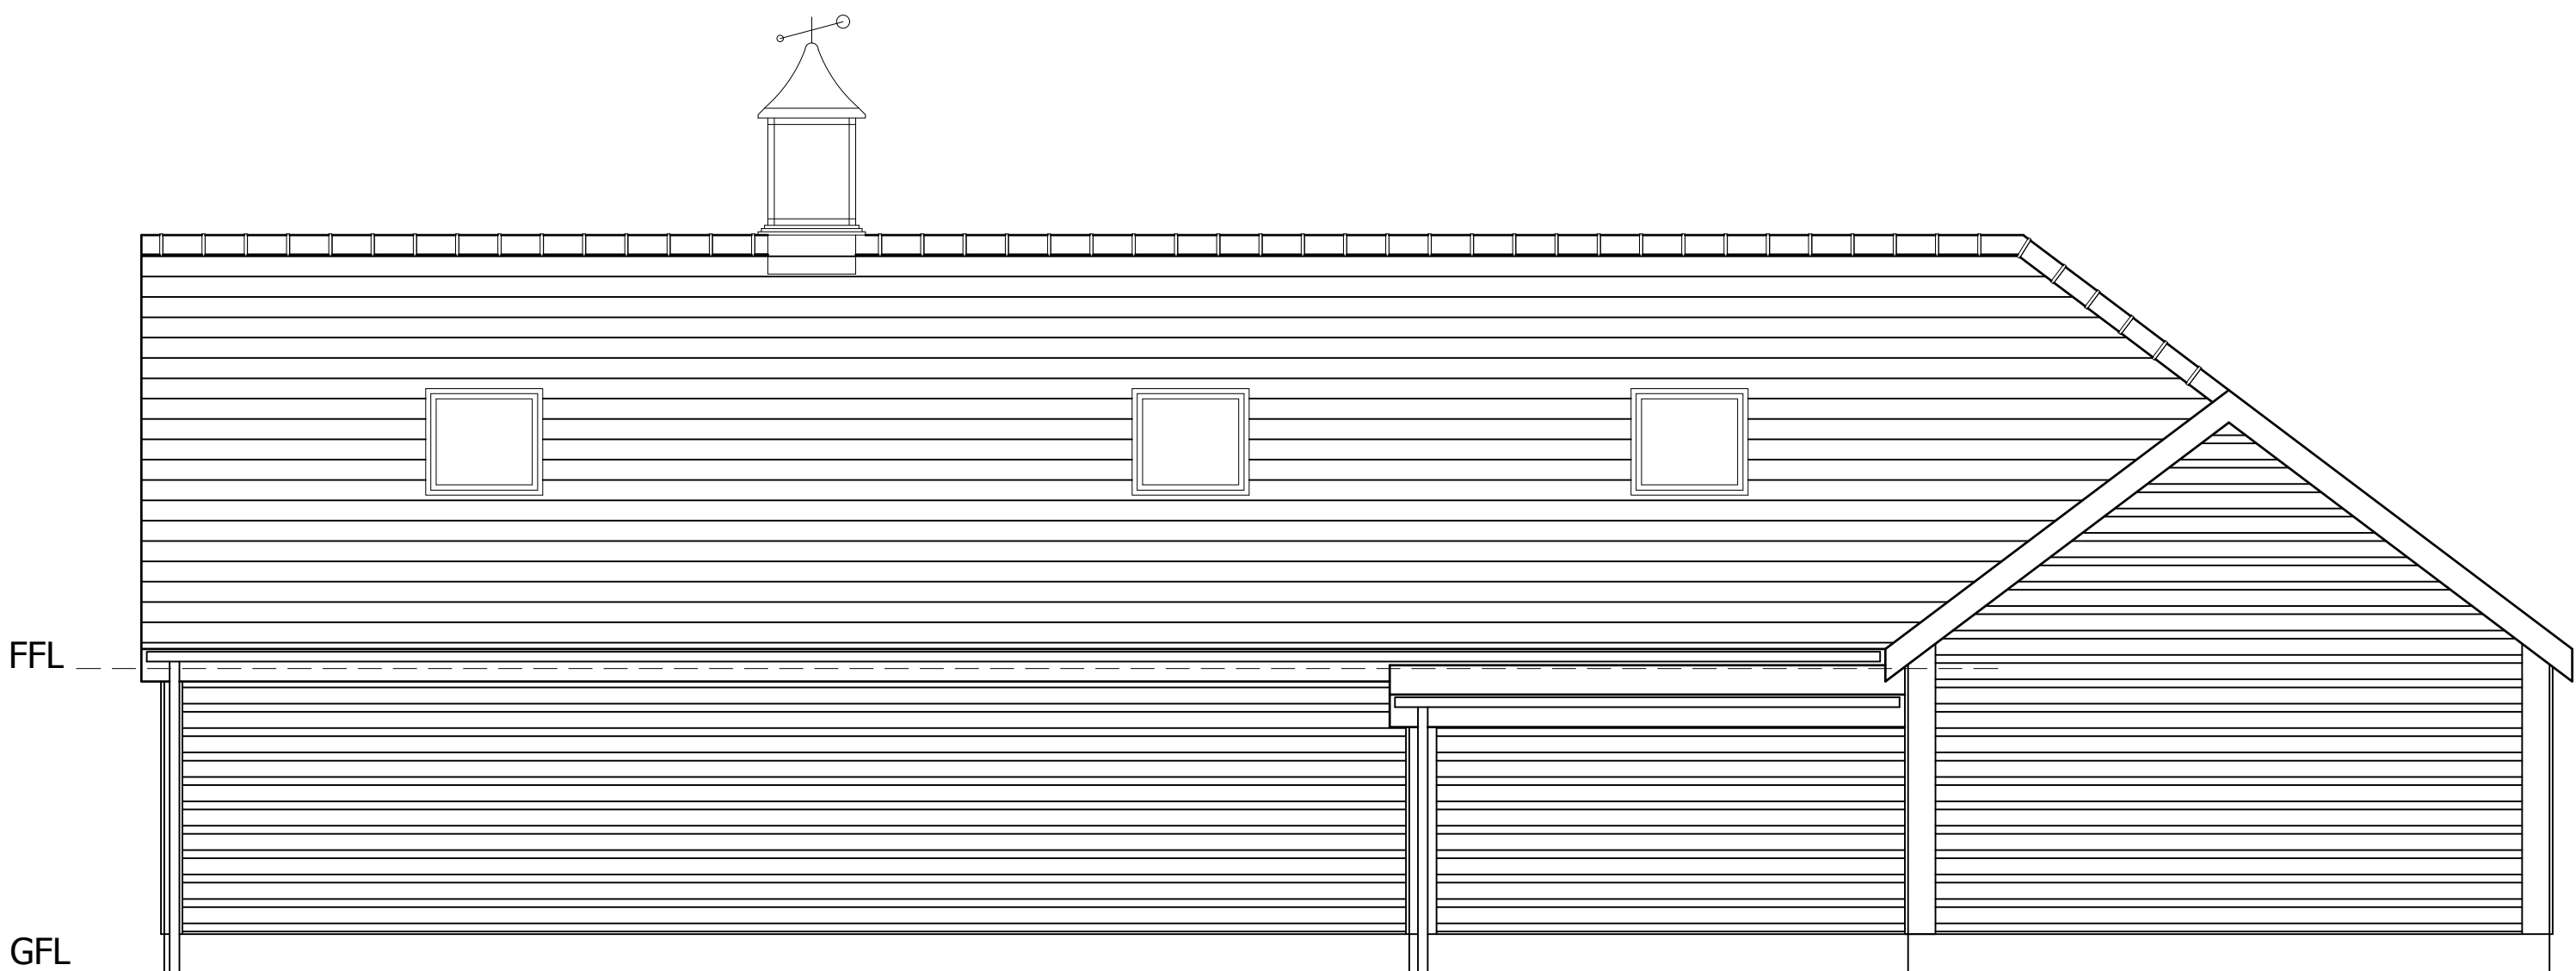

AS-BUILT
West Elevation

A	18.7.23	Clock face and weather vane added
Rev	Date	Comment

Portman Surveyors Ltd
Chartered Building Surveyors

The Studio
Tarpoley Business Centre
Nantwich Road
Tarpoley
Cheshire CW6 9UT
Tel/Fax: +44 (0)1829 732696
Mobile: +44 (0)7812 021070
e: rob.lee@portmansurveyors.com

Client:	Date:
Mr & Mrs M Wakefield	June 2023

Project:

Domestic Garage at
Higher Berse Road,
Wrexham. LL11 6PW

Drawing Title:	Scale:
AS-BUILT Elevations	1:50
	Status:
	Planning

Drawing No:	Rev:
A_374_04	A