


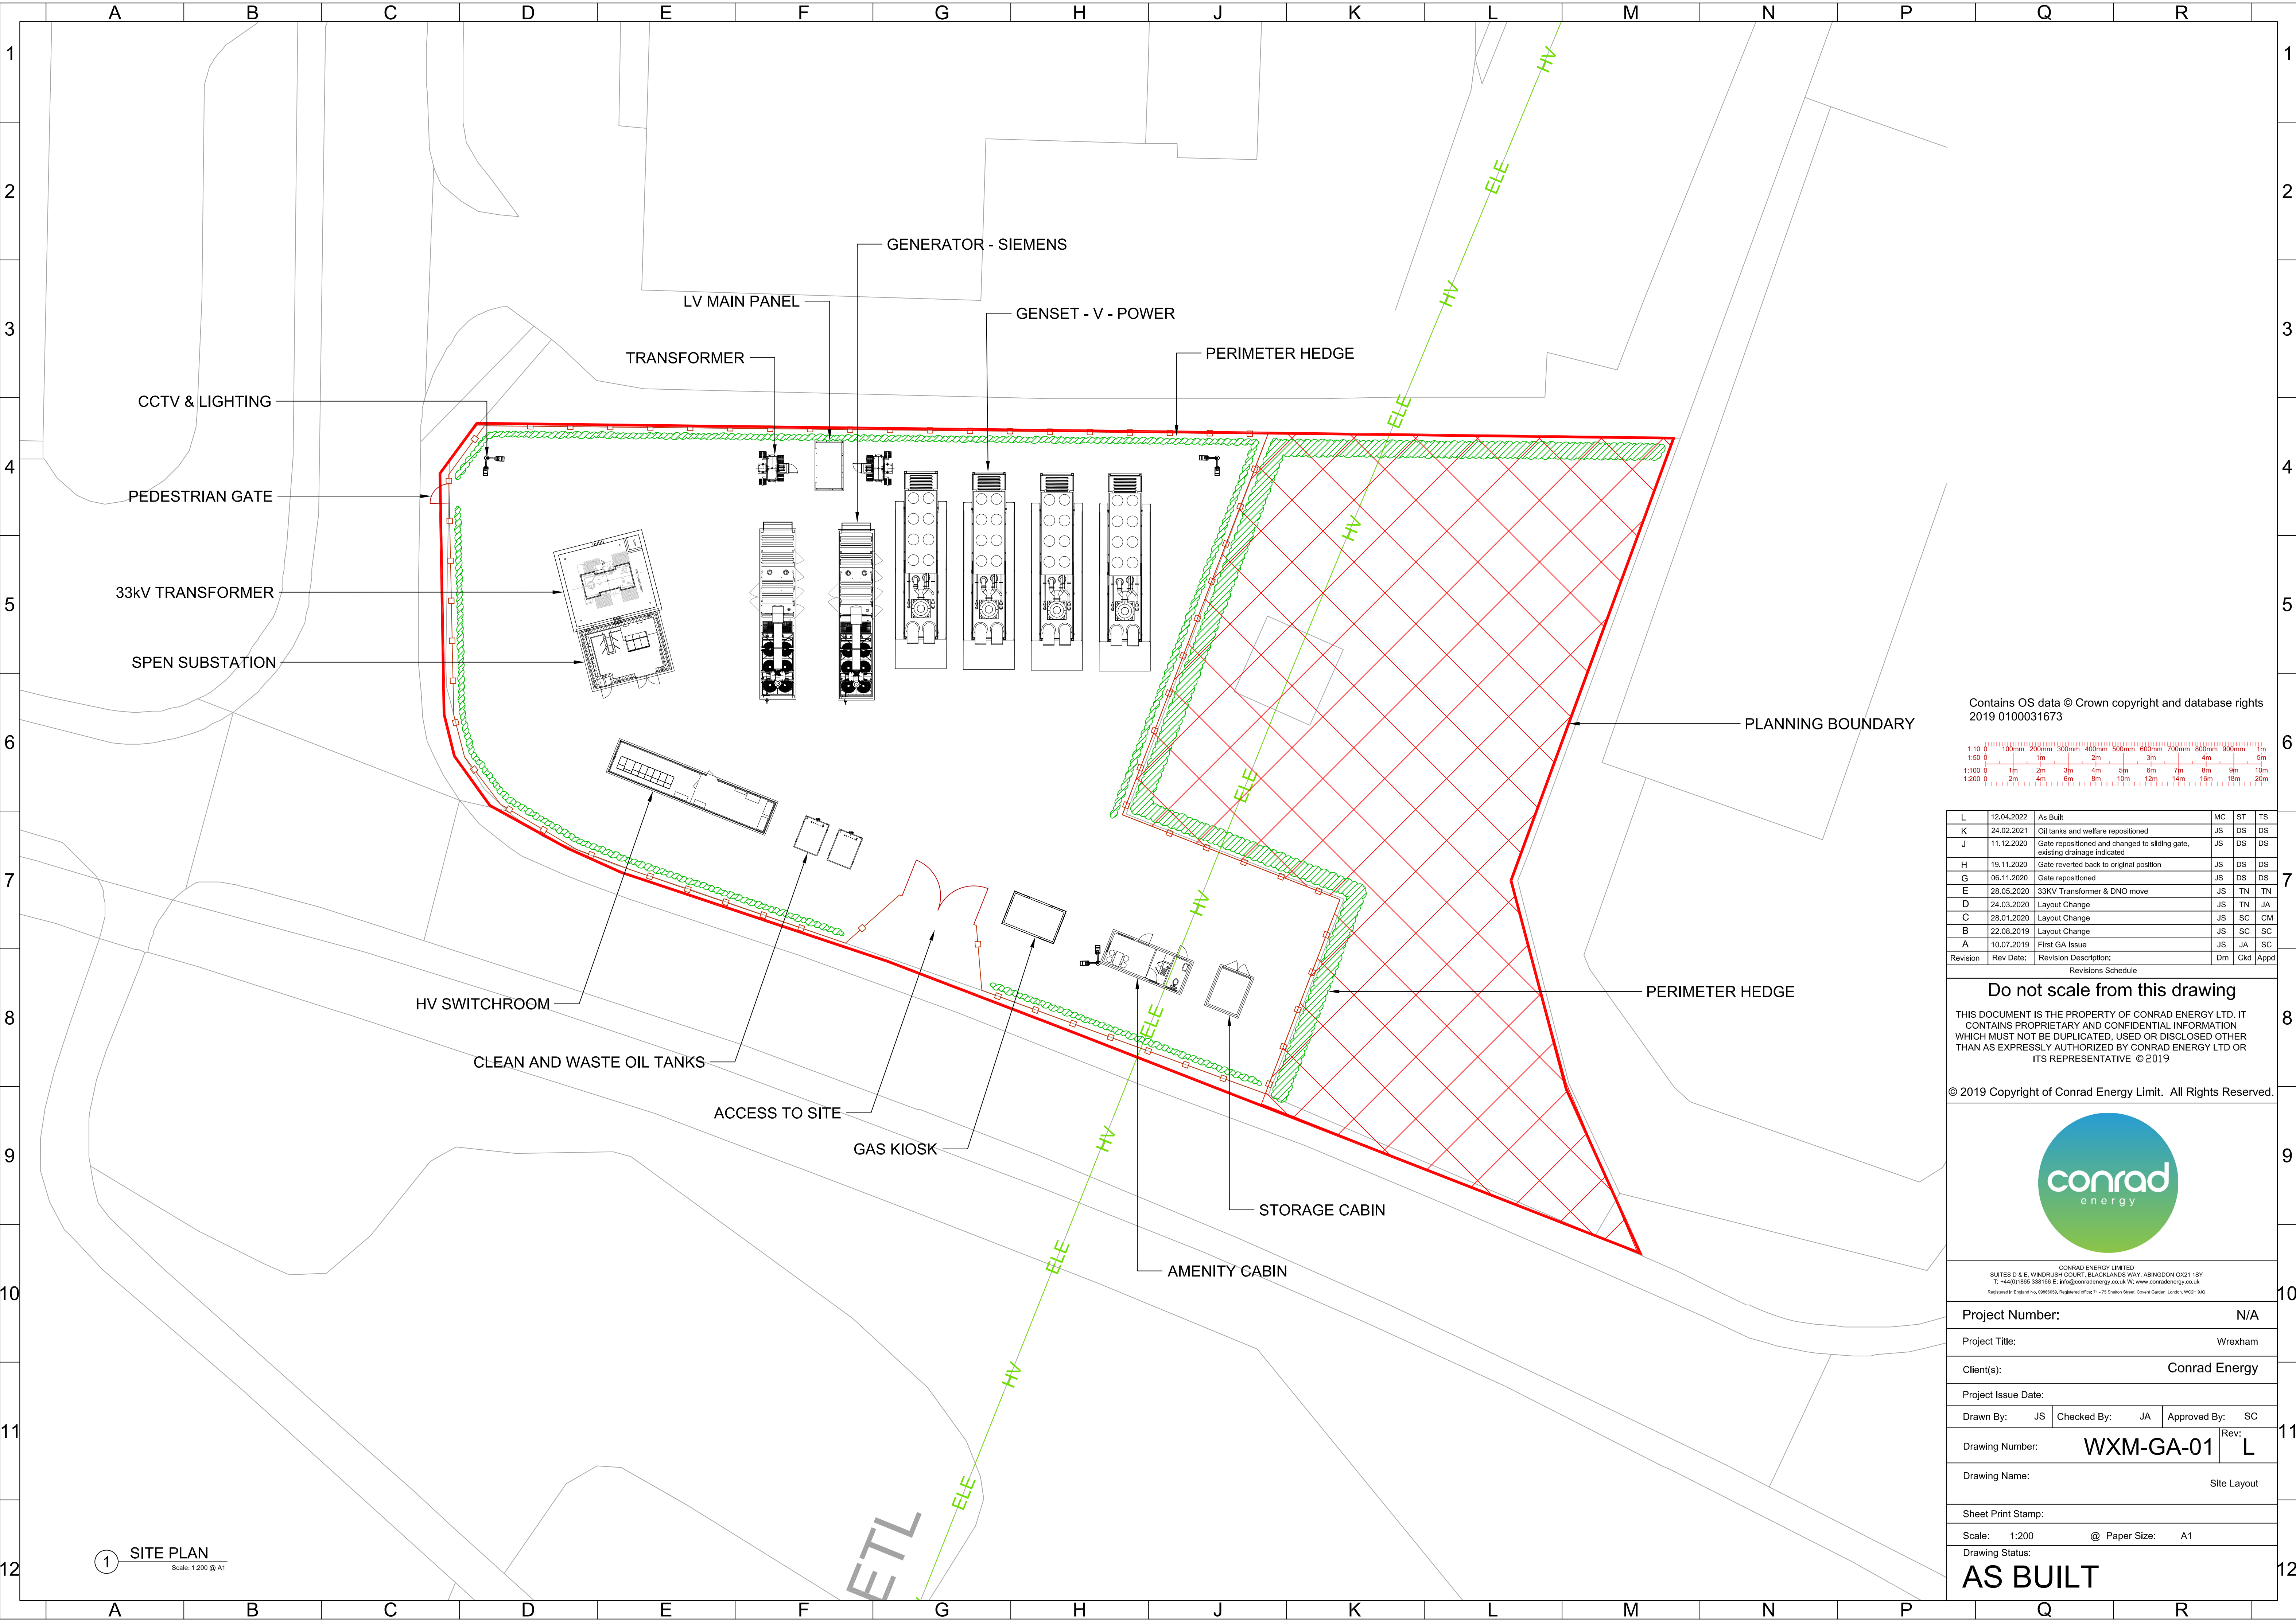

1 SITE PLAN
Scale: 1:200 @ A1

Contains OS data © Crown copyright and database rights
2019 0100031673

1:10 0 100mm 200mm 300mm 400mm 500mm 600mm 700mm 800mm 900mm 1m
1:50 0 2m 4m 6m 8m 10m 12m 14m 16m 18m 20m
1:100 0 2m 4m 6m 8m 10m 12m 14m 16m 18m 20m
1:200 0 2m 4m 6m 8m 10m 12m 14m 16m 18m 20m

L	12.04.2022	As Built	MC	ST	TS
K	24.02.2021	Oil tanks and welfare repositioned	JS	DS	DS
J	11.12.2020	Gate repositioned and changed to sliding gate, existing drainage indicated	JS	DS	DS
H	19.11.2020	Gate reverted back to original position	JS	DS	DS
G	06.11.2020	Gate repositioned	JS	DS	DS
E	28.05.2020	33KV Transformer & DNO move	JS	TN	TN
D	24.03.2020	Layout Change	JS	TN	JA
C	28.01.2020	Layout Change	JS	SC	CM
B	22.08.2019	Layout Change	JS	SC	SC
A	10.07.2019	First GA Issue	JS	JA	SC
Revision	Rev Date:	Revision Description:	Dm	Ckd	Appd

Revisions Schedule

Do not scale from this drawing

THIS DOCUMENT IS THE PROPERTY OF CONRAD ENERGY LTD. IT CONTAINS PROPRIETARY AND CONFIDENTIAL INFORMATION WHICH MUST NOT BE DUPLICATED, USED OR DISCLOSED OTHER THAN AS EXPRESSLY AUTHORIZED BY CONRAD ENERGY LTD OR ITS REPRESENTATIVE ©2019

© 2019 Copyright of Conrad Energy Limit. All Rights Reserved.



CONRAD ENERGY LIMITED
SUITES D & E, WINDRUSH COURT, BLACKLANDS WAY, ABINGDON OX21 1SY
T: +44(0)1865 335165 E: info@conradenergy.co.uk W: www.conradenergy.co.uk
Registered in England No. 08602055 Registered Office T1 - 75 Shackle Street, Convent Garden, London, WC2N 6LD

Project Number:	N/A
Project Title:	Wrexham
Client(s):	Conrad Energy
Project Issue Date:	
Drawn By:	JS
Checked By:	JA
Approved By:	SC
Drawing Number:	WXM-GA-01
Drawing Name:	Site Layout
Sheet Print Stamp:	
Scale:	1:200
@ Paper Size:	A1
Drawing Status:	AS BUILT