




Front Elevation 1:100

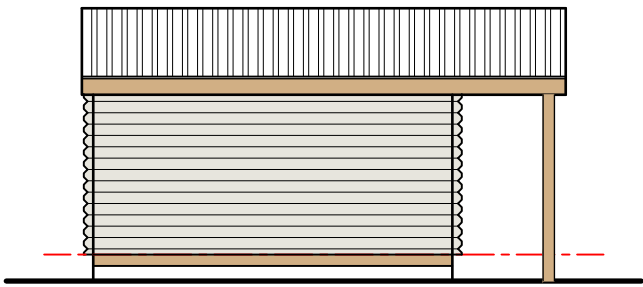


Side-01 Elevation 1:100

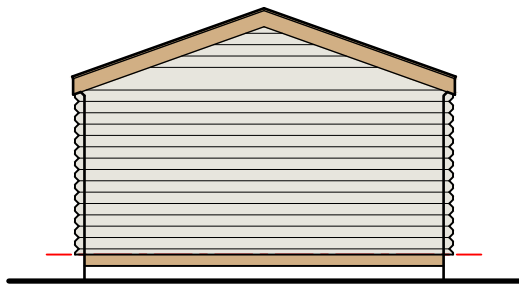


Rear Elevation 1:100

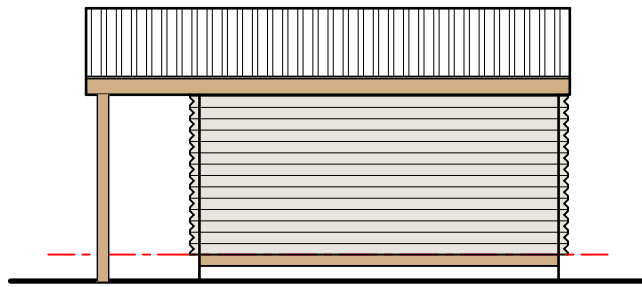


Side-02 Elevation 1:100

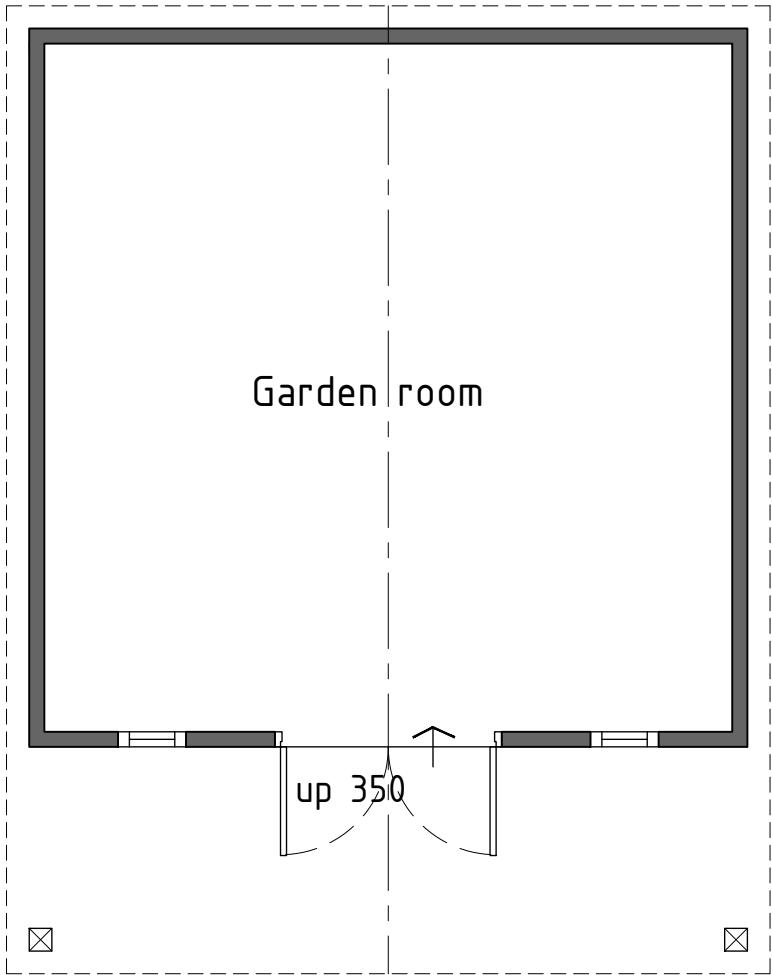


Outbuilding floor plan 1:50

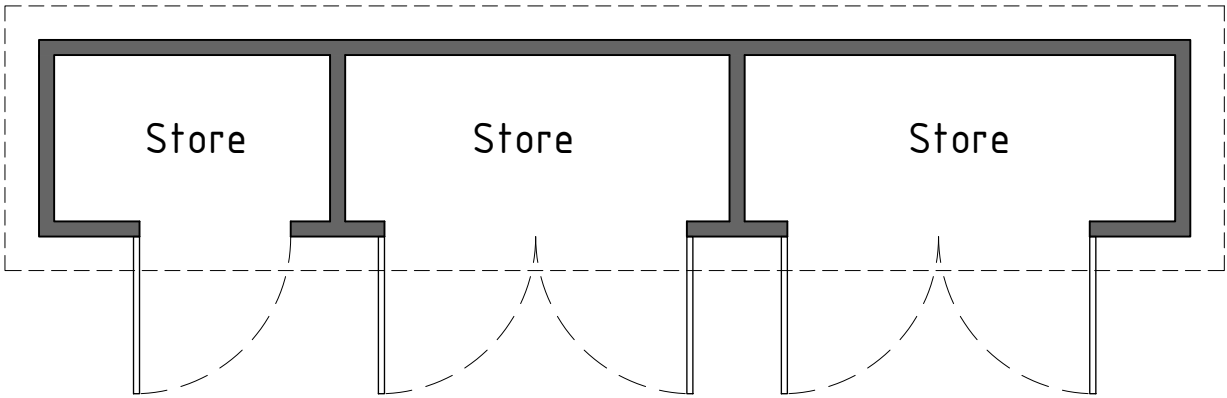


Log Store floor plan 1:50

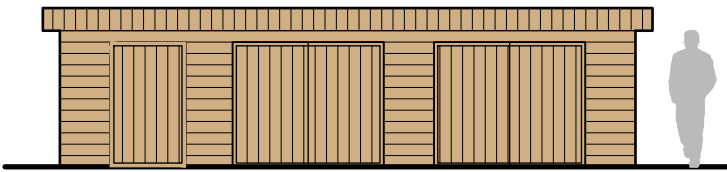


Front Elevation 1:100

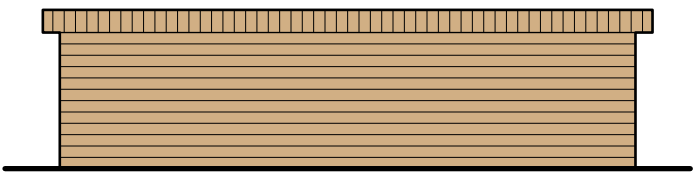

Rear Elevation 1:100

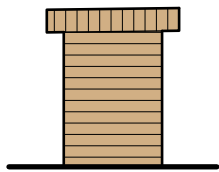

Side-01 Elevation 1:100

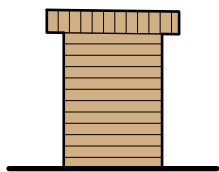

Side-02 Elevation 1:100

As Built



Project; Pandy Wharf, Pandy, Llangollen, LL20 7PD	
Title; As Built Floor plans and Elevations	Scale (A3); 1:50/100
Dwg No; PW/PD/02	Date; 25.02.22
Revision;	