


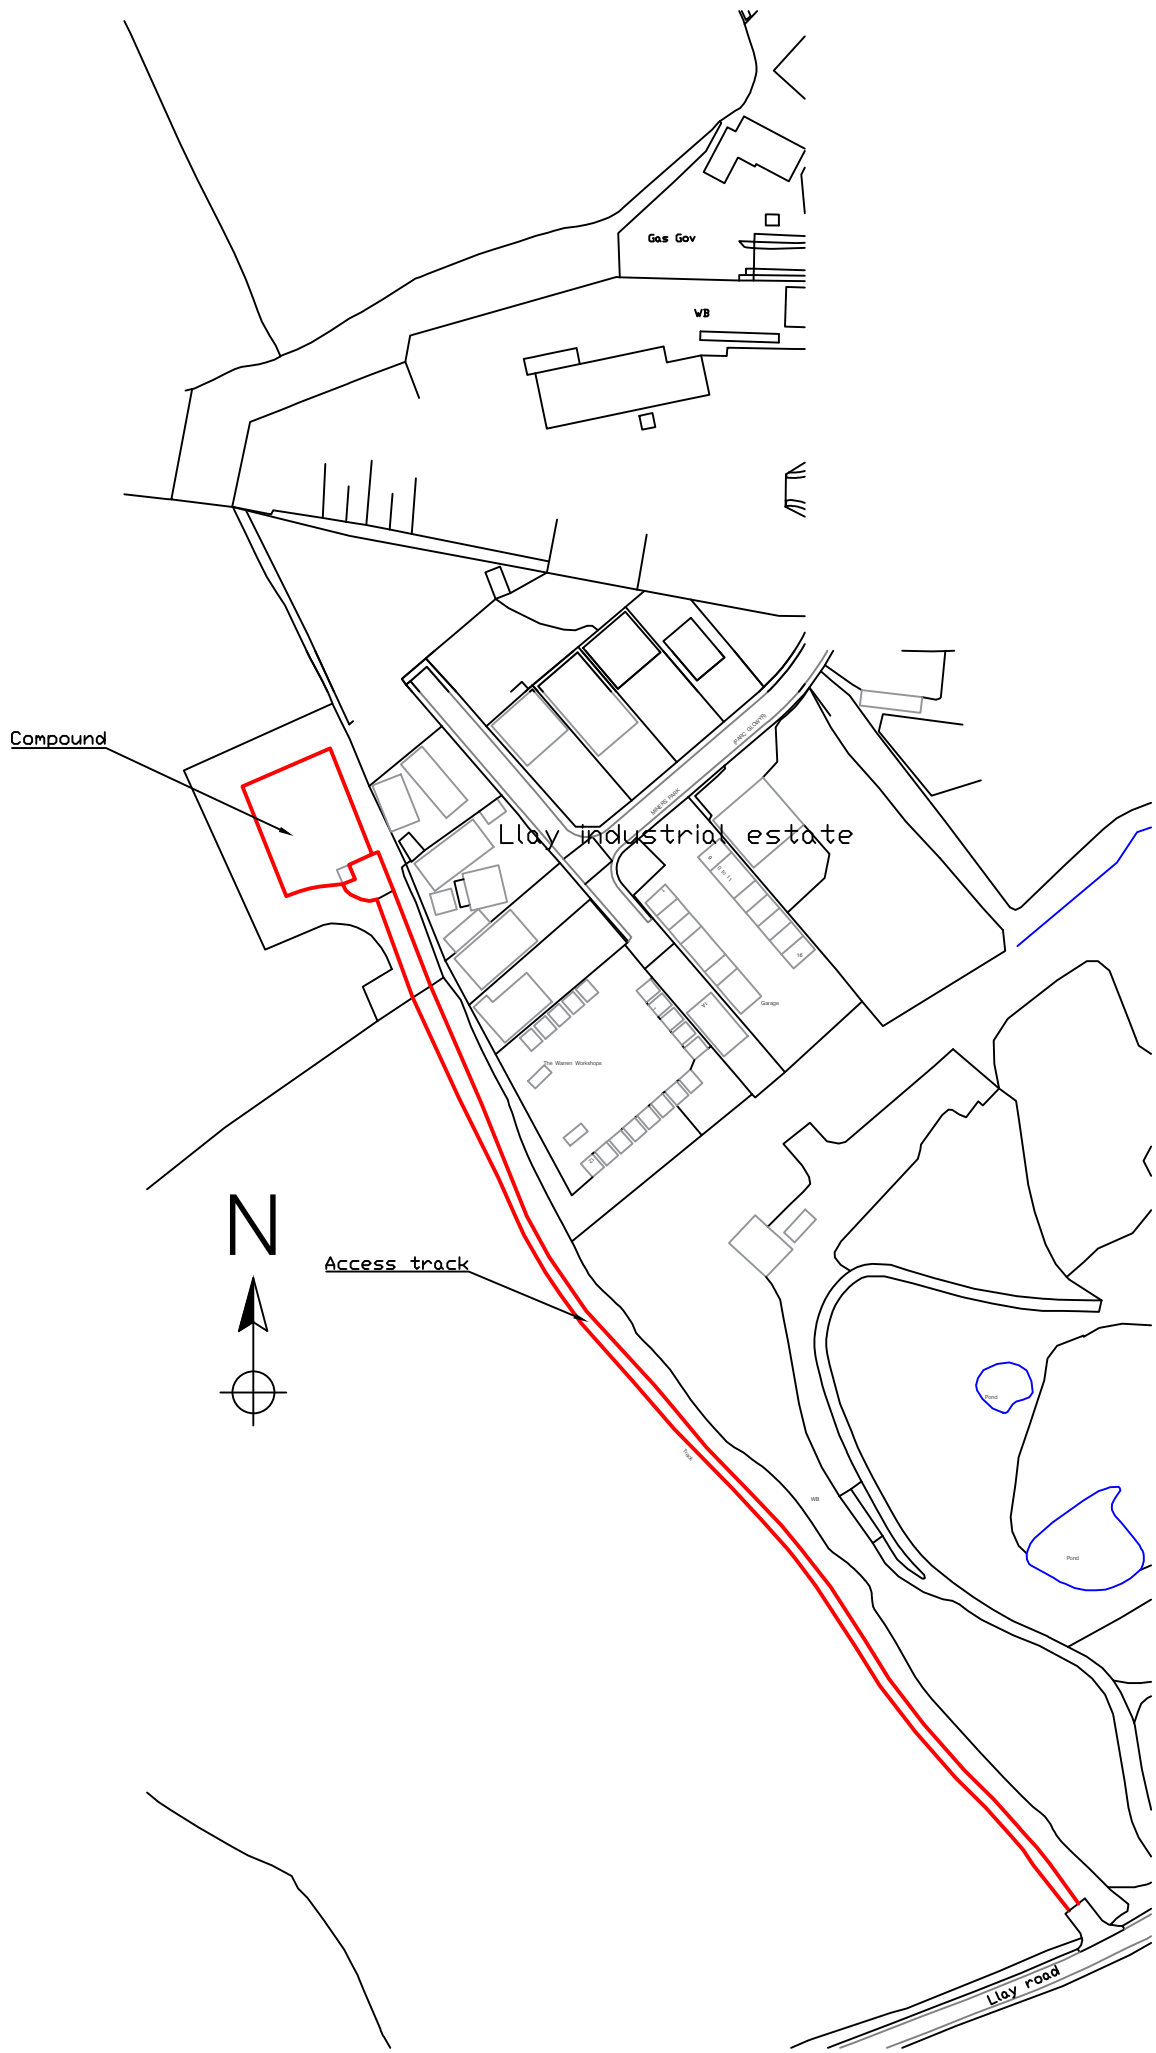

LEGEND

			SITE	Llay	
				DWG. No. BN004-0-Llay-004	
				REV	
				DATE 15/6/21	
			TITLE	COMPOUND	
				COMPOUND ACCESS ROAD	
				DRAWN DT	
				STATUS As built	
					
				Biogas Technology Limited	
				Edison House Daniel Adamson Road Salford Manchester M50 1DT	
				Telephone +44 (0) 161 440 2222 Email info@ylemenergy.com ylemenergy.com Registered in England No. 02152229	
					
				YLEM	
				Ylem Energy Limited Edison House Daniel Adamson Road Salford M50 1DT	
				Telephone +44 (0) 161 440 2222 Email info@ylemenergy.com ylemenergy.com Registered in England No. 02152229	