


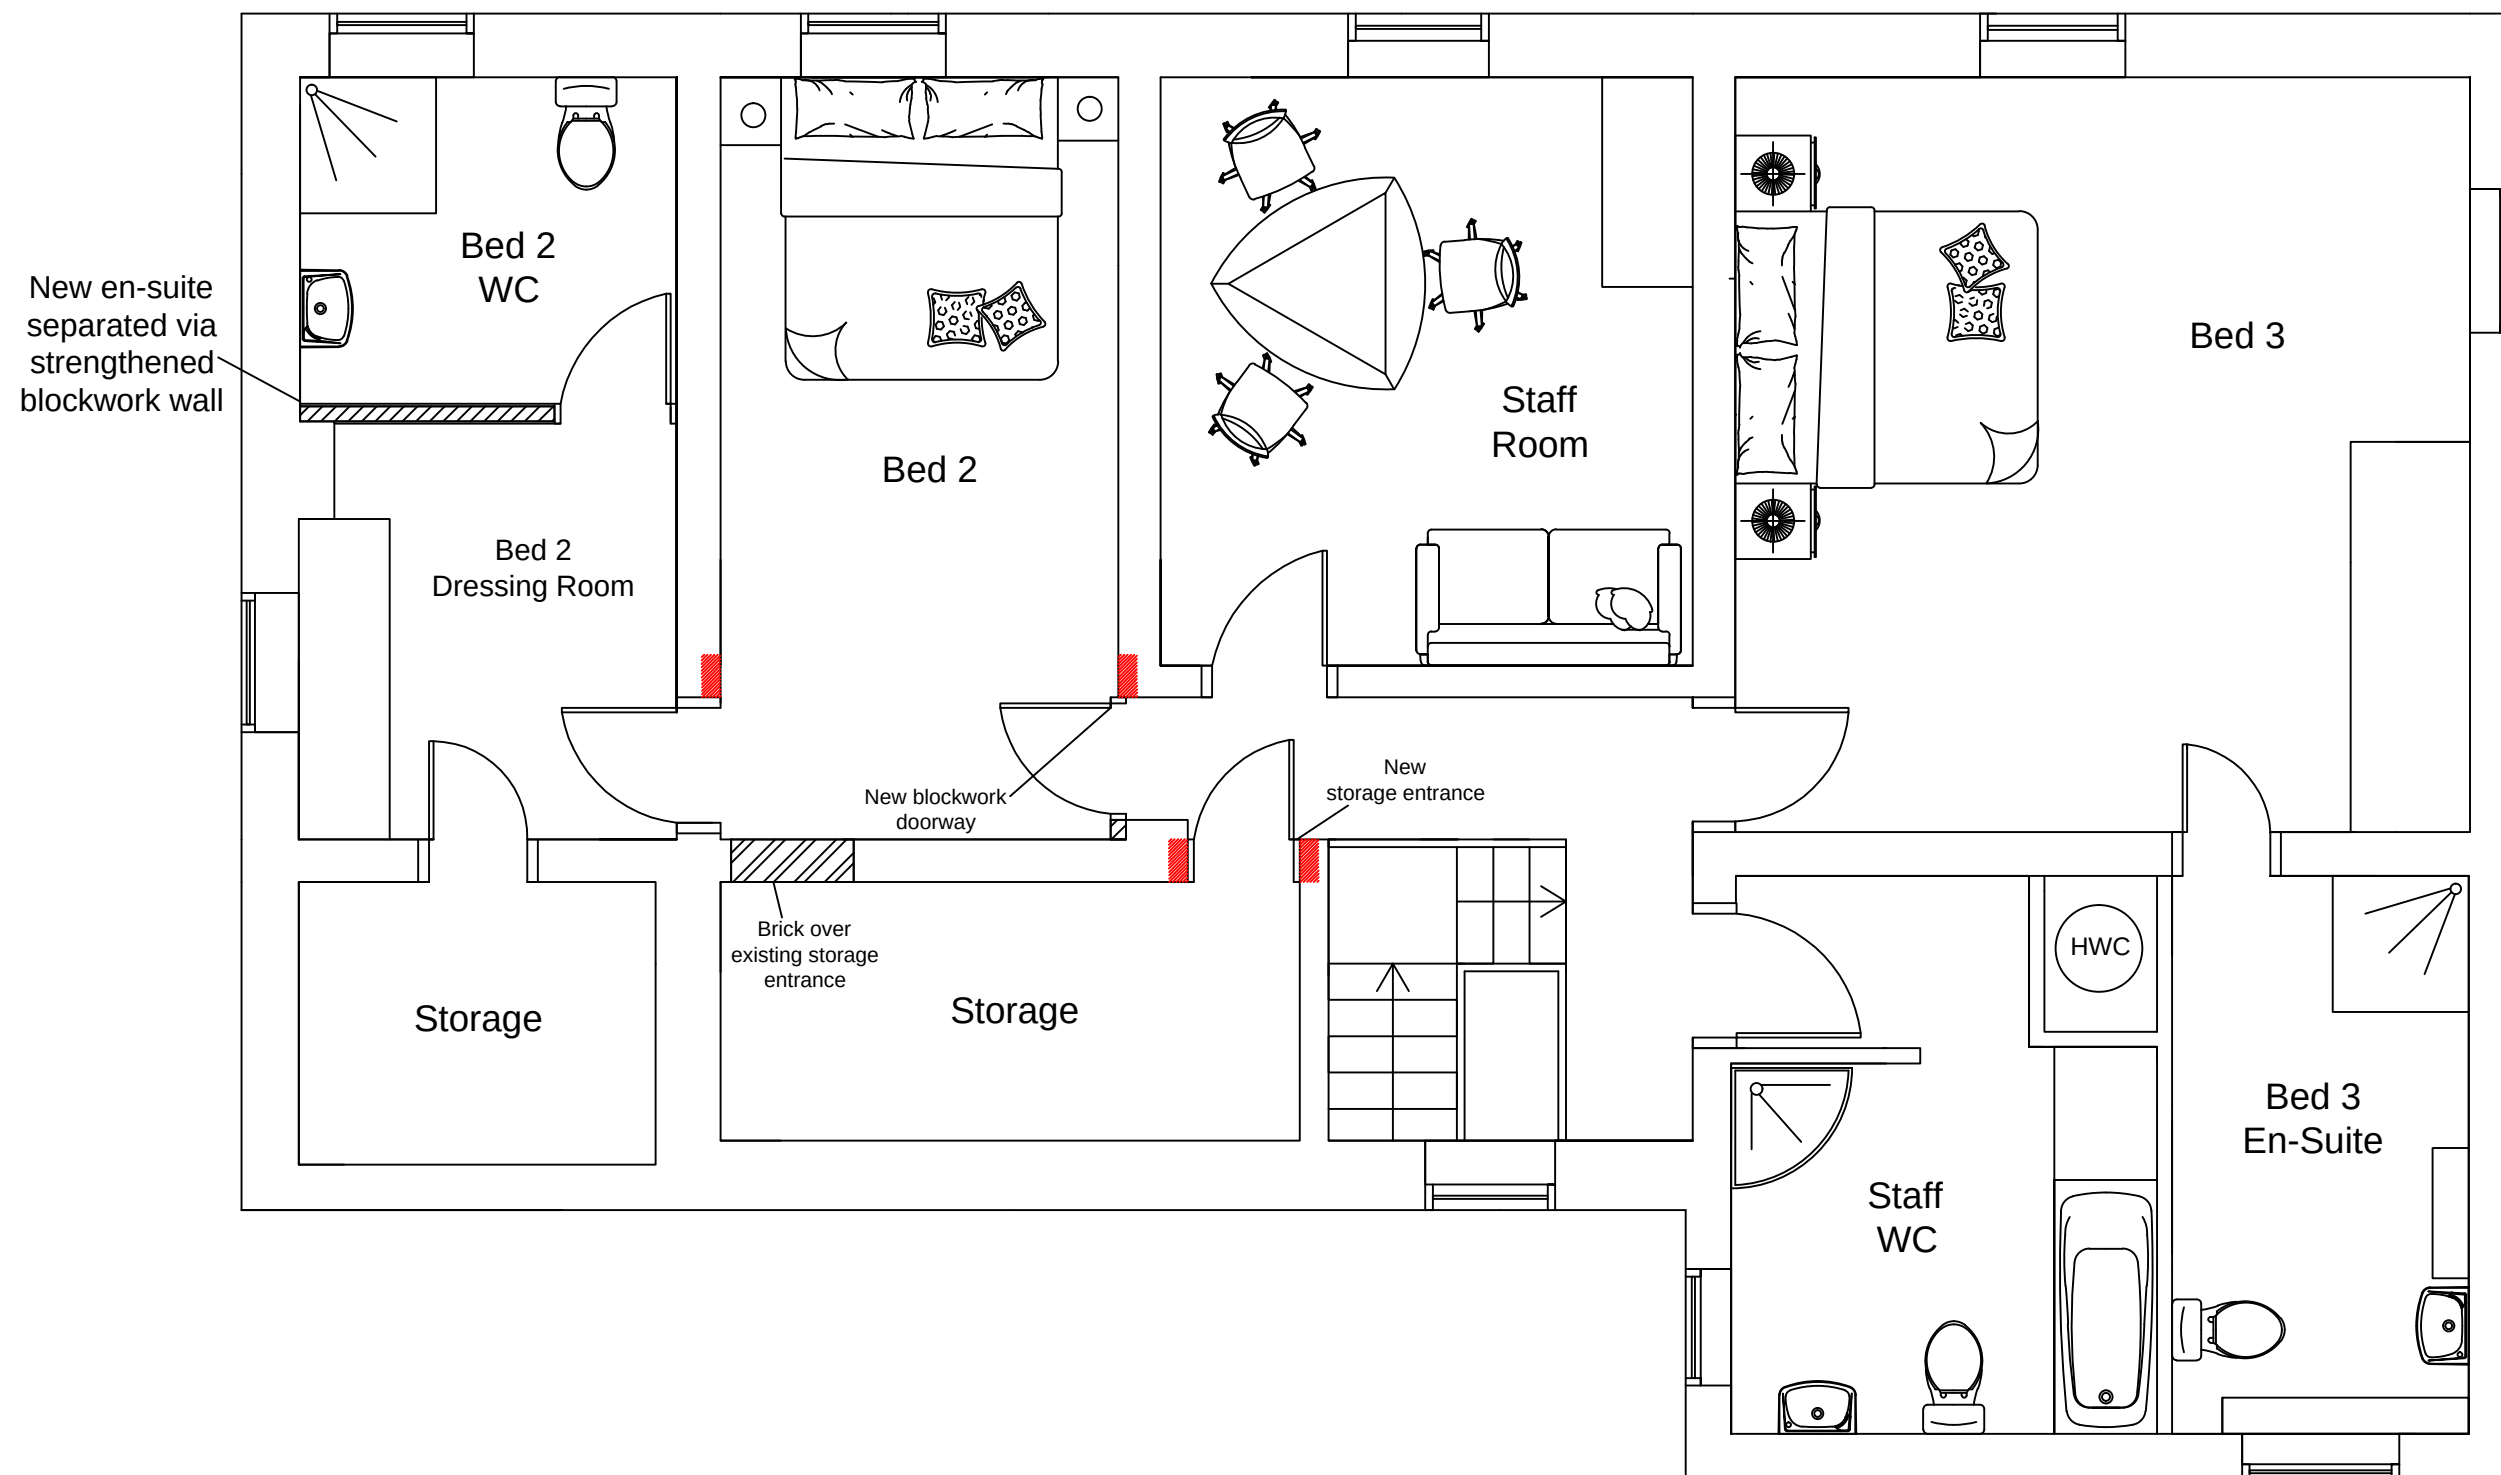

Farmhouse - First Floor



Grantley Lowe

chartered surveyors

34 St Anne Street
Liverpool
L3 3DS

t:0151 298 9669
f:0151 298 9670

www.grantleylowe.co.uk

Rev	Date	Revisions

Client **Fairpark Care Limited**

Job Title

Hullah Farm

Drawing Title

Proposed Floor Plan - First Floor
Farmhouse

Draft / initial / schematic ☐
plan ☒
Planning ☐
Building Regulations ☐
Structural ☐
Construction ☐
As Built ☐

Scale

1:50 @ A3

Date **Nov 2021** Drawn By **WJJ**

Drawing No.	Rev
3513-09	