


Scale :-

PROTECT

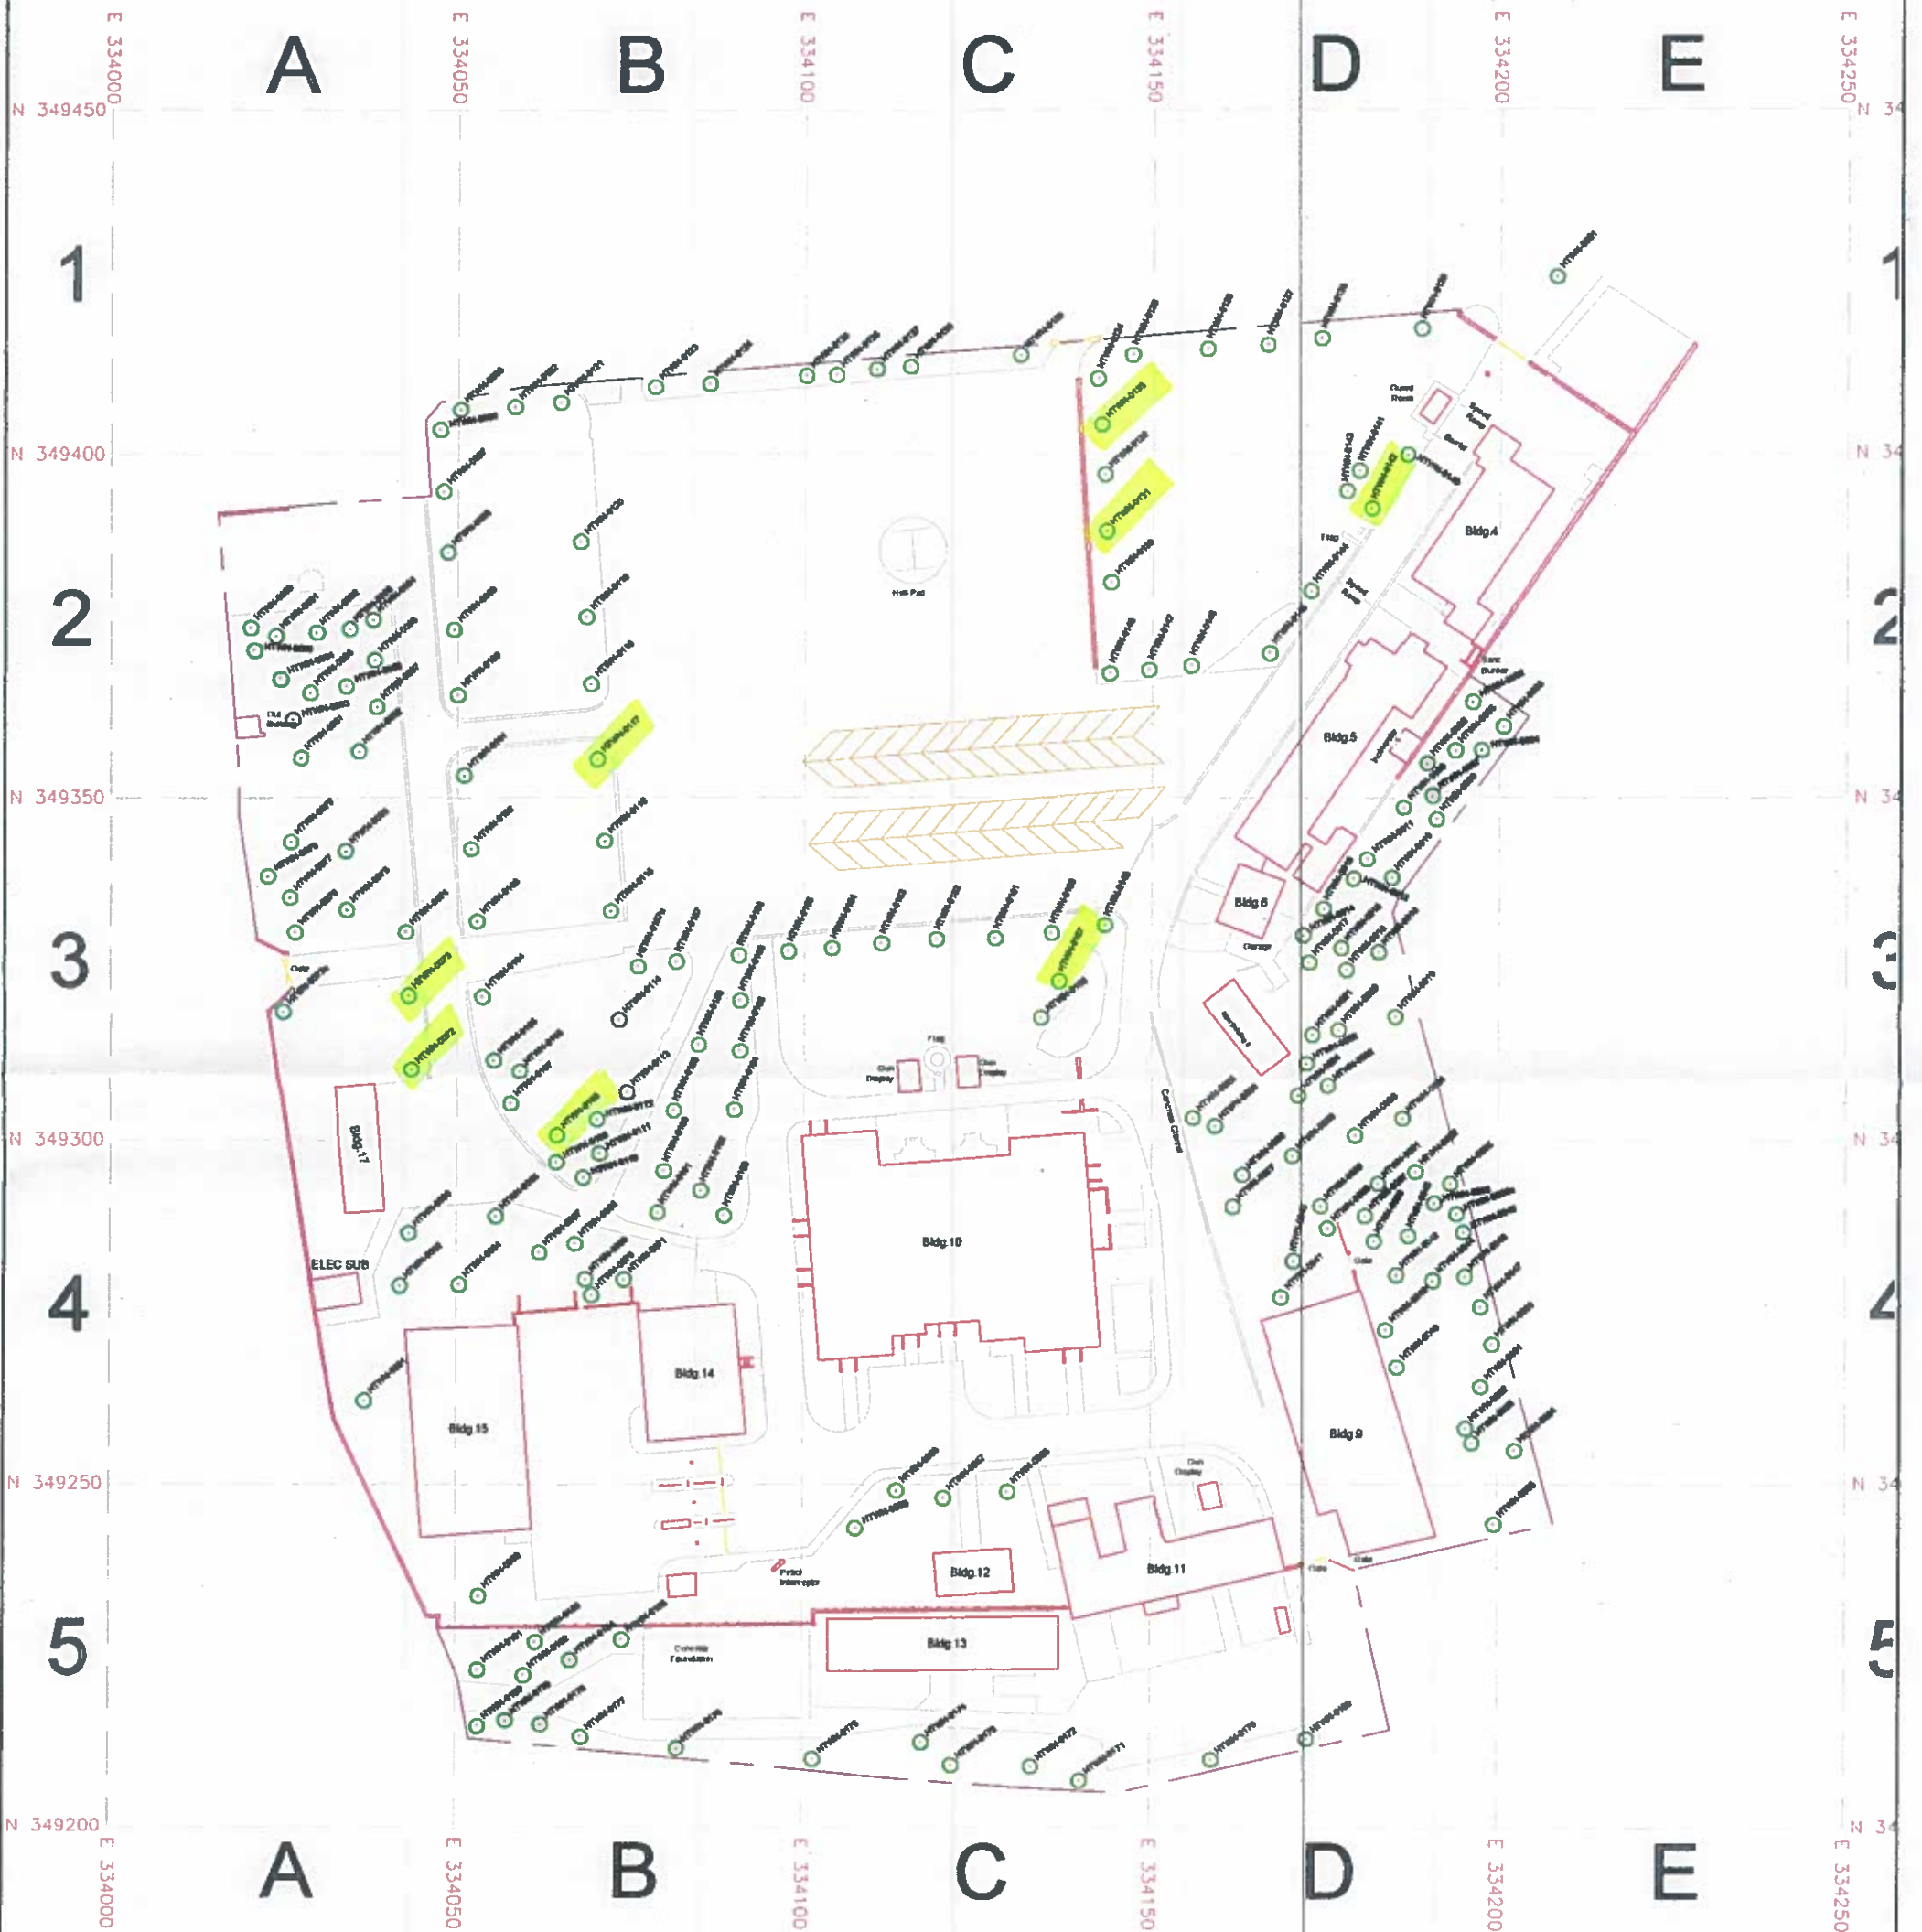

PROTECT

CAD DEPARTMENT

HO SITE
MOD STAFFORD
BEACONSFIELD
ST16 6AQ

TEL: 01785 253485
FAX: 01785 787030

NOTES

NOTE:
THIS DRAWING IS FOR INFORMATION ONLY. DO NOT SCALE.
NOTE:
THIS DRAWING MAY HAVE BEEN CREATED USING DATA FROM
VARIOUS THIRD PARTY SOURCES. CARILLIONENTERPRISE CAN
NOT GUARANTEE THE ACCURACY OF THIS INFORMATION.
NOTE:
IF YOU ARE AWARE OF ANY DRAWINGS (HARD COPY OR
OTHERWISE) THAT SUPERSEDES THIS DRAWING, COULD YOU
PLEASE LET THE CAD OFFICE KNOW USING THE PHONE
NUMBER ON THE BORDER OF THIS DRAWING.

SITE LOCATION PLAN /
MAP



ASSOCIATED DRAWINGS:

SITE/PROJECT:
HIGHTOWN BARRACKS

DWG TITLE:
GENERAL SITE LAYOUT
SHOWING POSITION OF TREES

NOTE:
ALL DATA HELD IS 'AS BUILT'.
THE INFORMATION DISPLAYED ON THIS
DRAWING IS CONSTANTLY BEING UPDATED
AND SUBJECT TO CHANGE. PLEASE CONTACT
THE RELEVANT CAD OFFICE FOR THE LATEST
VERSION (REFERRING TO 'DETAILS OF ISSUE'
IN THE TITLE BLOCK).

SHEET No: 1 OF 1
DATE OF ISSUE: 13 Aug 10 - Colin Powell
DATE DRAWN: 04-09-09
SHEET SIZE: A3
DRAWN BY: TJPW
SCALE: 1:1000
DWG No: 1/HTWN-HTWN-TREE-001

THIS DOCUMENT IS THE PROPERTY OF MINISTRY OF
DEFENCE AND MAY NOT BE RETAINED, COPIED,
DISTRIBUTED, DISPLAYED OR USED WITHOUT THE
EXPRESS PERMISSION OF CARILLIONENTERPRISE LTD.