


SCALE @ 1:100

0 1 5 M



1 REAR (West) ELEVATION

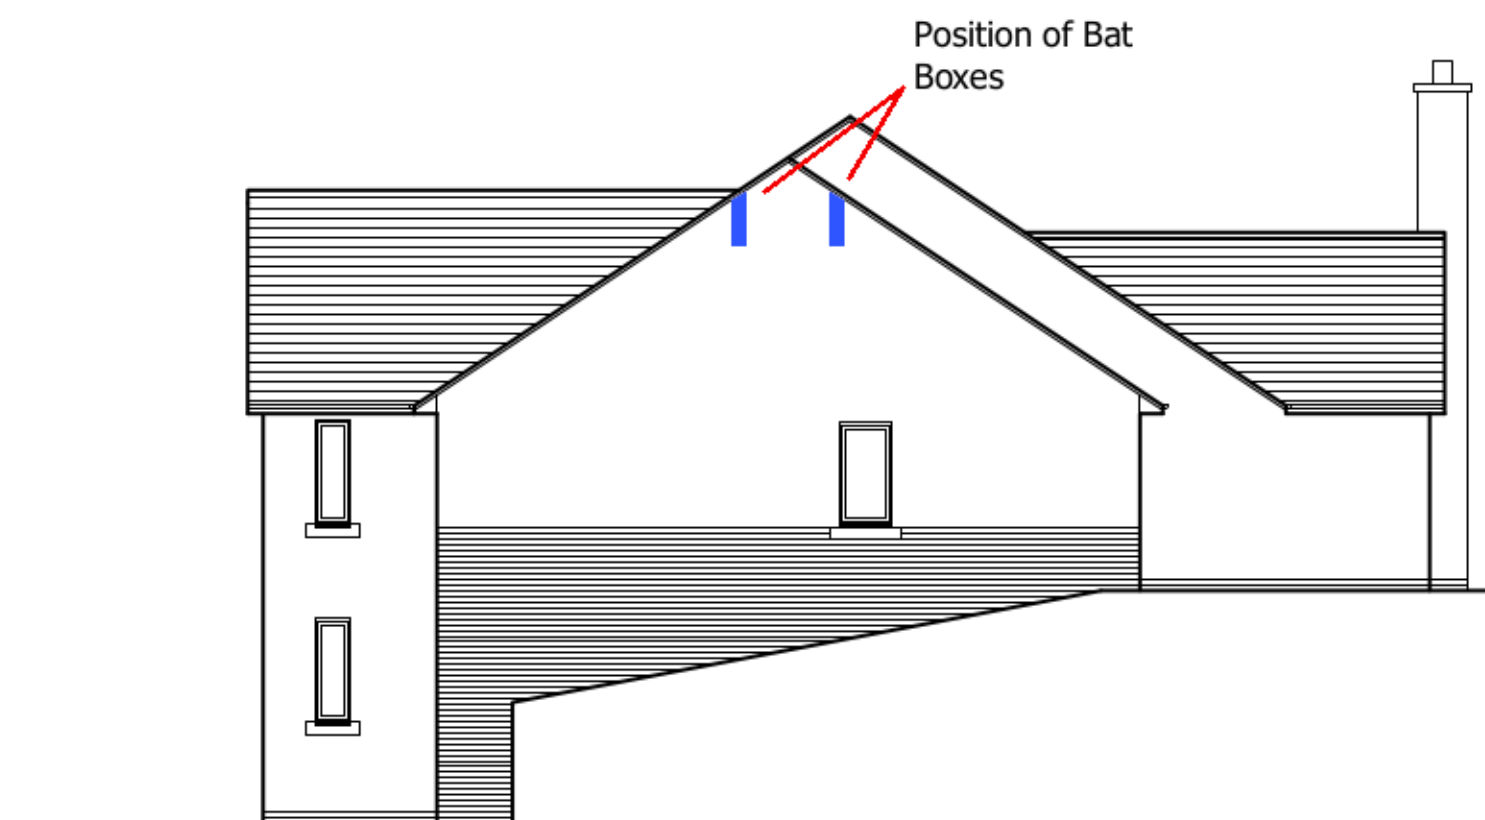

2 SIDE (North) ELEVATION

G - 27 MAR 16 - UPDATED TO AS BUILT
E - 28 MAY 15 - ROOF HP ADDED
D - 03 FEB 15 - MINOR CHANGES
C - 19 DEC 14 - REAR DORMERS ADDED
B - 12 DEC 14 - UPDATED
A - 24 SEPT 14 - FIRST ISSUE

InSite
ARCHITECTURE
4 OLD PORT SQUARE
CHESTER
CH1 4JP
T. 01244 374501
mail@insitearchitecture.co.uk

'EDGE HILL' HOSELEY LANE, LL12 8YE

PROPOSED REPLACEMENT DWELLING

PROPOSED
ELEVATIONS

SCALE 1:100 @ A3

dwg : ISA 249 P 204

revision:

G

WARNING: DO NOT SCALE FROM PRINTS - WORK FROM FIGURED DIMENSIONS ONLY
THIS DRAWING REMAINS THE LEGAL PROPERTY OF INSITE ARCHITECTURE AND UNAUTHORISED USE OR REPRODUCTION
OF IT WITHOUT PRIOR WRITTEN CONSENT IS EXPRESSLY FORBIDDEN WITHOUT PRIOR CONSENT. ALL DRAWINGS ARE SUBJECT TO INSITE'S L&C