


LEICESTER CITY
COUNCIL
26 APR 2016
AMENDED
PLANNING DEPARTMENT

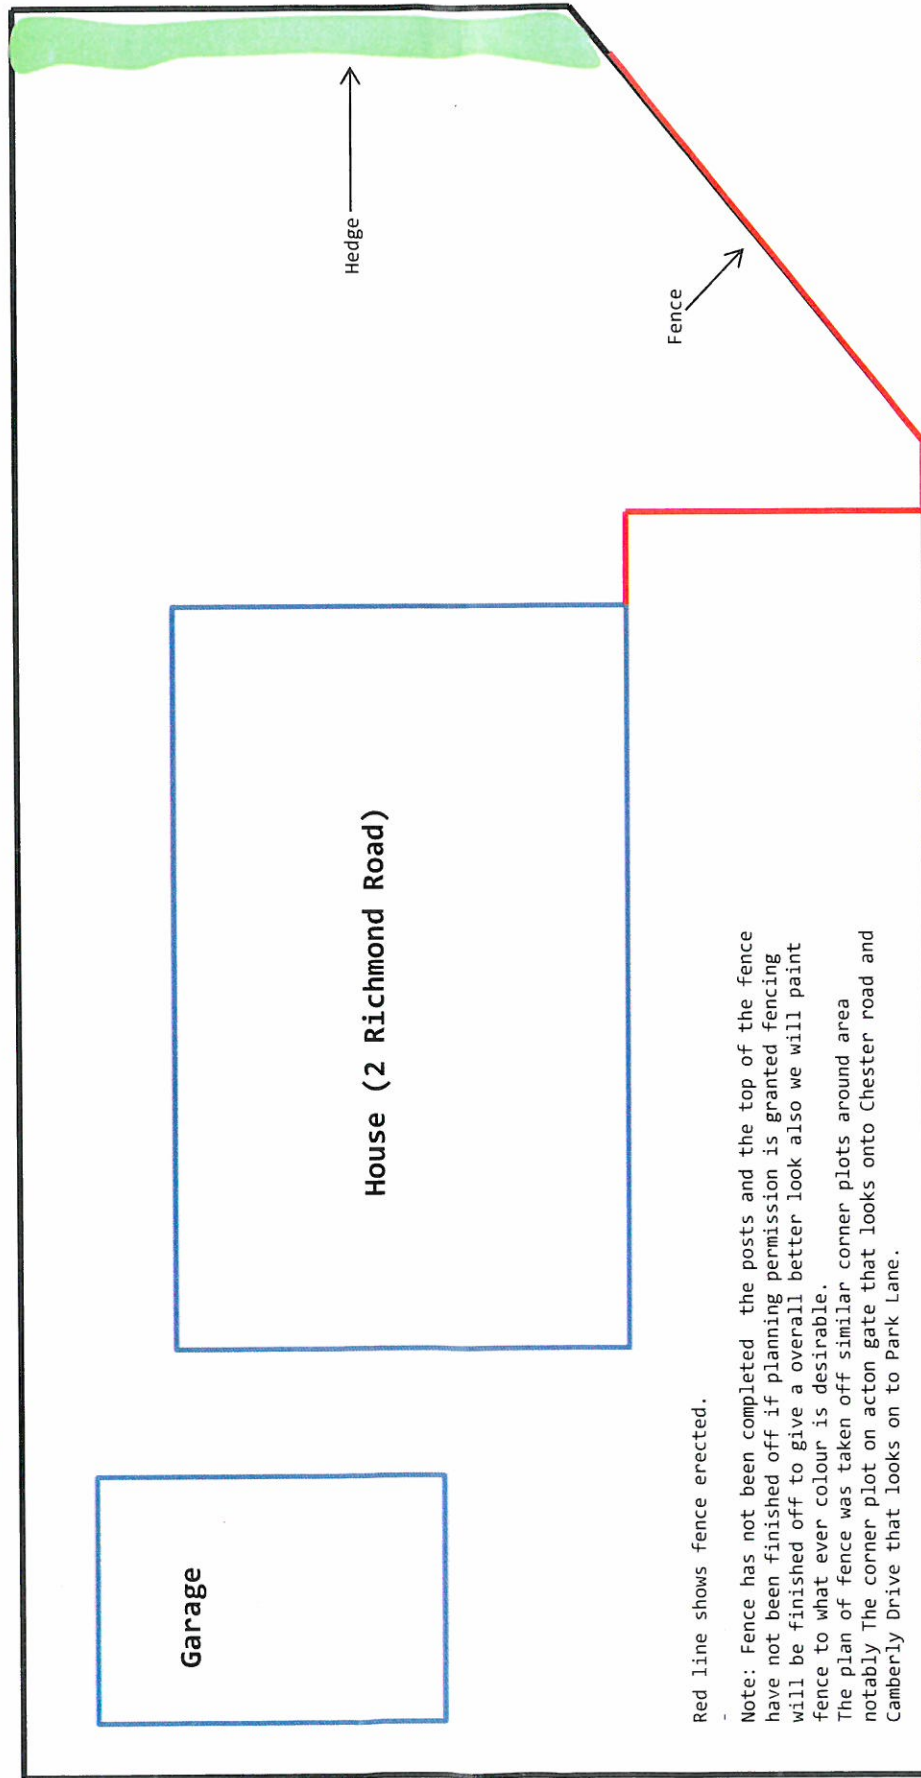

Red line shows fence erected.

Note: Fence has not been completed the posts and the top of the fence have not been finished off if planning permission is granted fencing will be finished off to give a overall better look also we will paint fence to what ever colour is desirable.
The plan of fence was taken off similar corner plots around area notably The corner plot on action gate that looks onto Chester road and Camberly Drive that looks on to Park Lane.

WINDERMERE COUNTY
COUNCIL
22 APR 2016
APPROVED
PLANNING PERMISSION

