


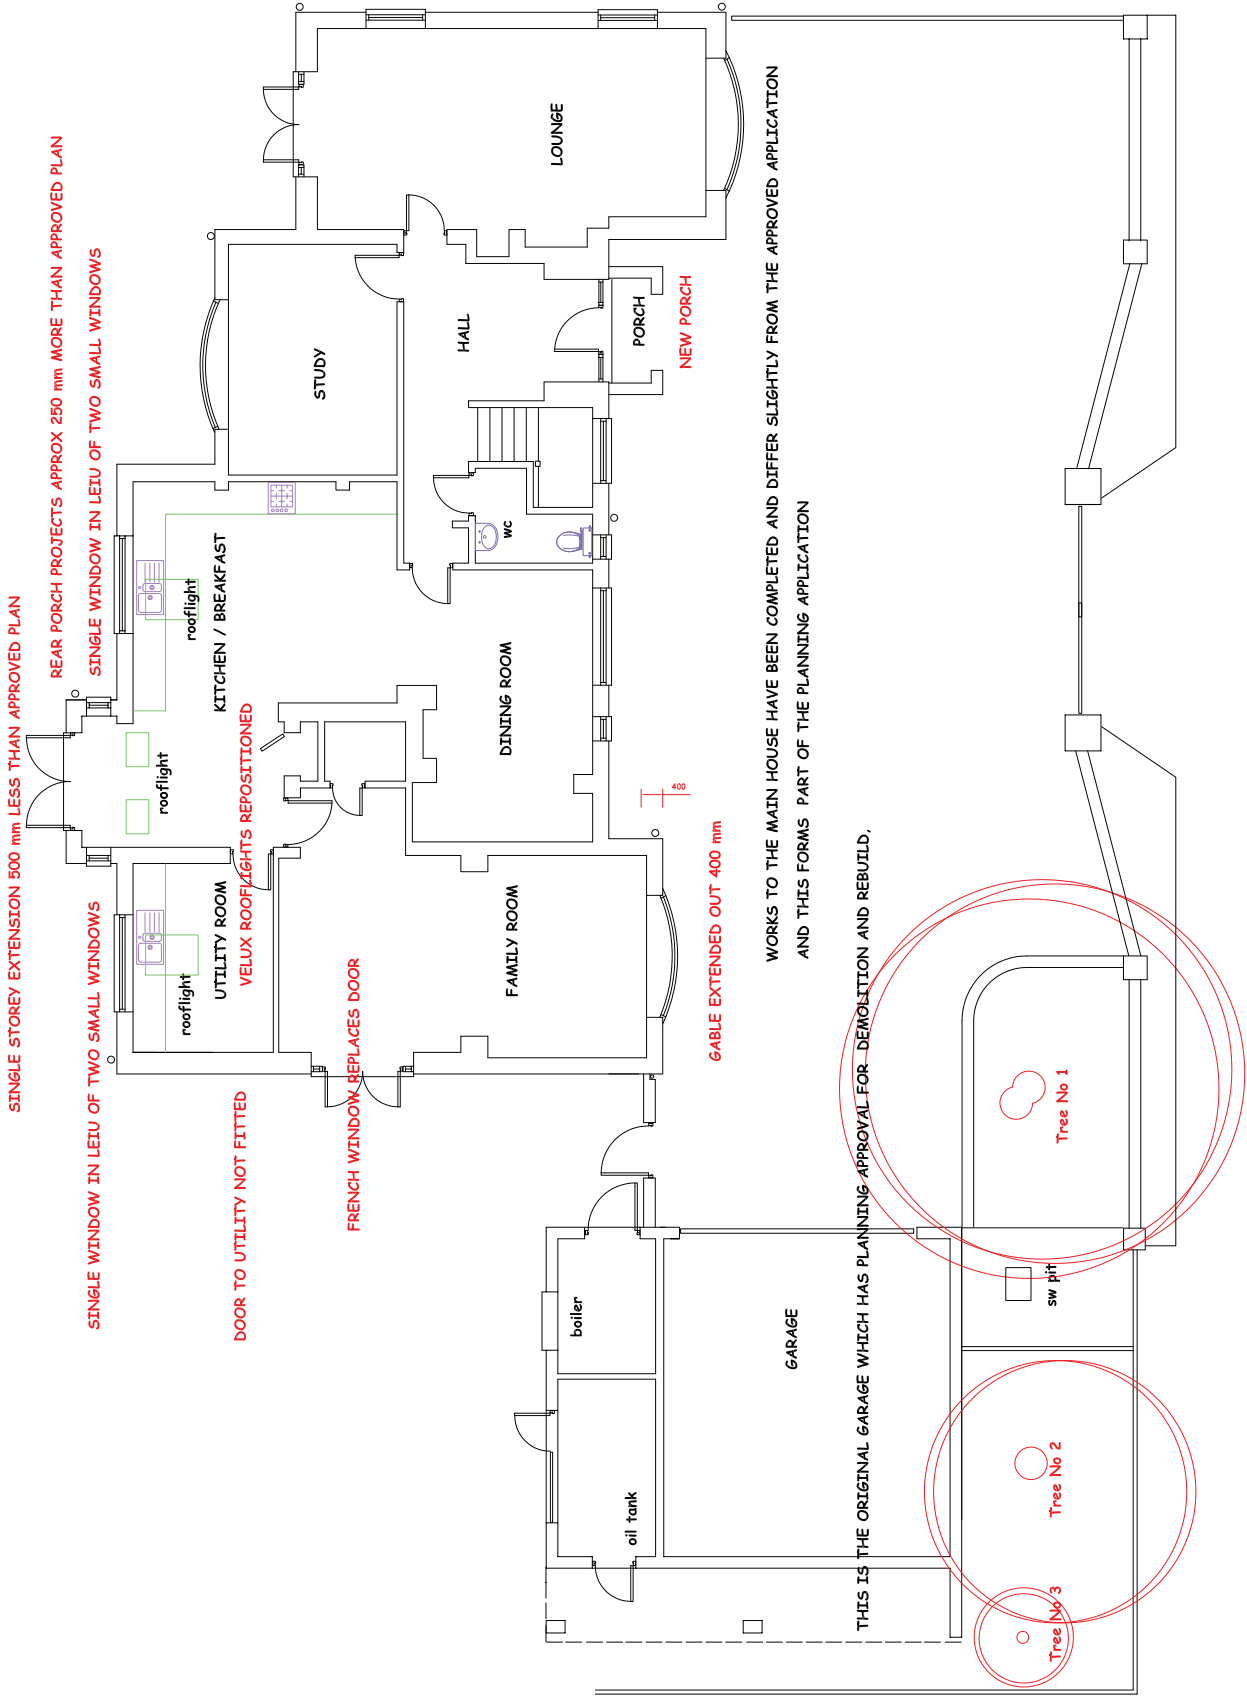

Existing Trees Legend
 Tree No 1 Ash - large
 Tree No 2 Oak - medium
 Tree No 3 Crab Apple - small
 The existing trees - marked in red - to be completely removed
 as recommended by Alistair Henderson, Tree Solutions

ALTERATIONS TO APPROVED PLANNING APPLICATION ROS/P/2006/0447 AT MEADOW COTTAGE BUTON GREEN ROSSETT
 FOR MR& MRS W UNDERWOOD
 GROUND FLOOR PLAN AS EXISTING MAY 2010
 Dwg No WU/01 Scale 1:50 @ A1
 Rev A Planning Application May 10
 Rev B Existing trees removed 10/06/10