


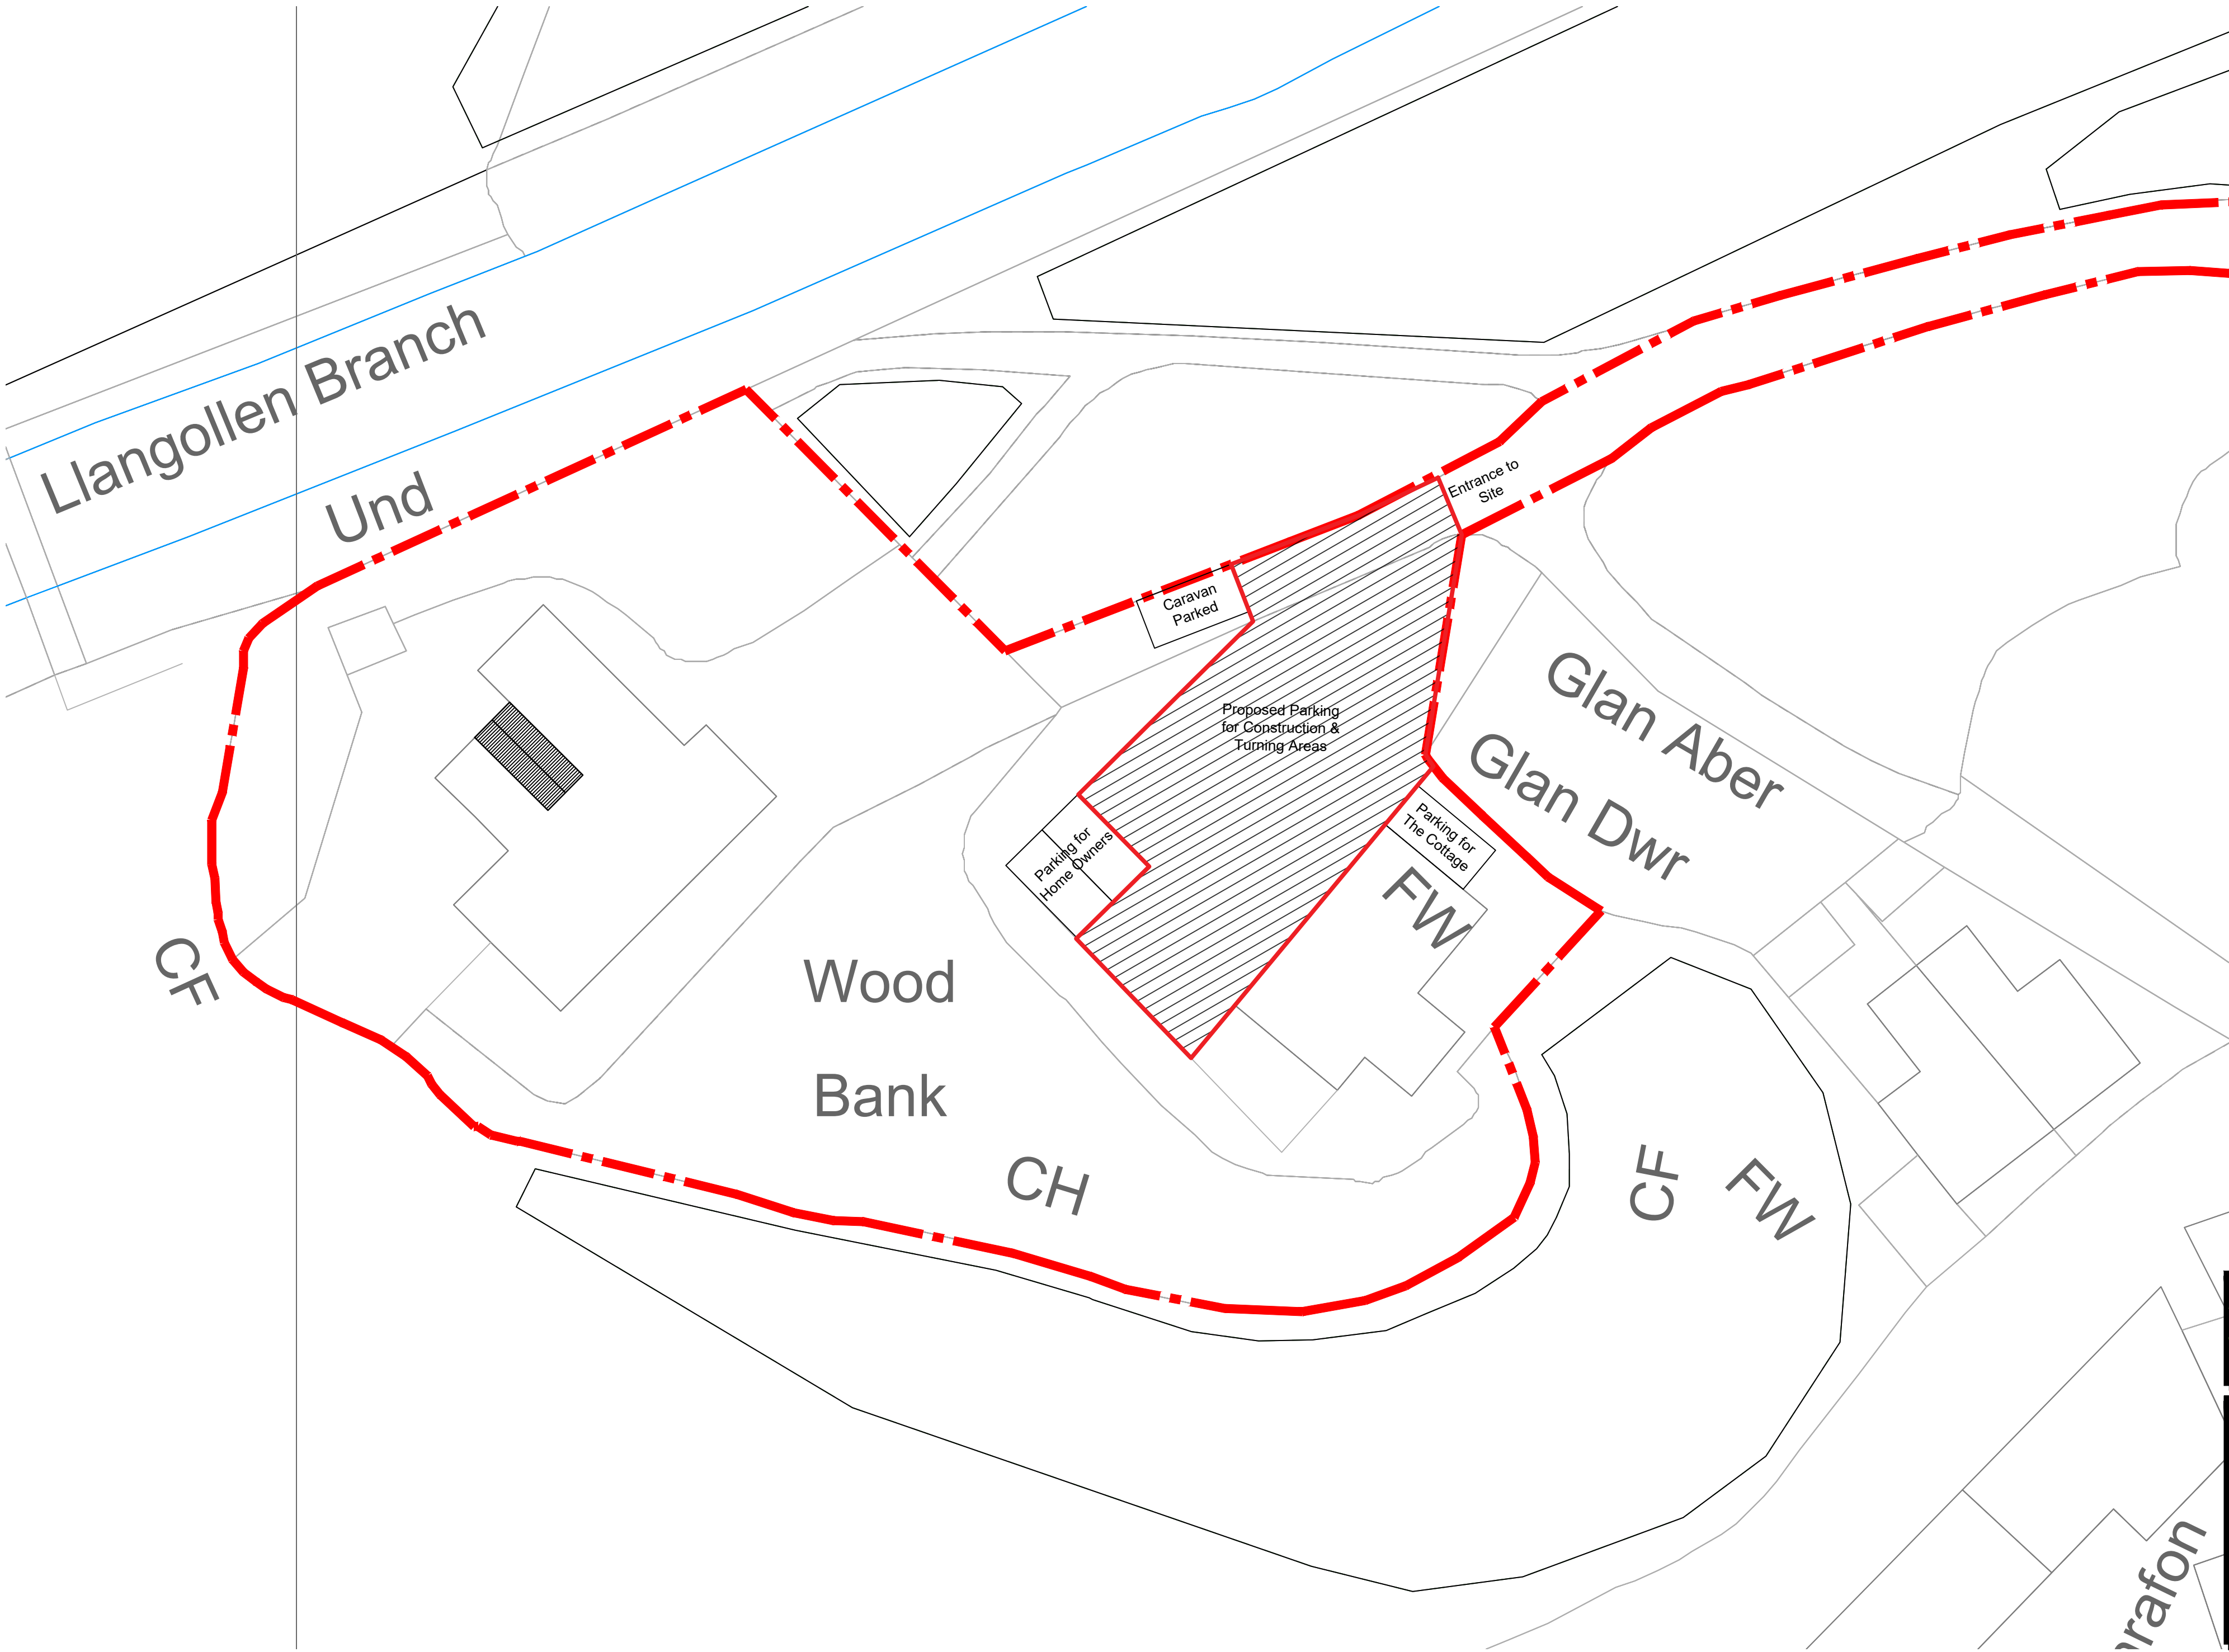

Project; Woodbank Cottage, Pontcysyllte, Llangollen, LL20 7YR	
Title; Proposed Site Plan	Scale (A2); 1:200
Dwg No; WC/PD/06	Date; April 2021
Revision; REV A - red line to highlight parking & turning areas for vehicles entering for the construction phase and when staying at the Cottage (29-04-21).	