


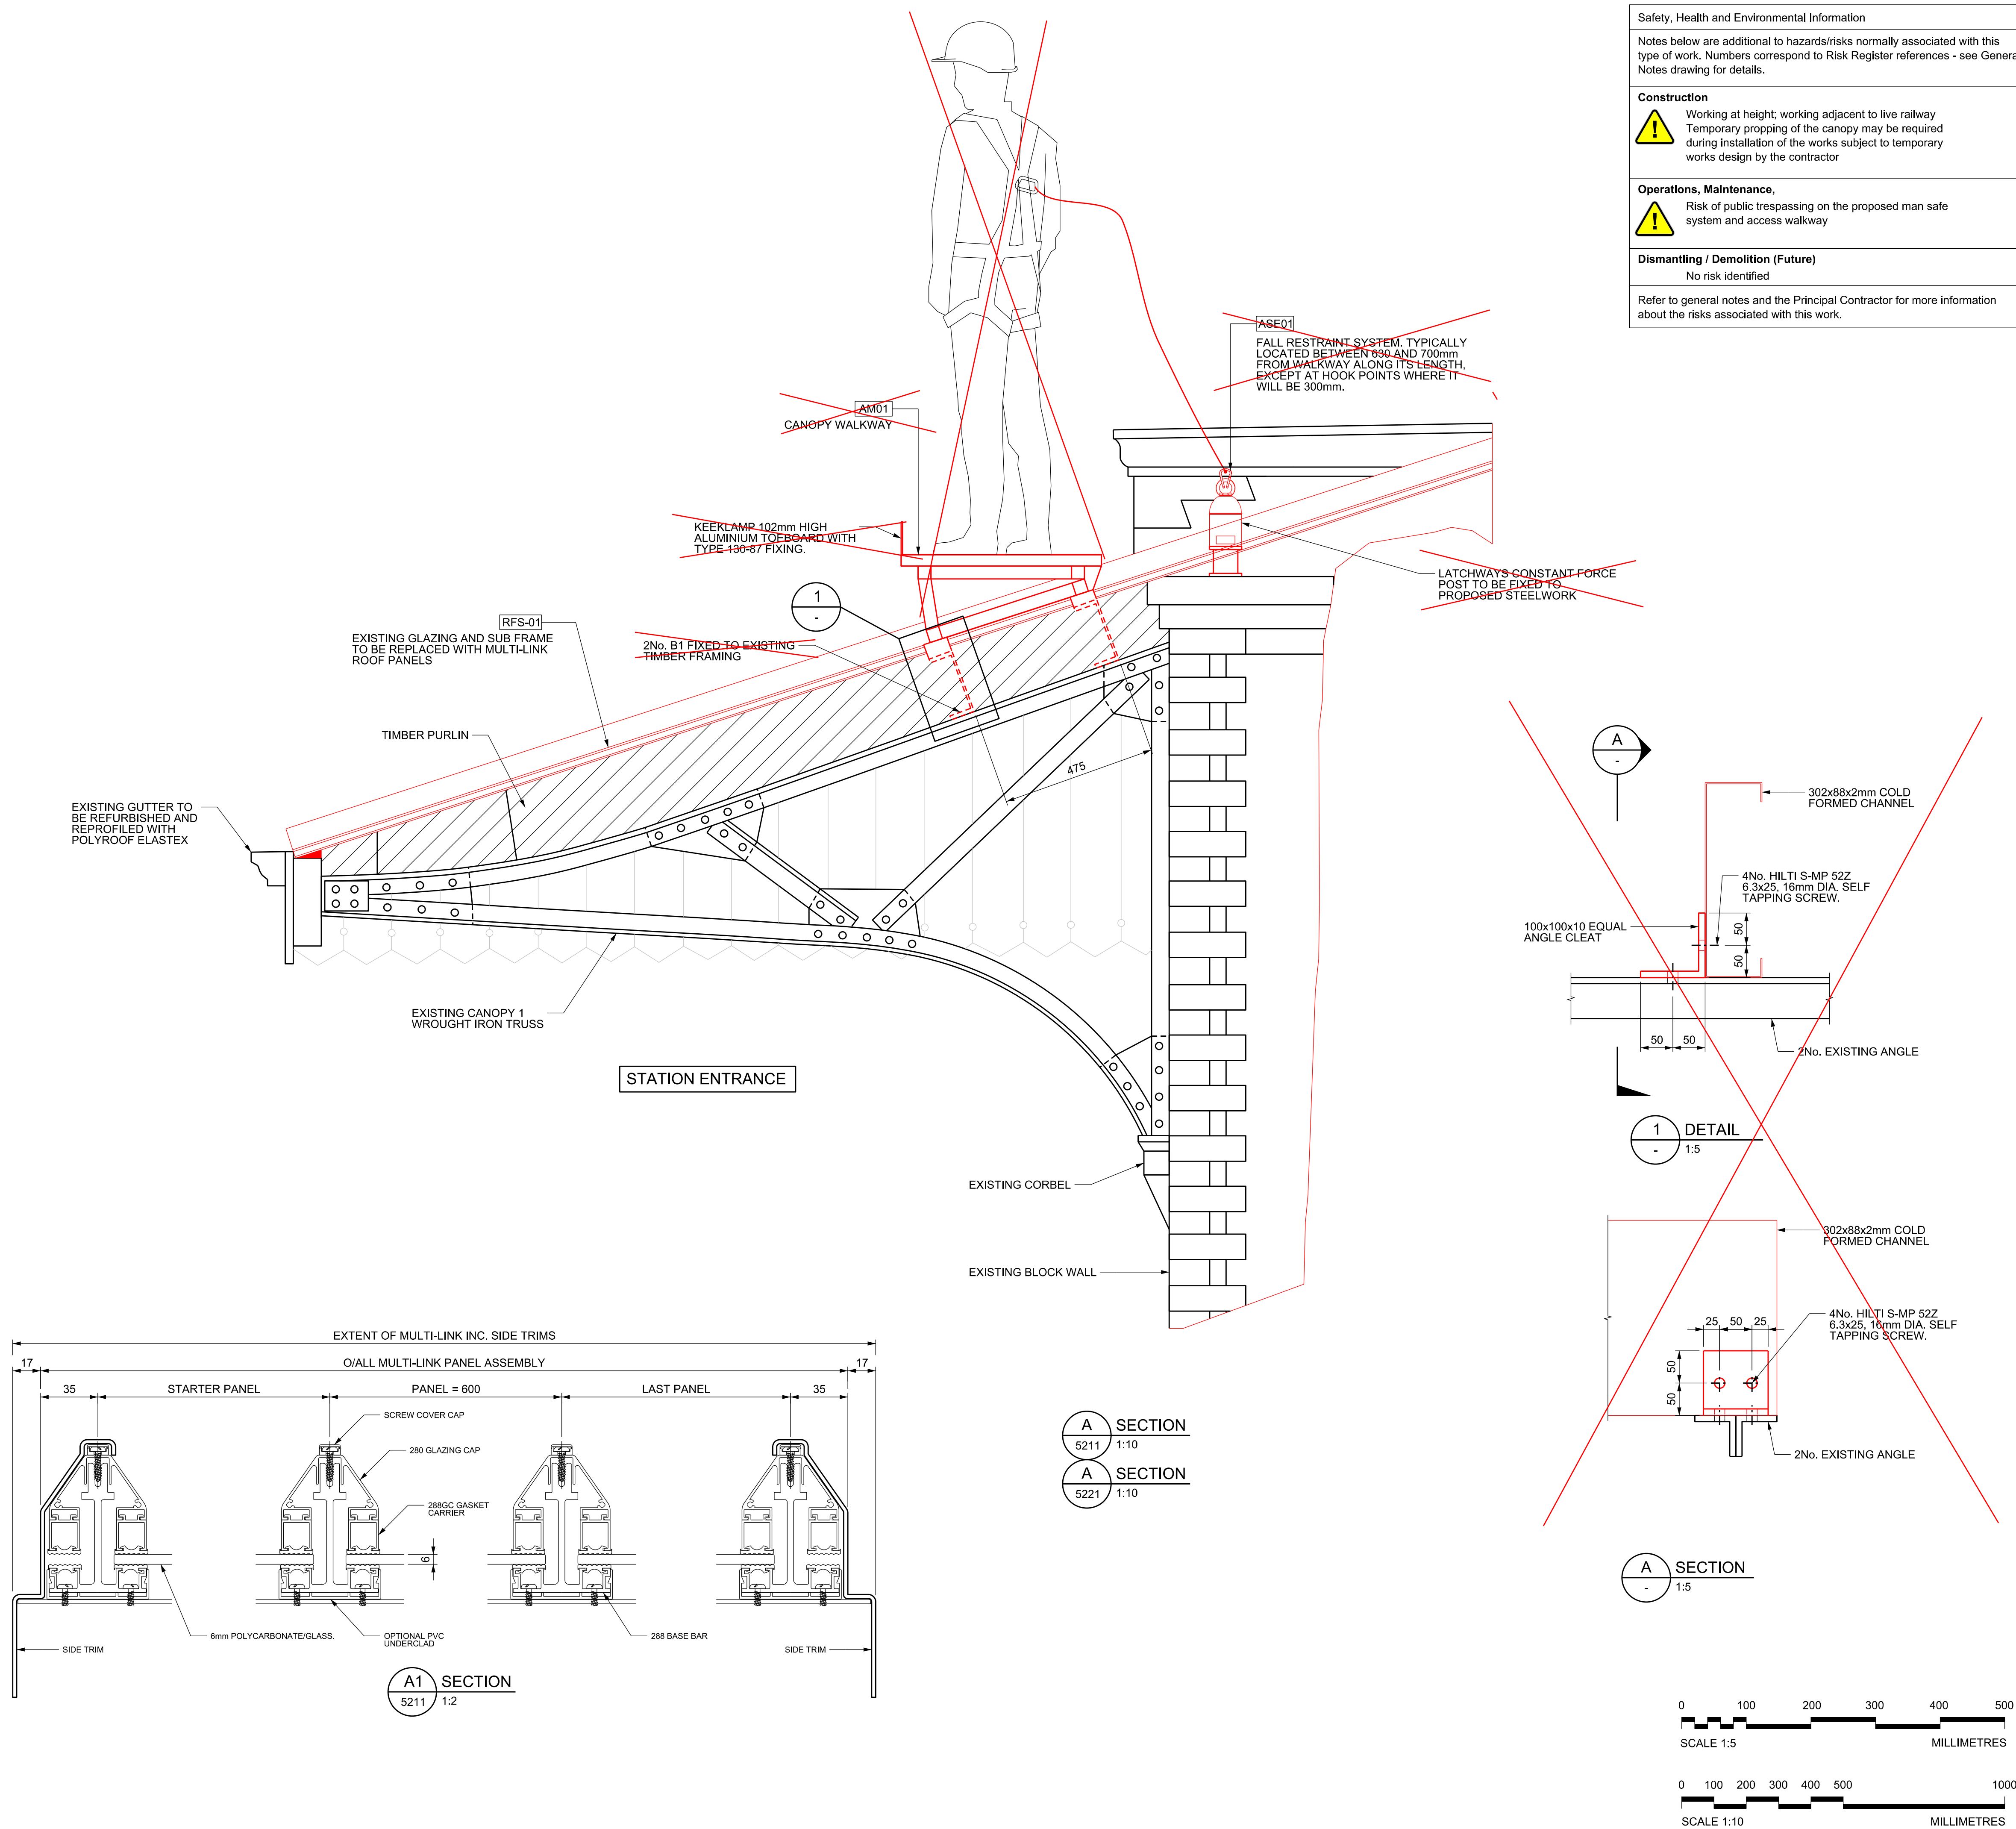


Safety, Health and Environmental Information	
Notes below are additional to hazards/risks normally associated with this type of work. Numbers correspond to Risk Register references - see General Notes drawing for details.	
Construction	Working at height; working adjacent to live railway Temporary propping of the canopy may be required during installation of the works subject to temporary works design by the contractor
Operations, Maintenance,	Risk of public trespassing on the proposed man safe system and access walkway
Dismantling / Demolition (Future)	No risk identified
Refer to general notes and the Principal Contractor for more information about the risks associated with this work.	

Legend/Notes

- THIS DRAWING IS TO BE READ IN CONJUNCTION WITH THE GENERAL NOTES DRAWING No. 30002211-IDV-5000.
- DO NOT SCALE FROM THIS DRAWING.
- ALL DIMENSIONS ARE IN MILLIMETERS UNO.
- ALL LEVELS ARE IN METERS.
- ALL DIMENSIONS ARE TO BE CHECKED ON SITE BY THE CONTRACTOR PRIOR TO COMMENCEMENT OF WORKS.
- THE CONTRACTOR SHALL BE RESPONSIBLE FOR THE DESIGN OF ALL LOADING CONDITIONS RESULTING FROM THE TEMPORARY WORKS ON THE CONSTRUCTION SEQUENCE.
- ANY NEW TIMBER TO BE TREATED WITH A CLEAR (PAINTABLE) PRESERVATIVE. ENSURING THAT THE NEW TIMBER IS PAINTED, UNDERCOATED AND TOP COATED USING A PRODUCT SIMILAR TO DELUX WEATHERSHIELD SYSTEM WITH THE COLOUR TO MATCH EXISTING.
- FOR SITE DRILLING INTO NEW AND OLD STEEL ELEMENTS ENSURE A CORROSION INHIBITOR (FOSROC/GALVA/FROID OR SIMILAR APPROVED) IS USED. CONTRACTOR TO FOLLOW MANUFACTURER'S INSTRUCTIONS.
- GEOMETRIC SURVEY OF EXISTING ELEMENTS WERE NOT UNDERTAKEN. THE DESIGN IS BASED ON INTERPRETATION OF ARCHIVE AND RECORD AS BUILT DRAWINGS. ACCURACY OF THIS INFORMATION SHALL BE DETERMINED BY THE CONTRACTOR AT TENDER OR INCEPTION OF GRIP 6 STAGE.



BEAM SCHEDULE	
REF.	BEAM TYPE
B1	302x88x2 Cold Formed Channel

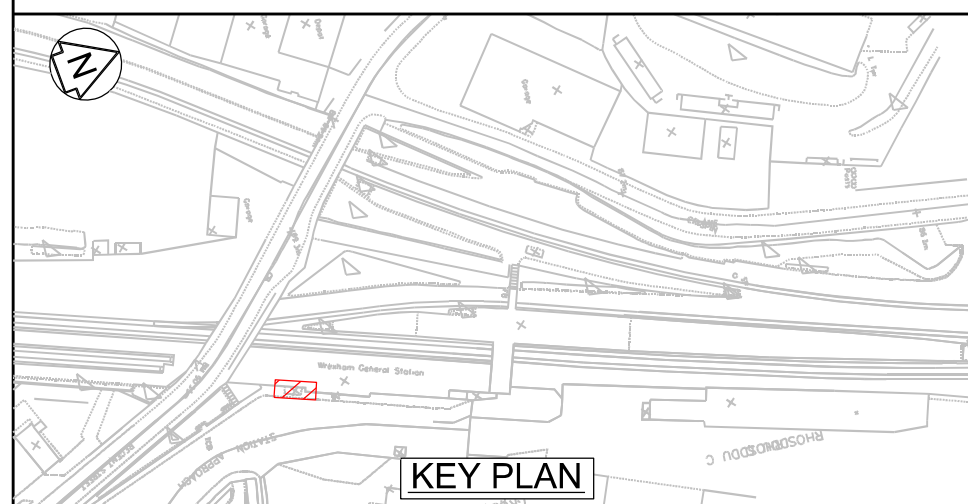

Rev	Date	Description of Revisions	Drawn	Chkd	Appr
C01	29/06/2020	Issued As Fit for Construction	JD	HL	JH
B03	28/05/2020	Revised to incorporate new glazing at canopies 2 and 3	JD	HL	JH
B02	30/04/2020	Issued to incorporate comments from IDC	JD	HL	JH
B01	19/02/2020	Issued for IDC	JD	HL	JH

Status	FIT FOR CONSTRUCTION				Suitability
					A



NETWORK RAIL
4th FLOOR
ST PATRICK HOUSE
CARDIFF
CF10 5ZA

BakerHicks

BakerHicks
24 Chiswell St
London
EC1Y 4TY
T. 020 75491300
www.baker-hicks.com

© Copyright

Project No.	30002211
Project	WREXHAM GENERAL STATION
Grip Stage	GRIP 5

Drawing Title	SECTION CANOPY 1 SHEET 1
---------------	--------------------------------

Designed	A.Stamenkovic	Signed	<i>A. Stamenkovic</i>	Date	29/06/2020
Drawn	J.Dowd	Signed	<i>J. Dowd</i>	Date	29/06/2020
Checked	H.Lokman	Signed	<i>H. Lokman</i>	Date	29/06/2020
Approved	J.Hall	Signed	<i>J. Hall</i>	Date	29/06/2020

Scale(s)	1:10	ELR & Mileage	WSJ2 201m 66ch
----------	------	---------------	----------------

Drawing number	30002211-IDV-5250	Revision	C01
----------------	-------------------	----------	-----