



Spare Parts Container
Top View
1:50

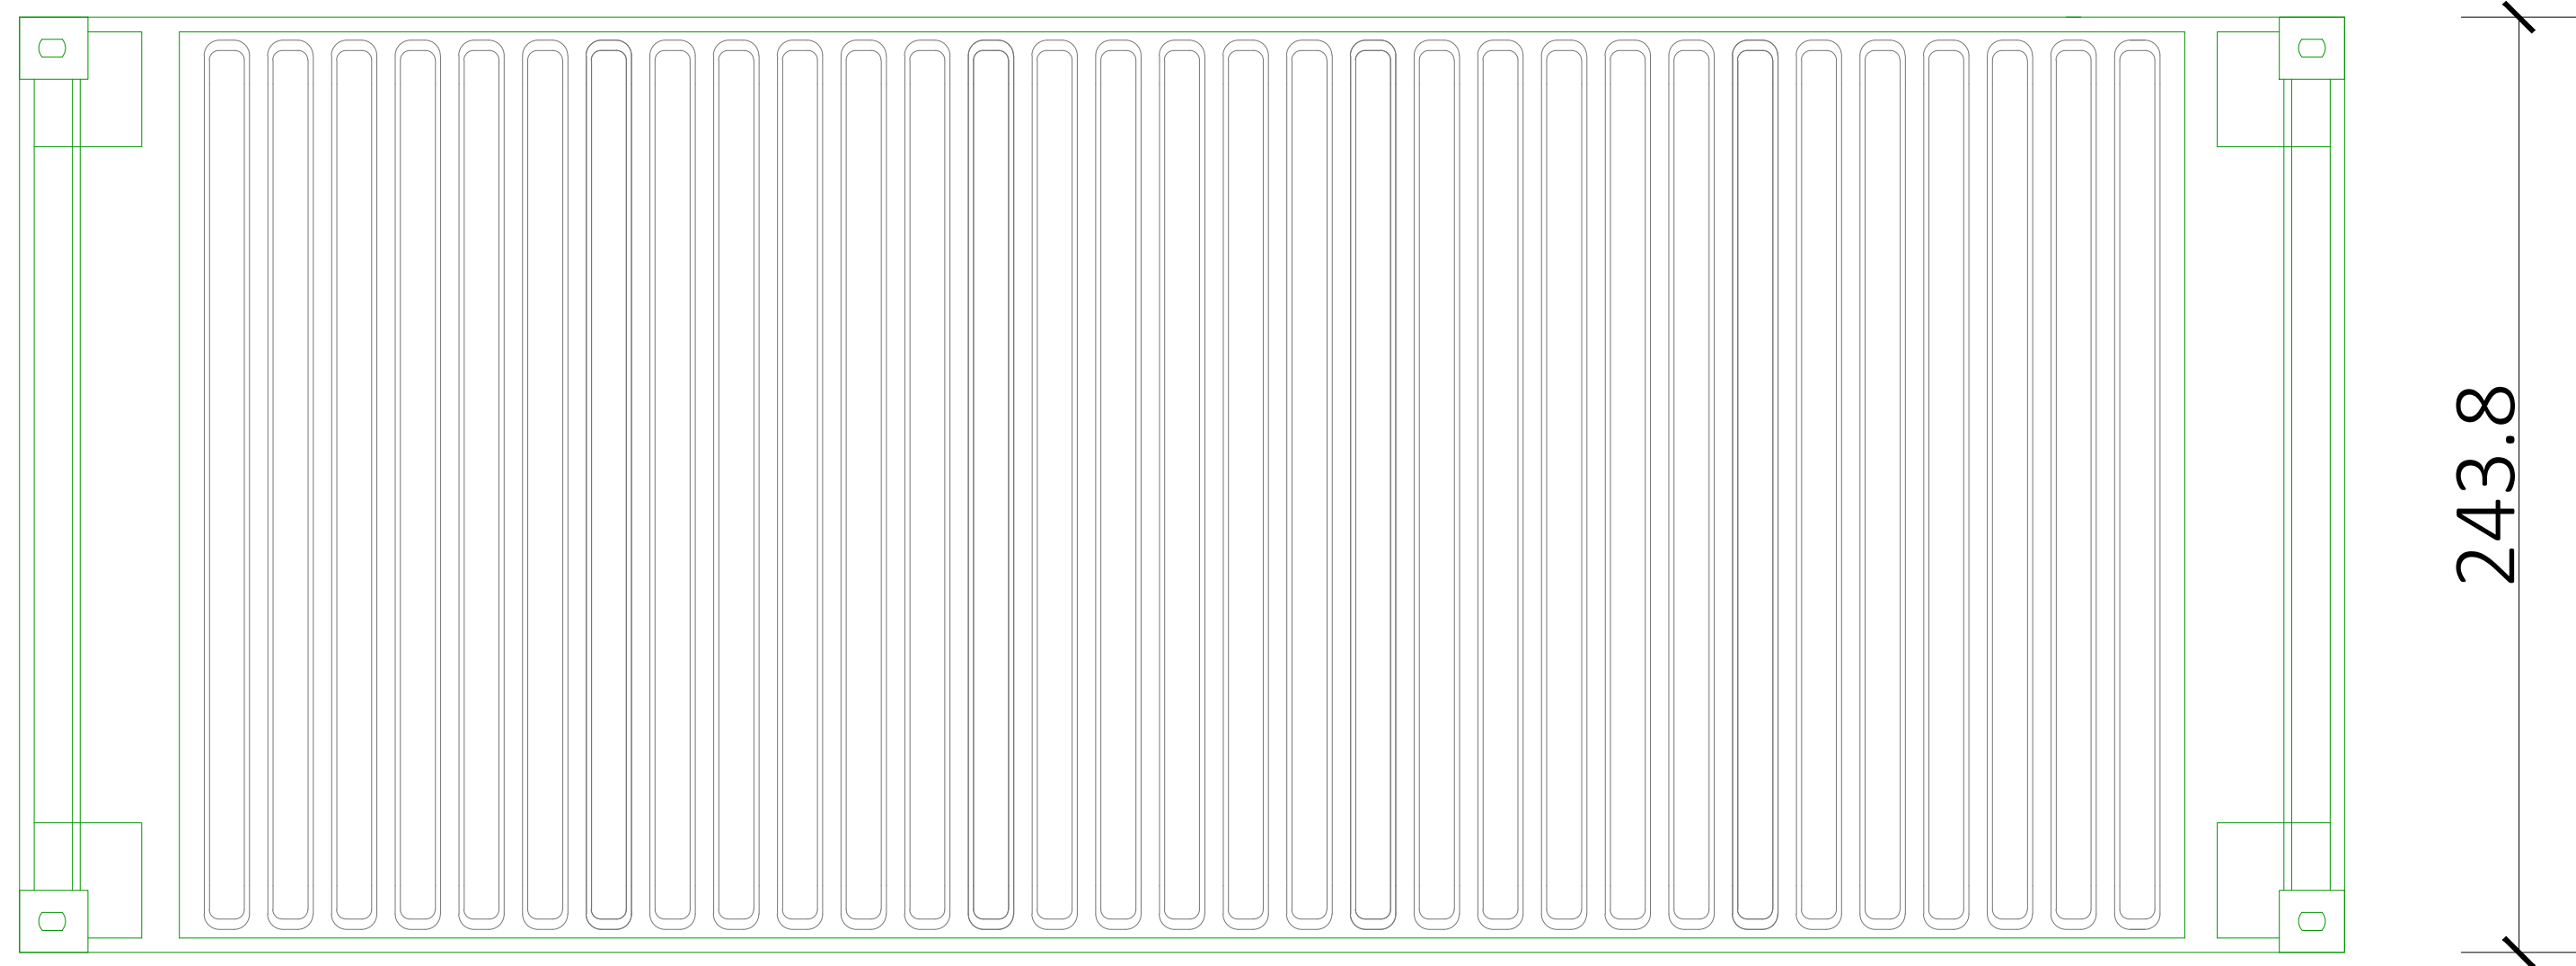


Spare Parts Container
Front View
1:50

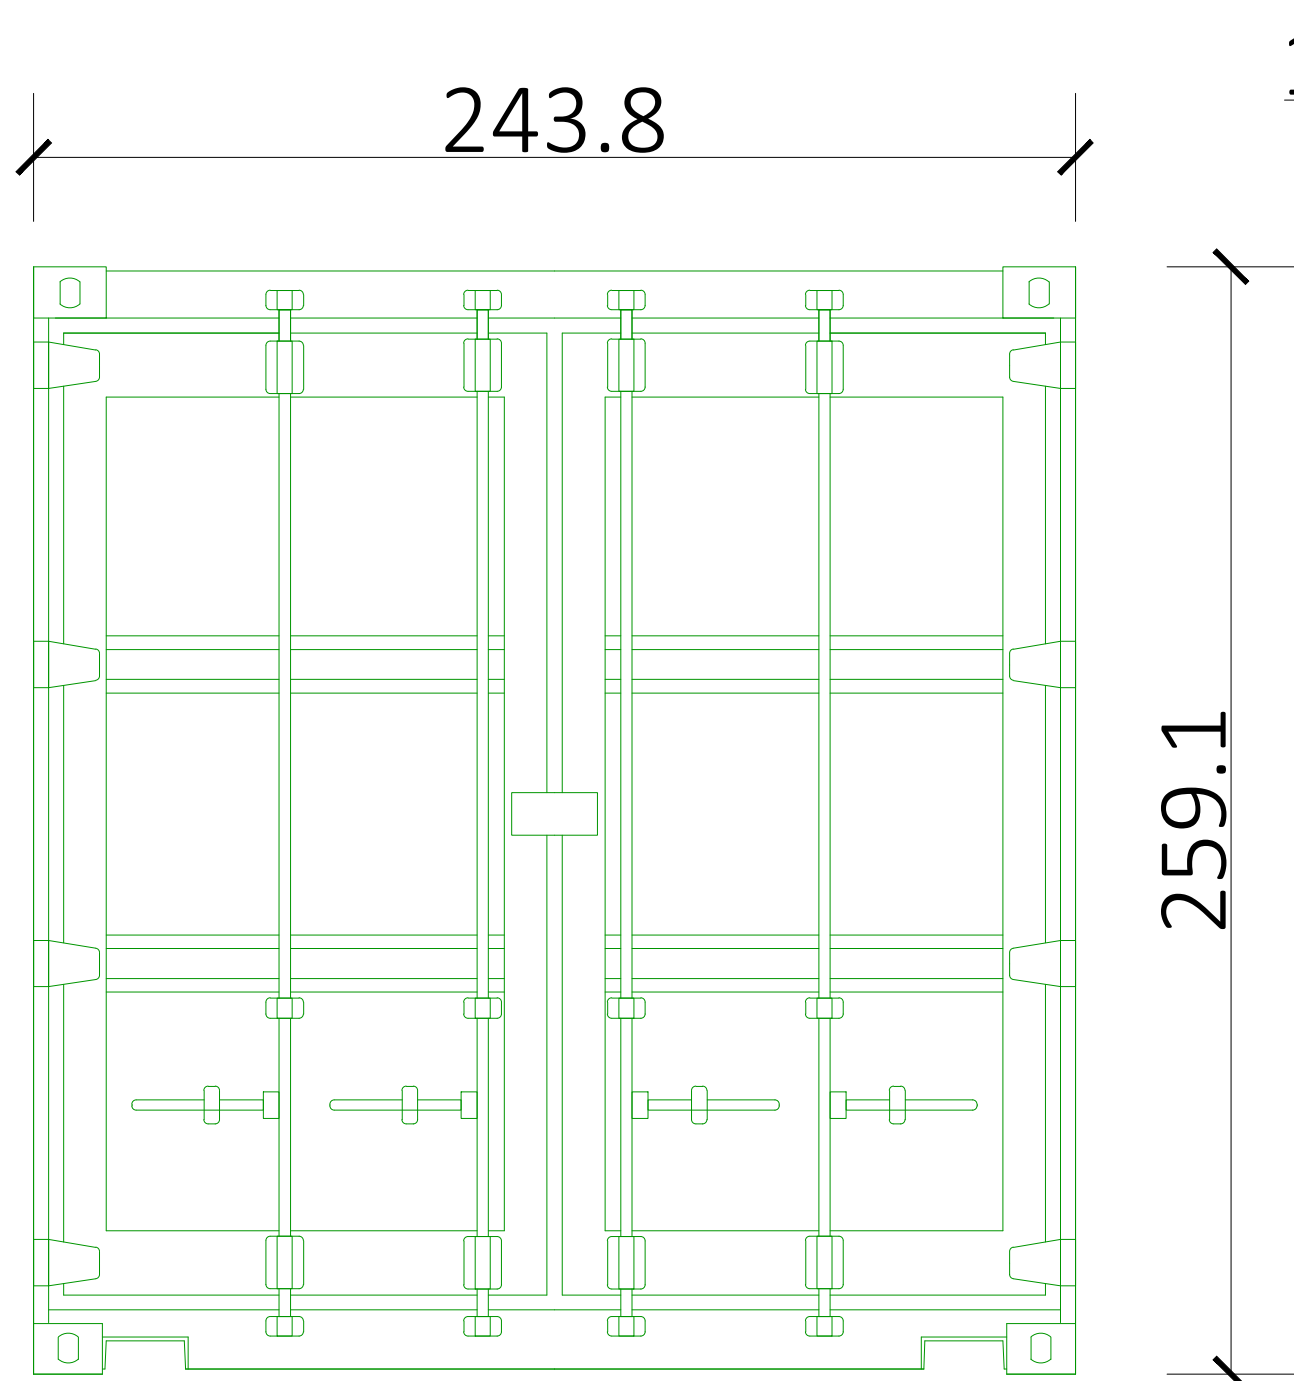

Spare Parts Container
Side View
1:50



Spare Parts Container
Back View
1:50

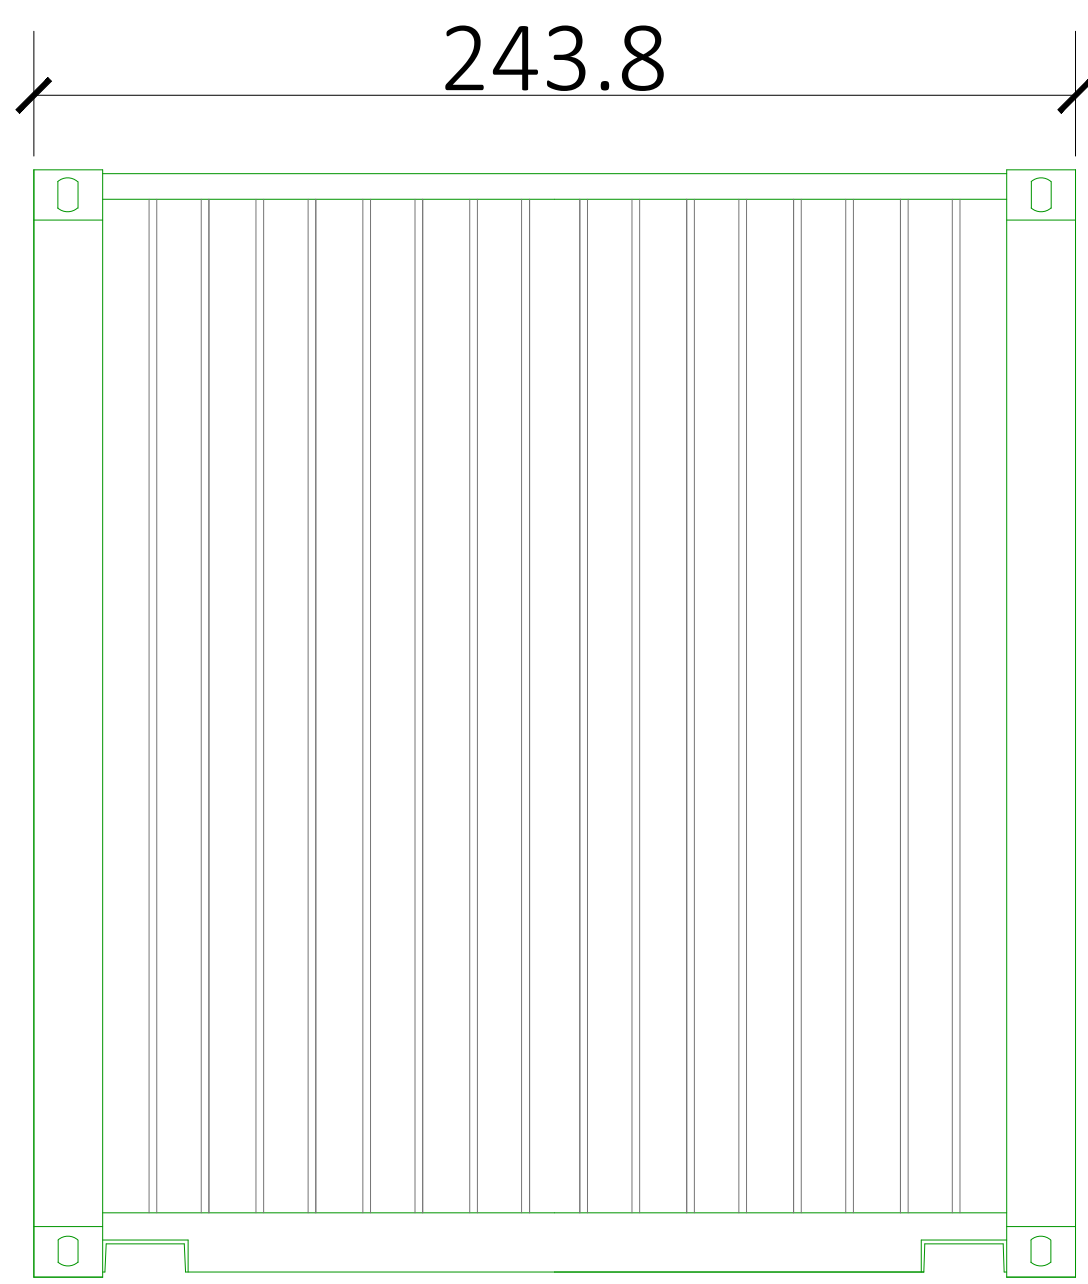

No.:	Date:	Revision:	El.:	AS-BUILT			
01	21.01.2020	Created		Pickhill		United Kingdom	
				Drawing number: A0B0C01		Scale:	Paper size:
				Date:	Name:	As Shown	A3
				Draw:	21.01.2020	Spare Parts Container	
				Check:	21.01.2020		
					Ioana Berfela		
					Andrei Popa		



GREENCELLS
GROUP

Address: Germany, Saarbrücken, Bahnhof Street, no. 28, 66111
Phone: +49 (0) 681 992 669 0
Fax: +49 (0) 681 992 669 20
E-mail: info@greencells.com
Web: www.greencells.de