

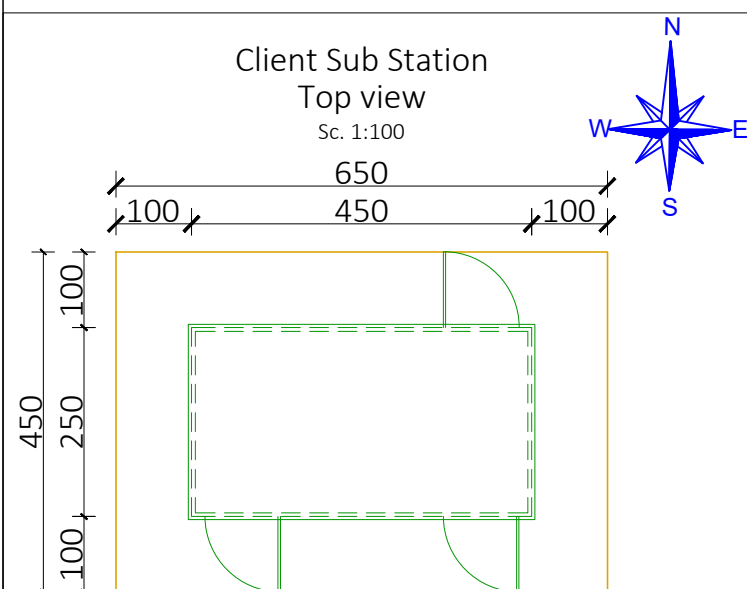
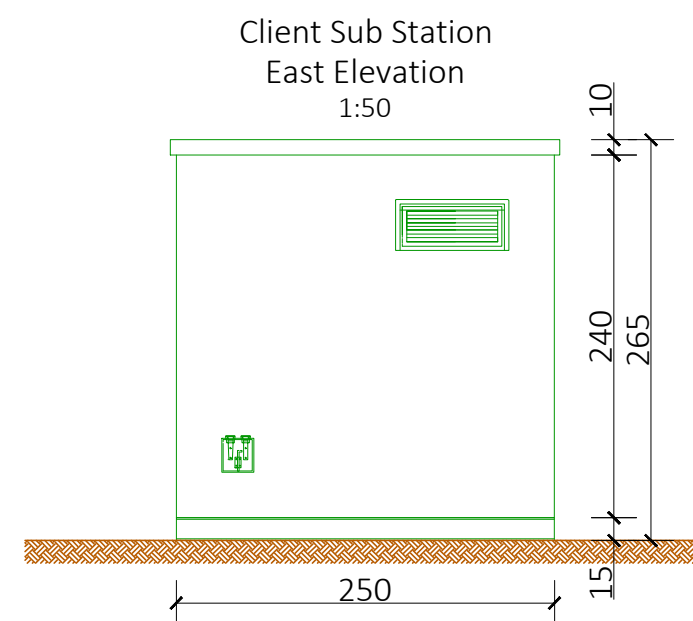
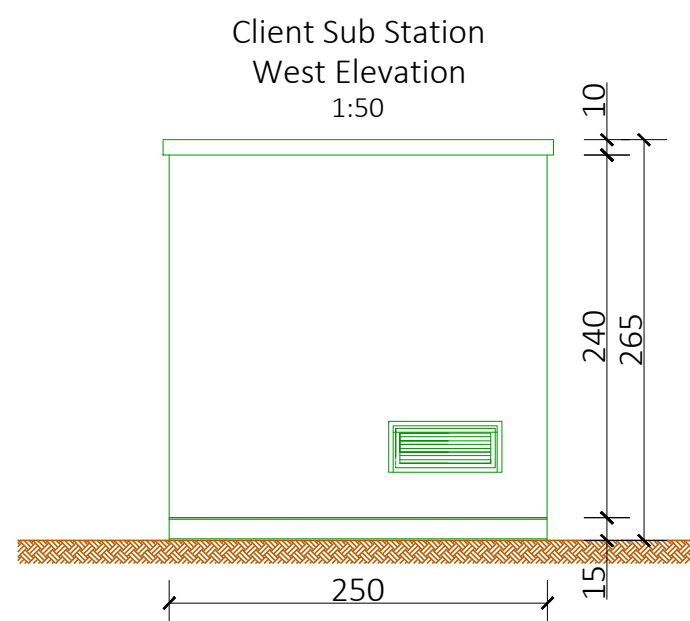


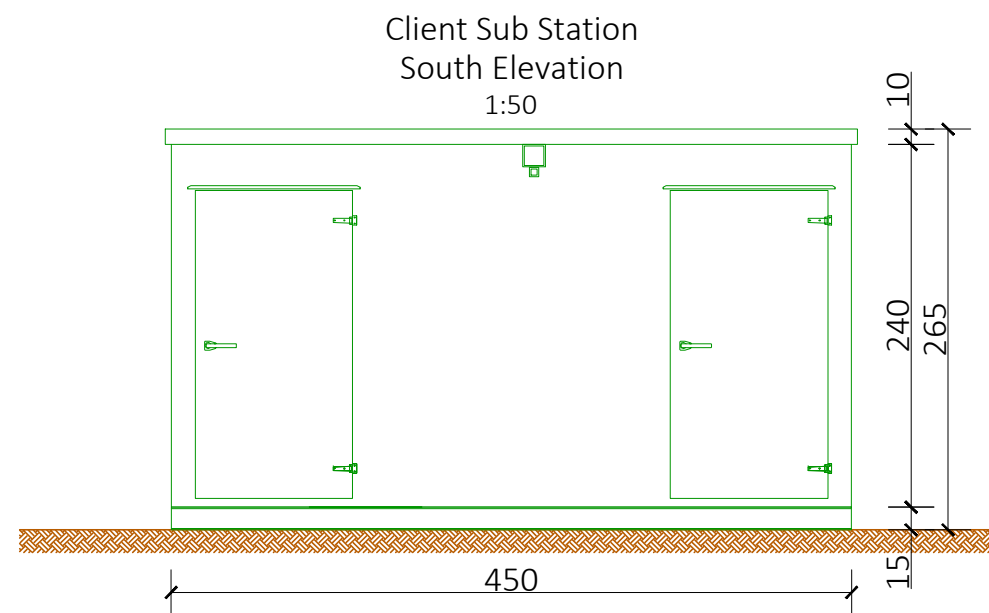

No.:	Date:	Revision:	El.:	AS-BUILT				
01	12.05.2020	Created						
				Pickhill			United Kingdom	
				Drawing number: A0B0C01			Scale:	Paper size:
					Date:	Name:	As Shown	A3
				Draw:	12.05.2020	Ioana Berfela	CSS Elevations	
				Check:	12.05.2020	Andrei Popa		

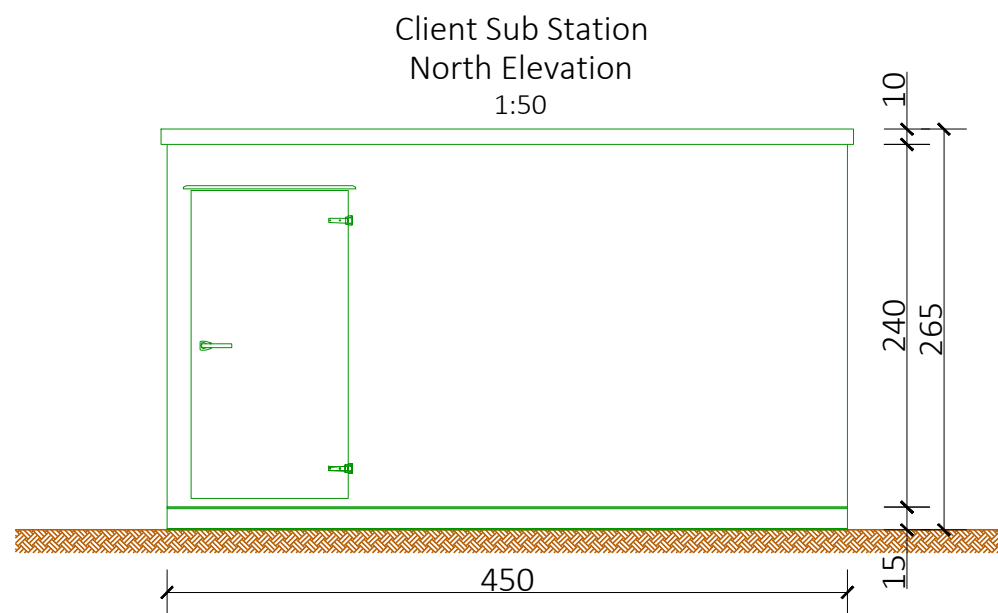

Address: Germany, Saarbrücken, Bahnhof Street, no. 28, 66111
Phone: +49 (0) 681 992 669 0
Fax: +49 (0) 681 992 669 20
E-mail: info@greencells.com
Web: www.greencells.de