





Front Elevation 1:100

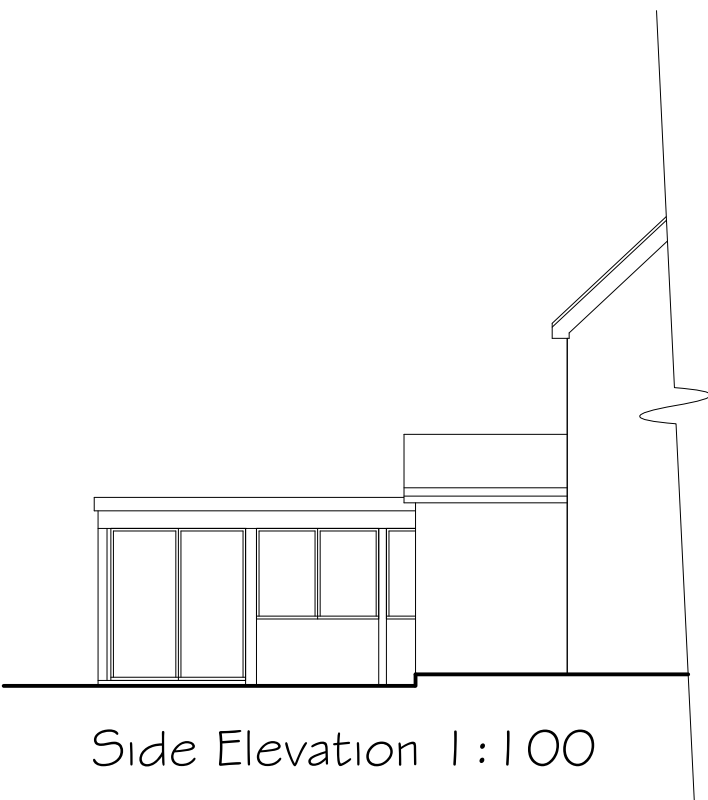


Side Elevation 1:100

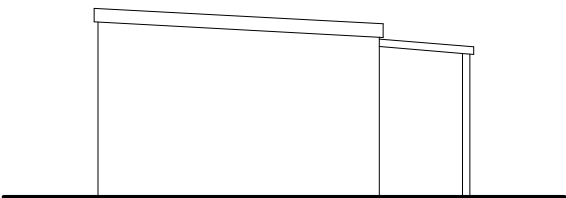

Office Rear Elevation 1:100



Side Elevation 1:100

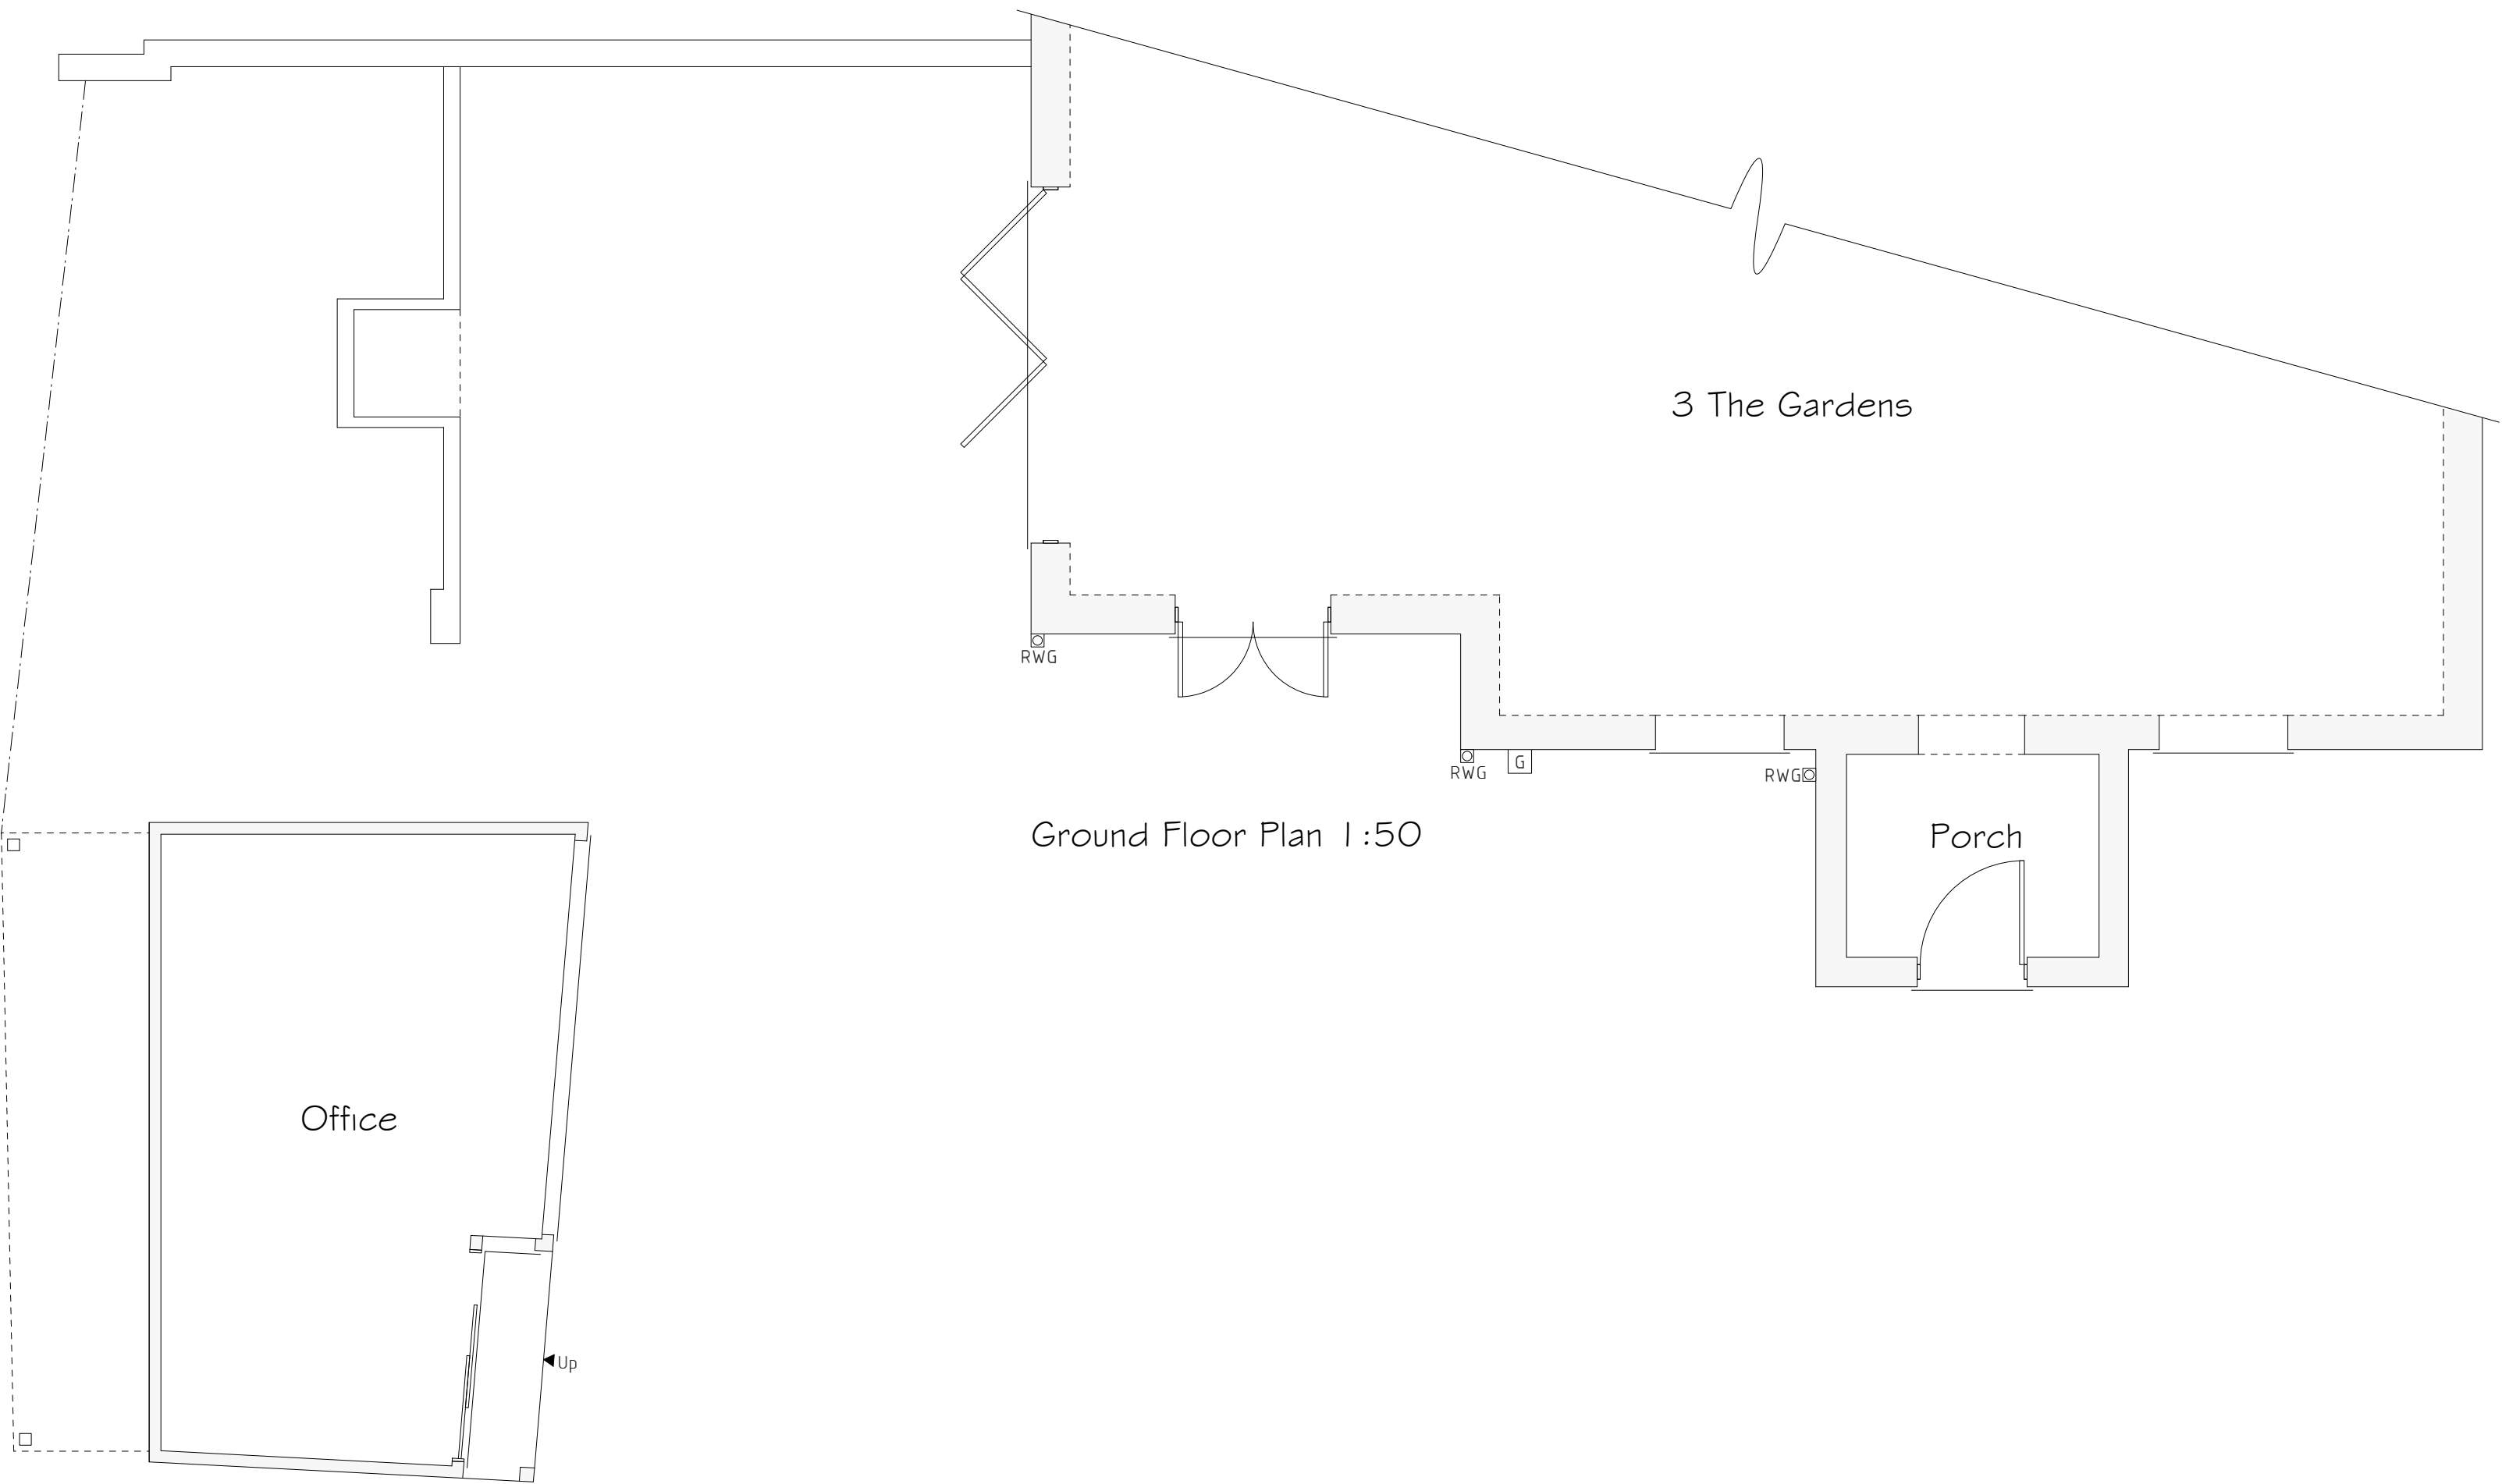

Ground Floor Plan 1:50

Services Key			
	Existing Gas Meter Position		
	Existing Rain Water Gully (RWG) Position		

Rev	Date	Detail	Initial

Project: Application in Retrospect at, 3 The Gardens, Holt, Wrexham, LL13 9JW.	
Title: As Built	Scale: (A1) 1:50 & 1:100

Drawn By: E.M.Jackson	Date: Nov 2020
Drawing No: G081/002	Sheet: 1 of 1

Office 3K4,
Redwither Business Tower,
Wrexham. LL13 9XT
Tel: 01978 356500
www.blueprintarchitectural.com
© copyright all rights reserved