


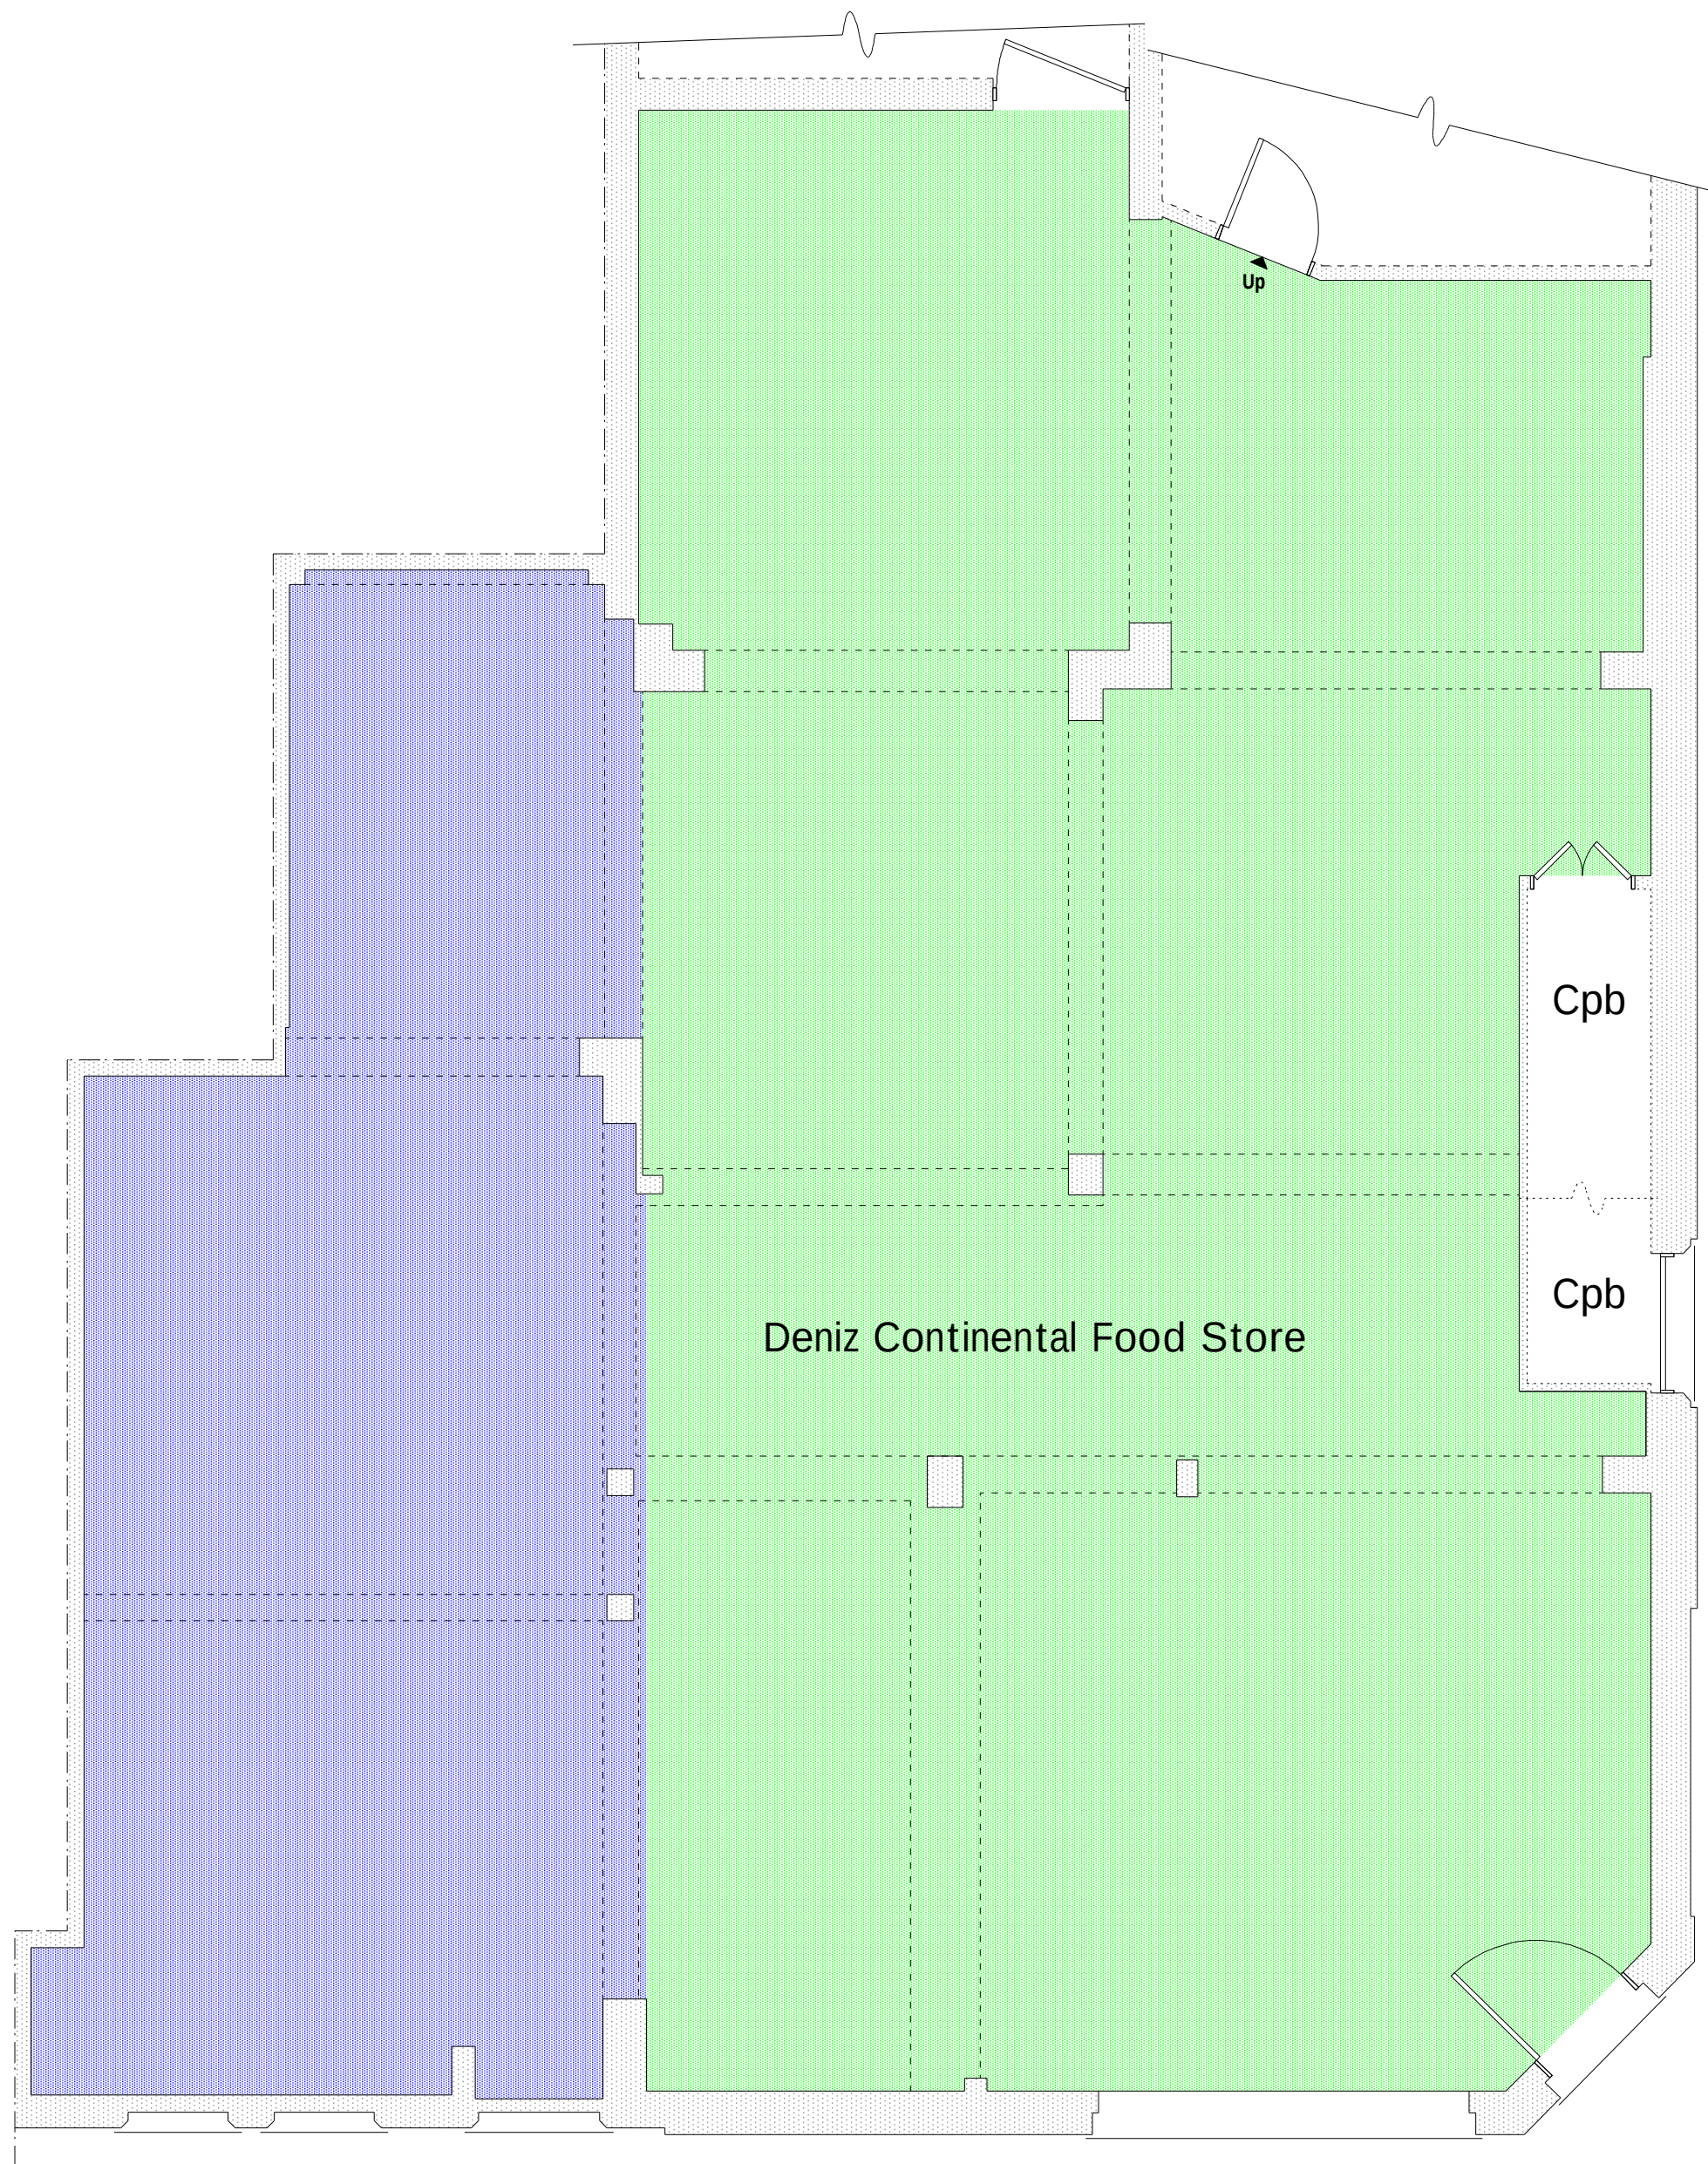


Ground Floor Plan 1:50



Front Elevation 1:100



Side Elevation 1:100

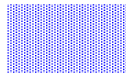KEY	
	A1 Retail area of 31 Ruabon Road 105m ²
	A1 Retail area of 29 Ruabon Road 43m ²

A	11/19	Floor areas indicated	D.J.E.
Rev	Date	Detail	Initial

Project:
Proposed Alterations at,
31 Ruabon Road,
Wrexham,
LL13 7NY

Title: As Built Plan	Scale: (A2) 1:50 & 1:100
-------------------------	--------------------------------

Drawn By: E.M.Jackson	Date: Sep 2019
--------------------------	-------------------

Drawing No: B138/002	Sheet: 1 of 1
-------------------------	------------------

blueprint
architectural services

 Office 3K4,
Redwither Business Tower,
Wrexham. LL13 9XT
Tel: 01978 356500
www.blueprintarchitectural.com
© copyright all rights reserved