
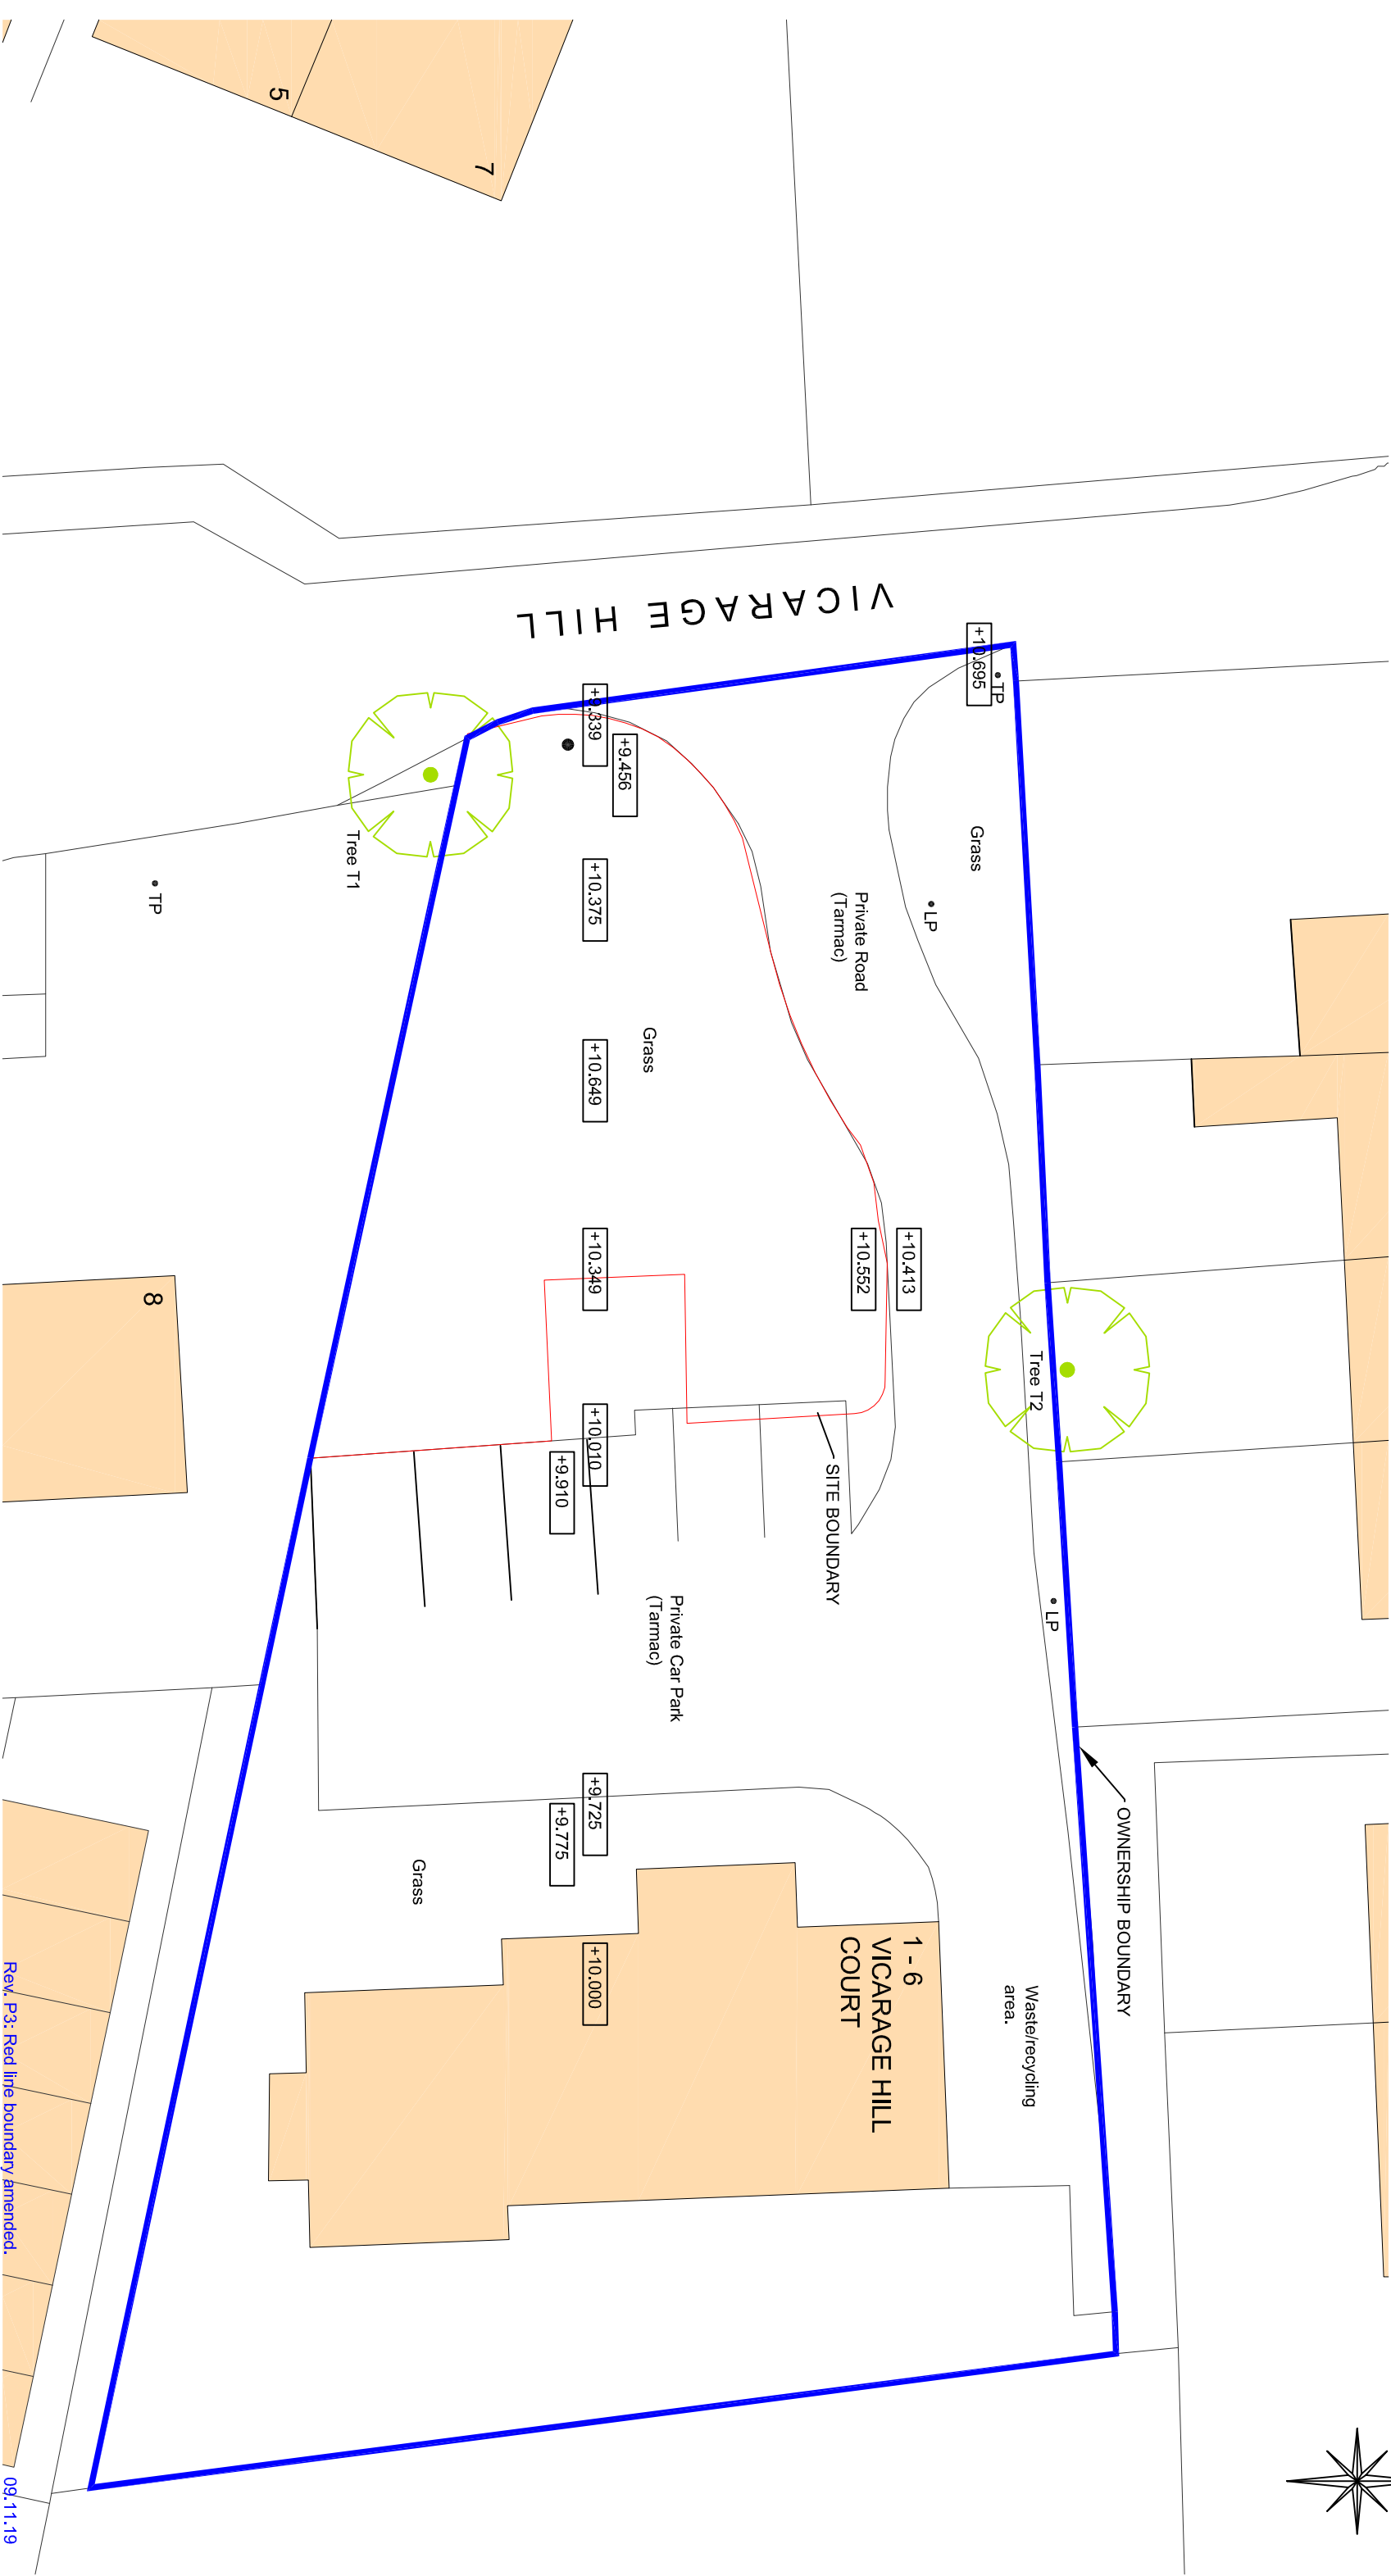


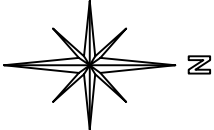

Rev. P3: Red line boundary amended.
Rev. P2: Topographical information added.
Rev. P1: First Issue.

09.11.19
15.02.18
15.02.18

Project:
New Dwelling, Vicarage Hill, Mineira

Client:
DMR (North Wales) Ltd.

Drawing Title:
EXISTING SITE PLAN

Drawn:
CB

Date:
13.02.18

Scale:
1:200 @A3

Job No:
P578

Drawing No:
101

Revision:
P3

Barron Design Limited
Academy Bunglow
Holt
Wrexham
LL13 9YL
07793 558336
enquiries@barrondesign.co.uk

