
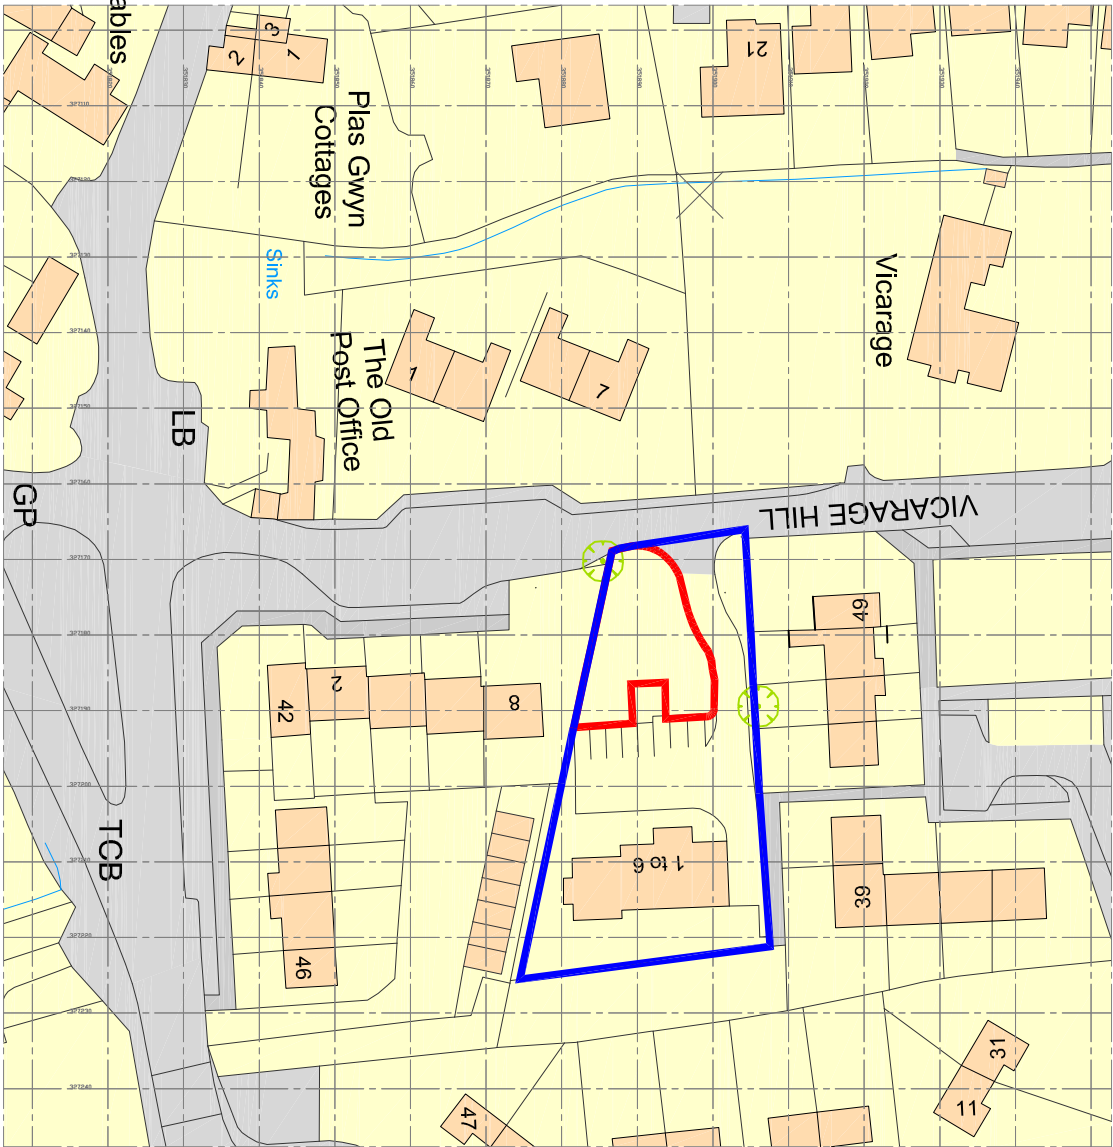


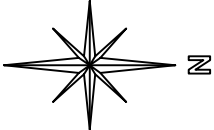

Ordnance Survey, (c) Crown Copyright 2018. All rights reserved. Licence number 100022432

Rev. P2: Red line boundary amended
Rev. P1: First Issue.

09.11.19
15.02.18

Project:		Barron Design Limited	
Client:		Academy Bungdow	
Drawing Title:		Holt	
Scale:		Wrexham	
Job No:		LL13 9YL	
Drawing No:		07793 558336	
Revision:		enquiries@barrondesign.co.uk	

