



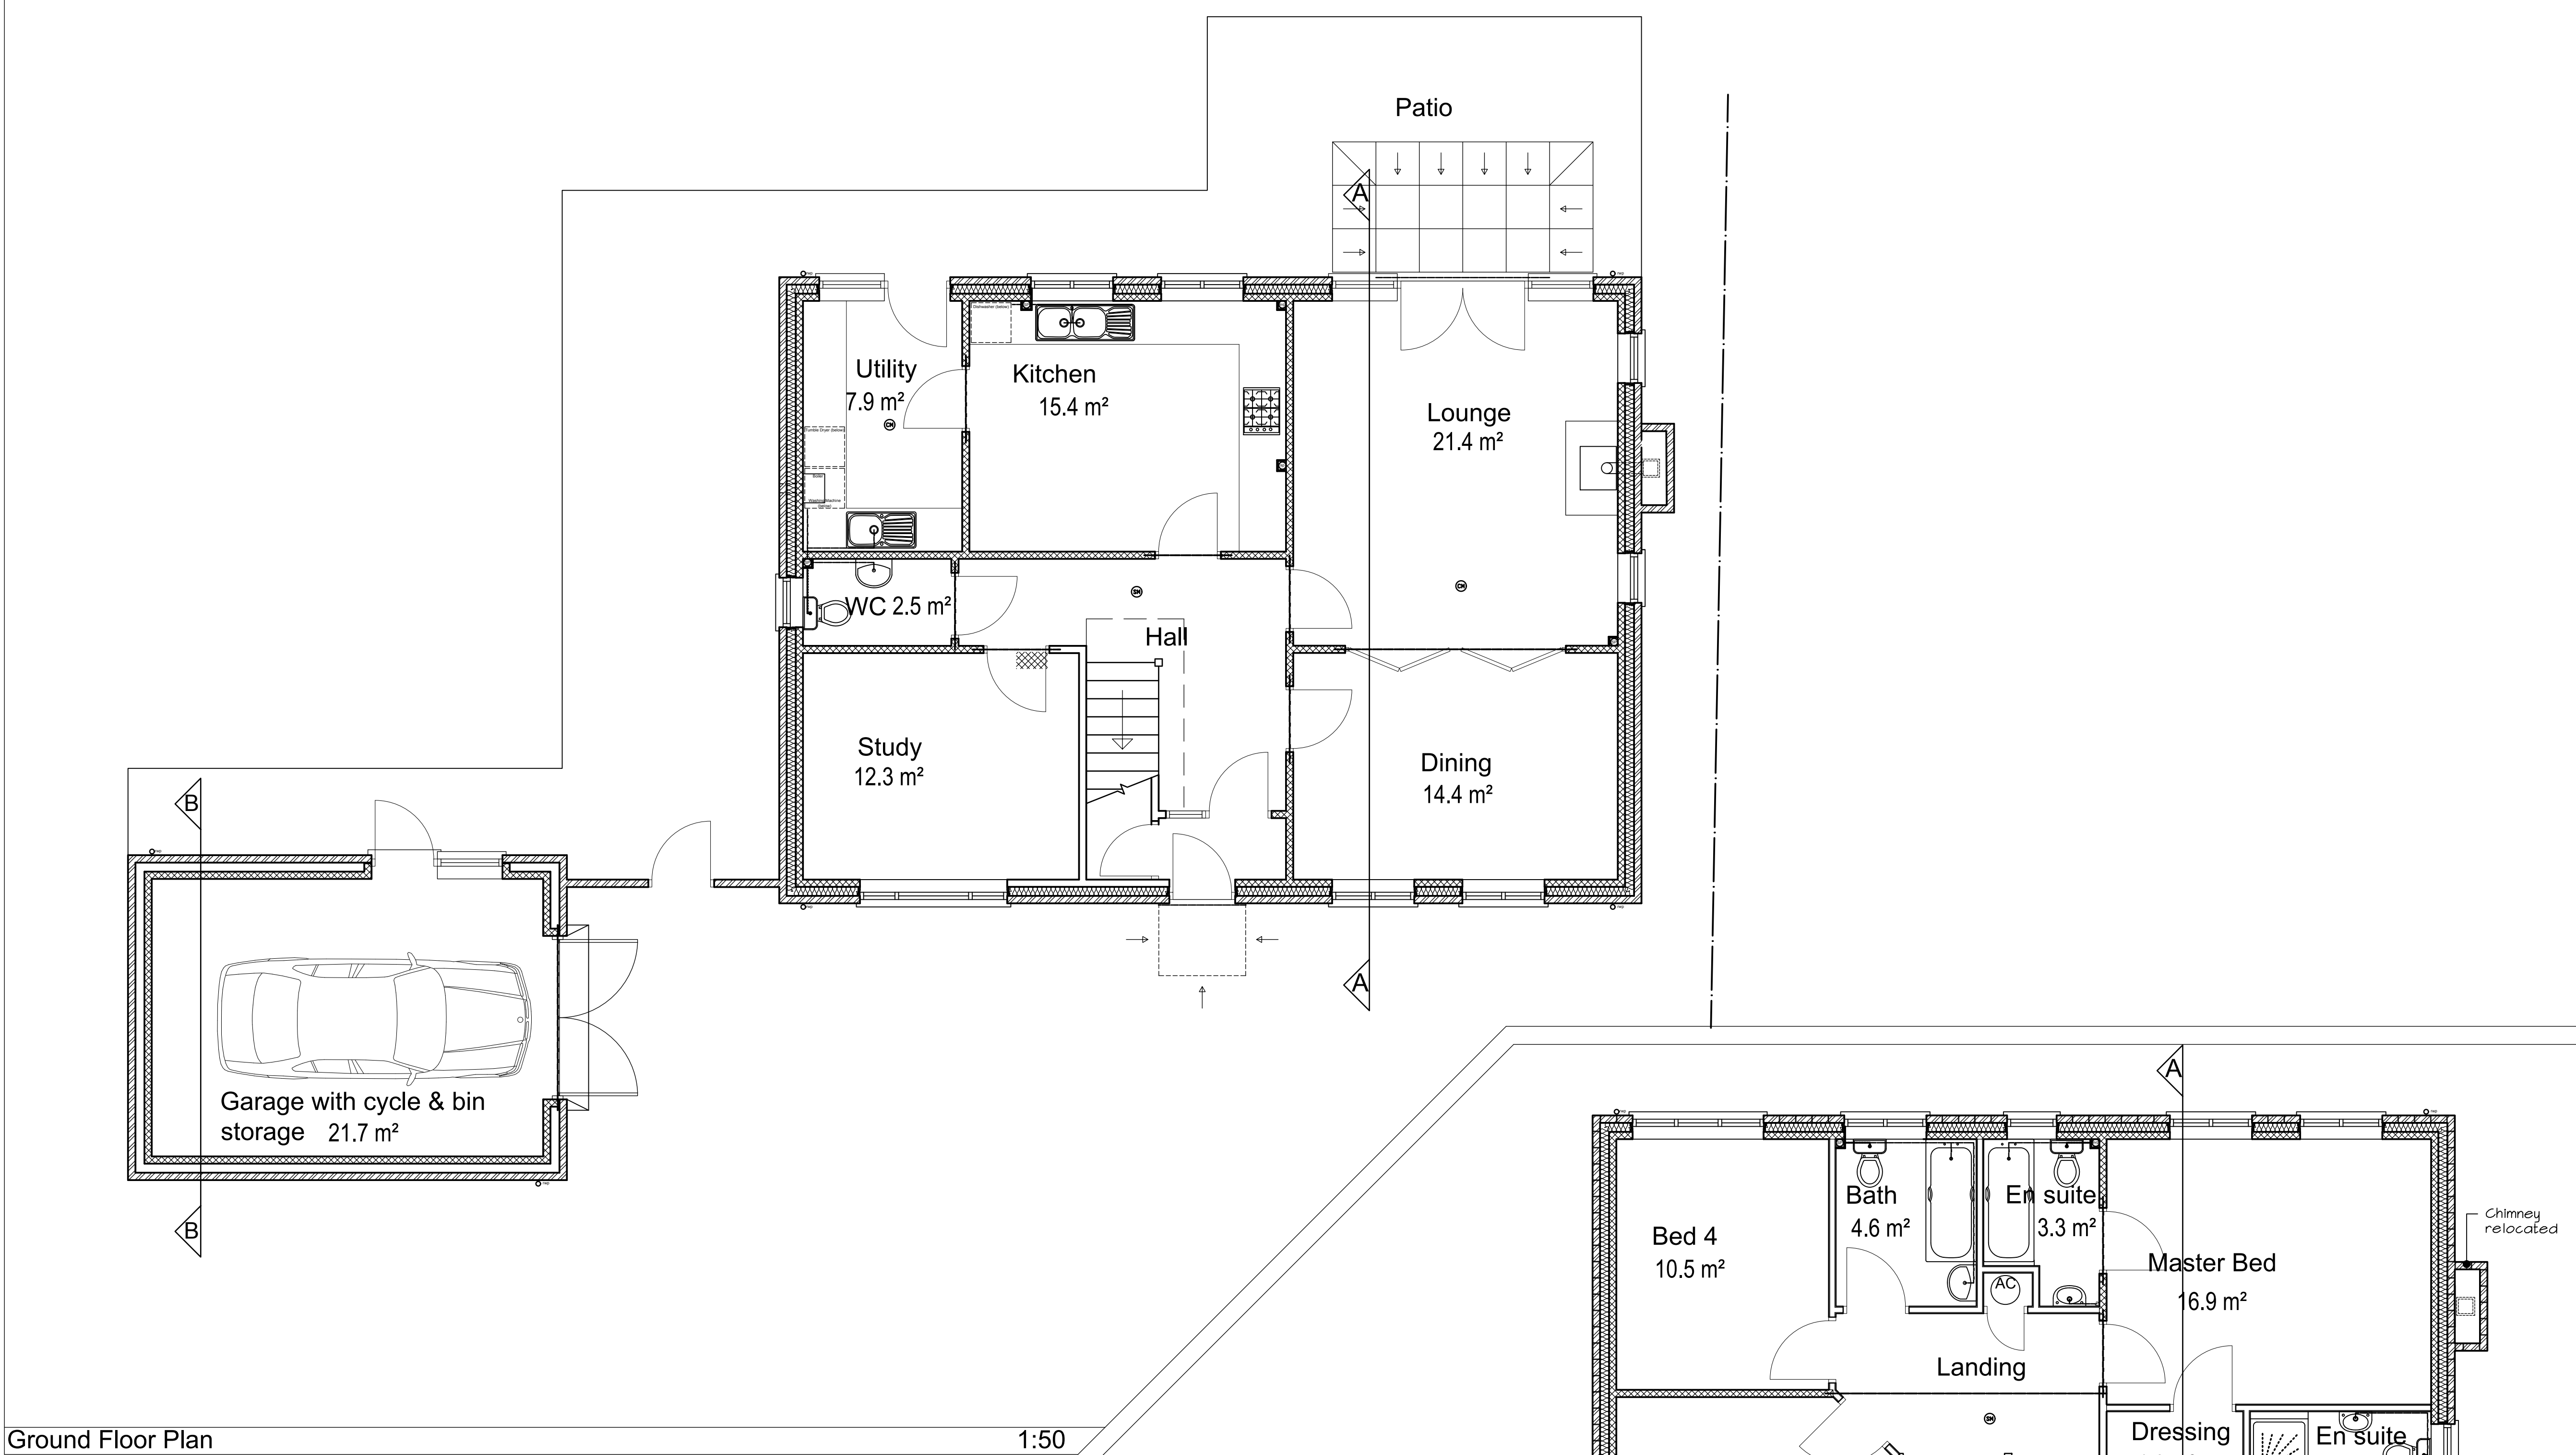

Ground Floor Plan

1:50

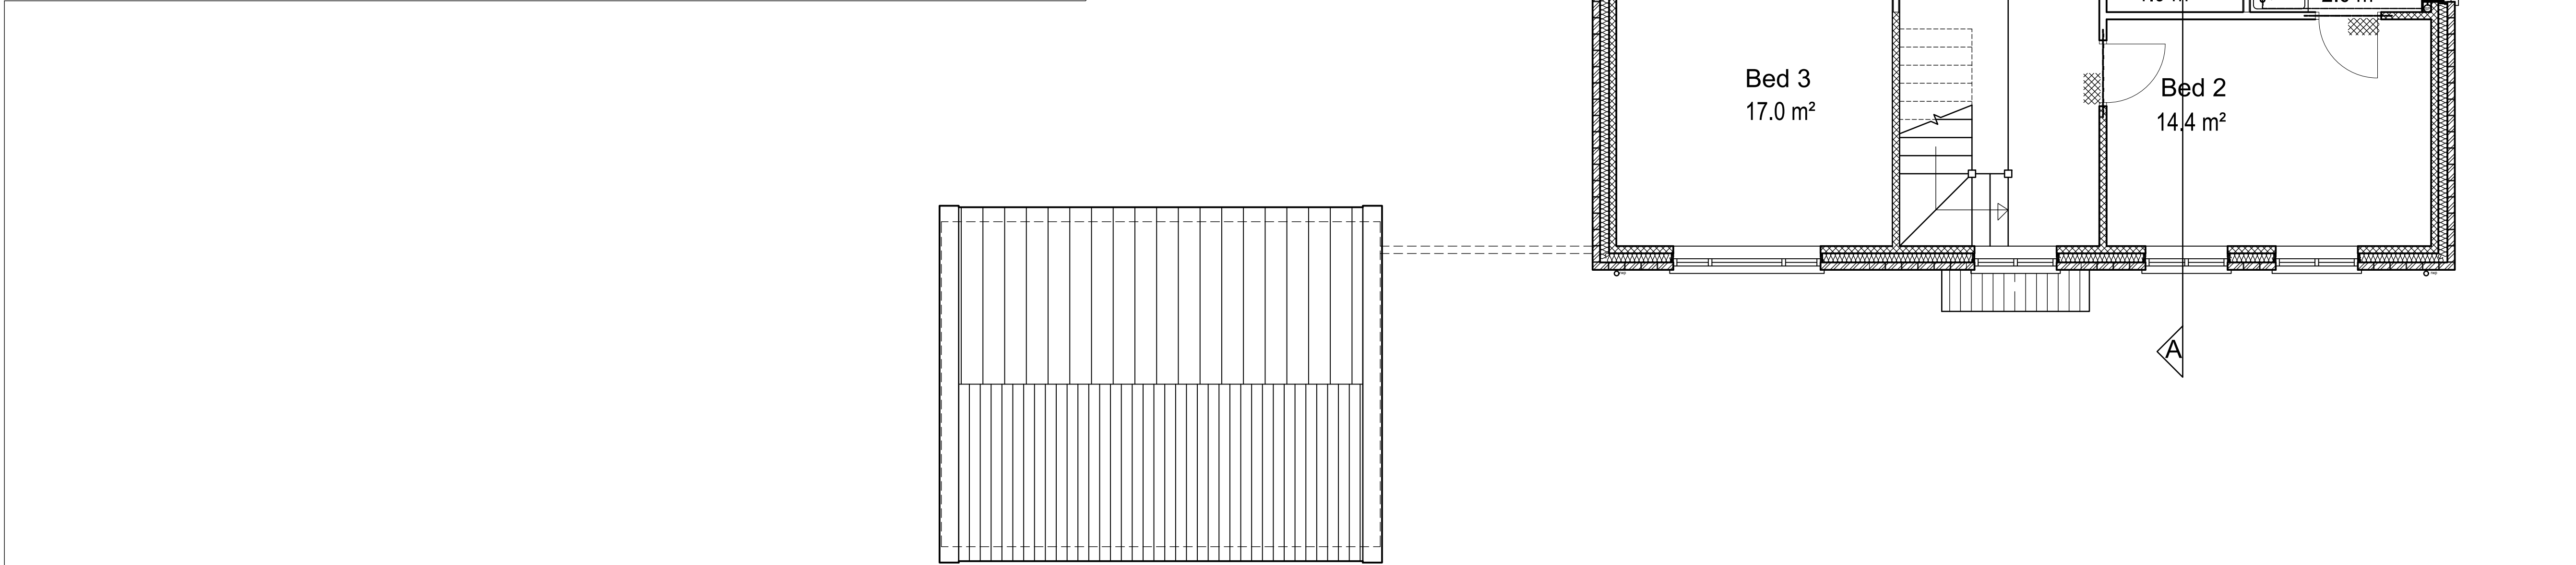

First Floor Plan

1:50

All as per planning approval unless noted.

B	Planning Application	01.12.17	ACM
A	Amended to suit on site "As Built" by contractor to now include increased chimney size	31.03.17	ACM
--	Submitted to Planning for as built amendments	10.03.17	ACM
rev	description	date	dr by
original by	A C Munro	24/08/2015	ACM

PLANNING



This drawing is to be read in conjunction with all related drawings. Do not scale from this drawing. All dimensions must be checked and verified on site before commencing any work or producing shop drawings. The originator should be notified immediately of any discrepancy.
This drawing is copyright and remains the property of Three 6 T Architecture
T: 07583 303 464. E: enquiries@three6t.co.uk

client	Mytton Homes		
project	The Orchards Overton		
project no	1507/005		
drawing title	Floor Plans Proposed		
scale	prefix	drawing No	rev
As shown @ A1	PL	216	B