


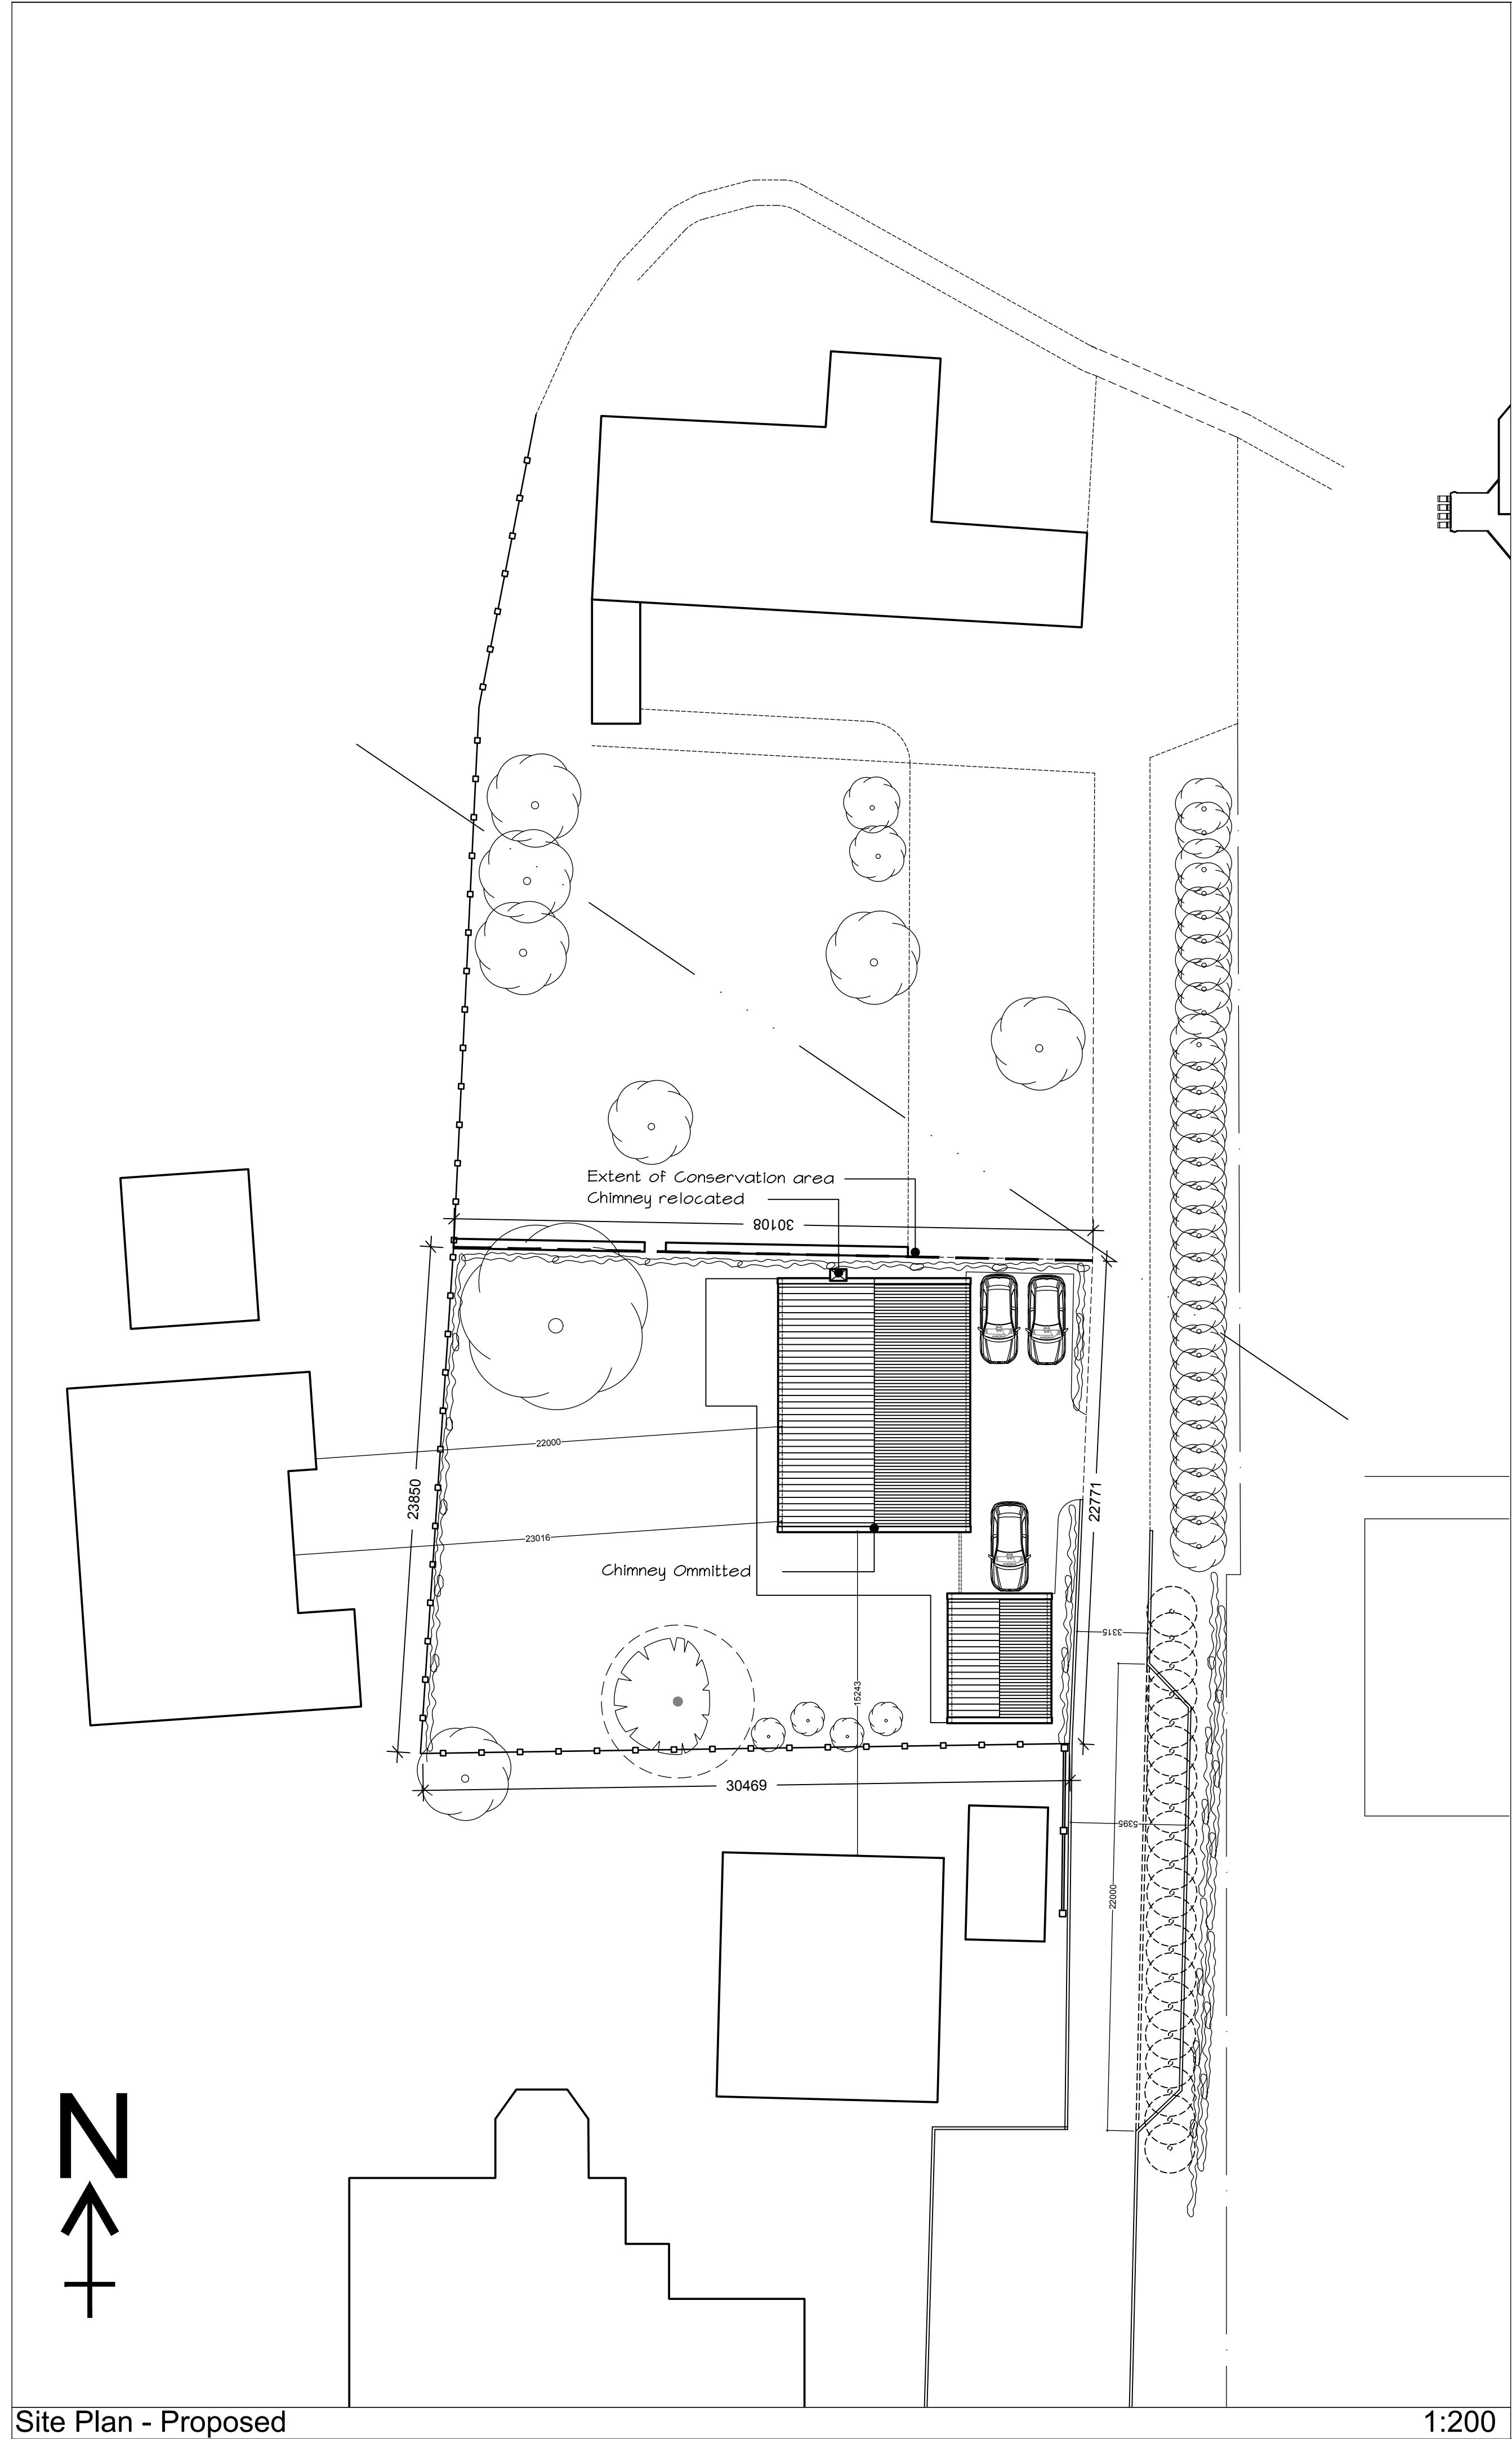

Plot boundaries are defined by the existing fencing, wall and road and all as per the legal documents accompanying the sale of the plot. Plot dimensions are for information only.

All as per planning approval unless noted.

D	Planning Application	01.12.17	ACM
C	Submitted to Planning for as built amendments	10.03.17	ACM
B	Chimney redesigned and soft landscaping scheme updated	11.08.15	ACM
A	Plot dimensions indicated	04.08.15	ACM
rev	description	date	dr by
original by			
A C Munro		24/08/2015	ACM

Planning



This drawing is to be read in conjunction with all related drawings. Do not scale from this drawing. All dimensions must be checked and verified on site before commencing any work or producing shop drawings. The originator should be notified immediately of any discrepancy.
This drawing is copyright and remains the property of Three 6 T Architecture
T : 07583 303 464. E : enquiries@three6t.co.uk

client	Mytton Homes			
project	The Orchards Overton			
project no	1507/005			
drawing title	Site Plan Proposed			
scale	prefix	drawing No	rev	
As shown @ A1	PL	210	D	