


1:50

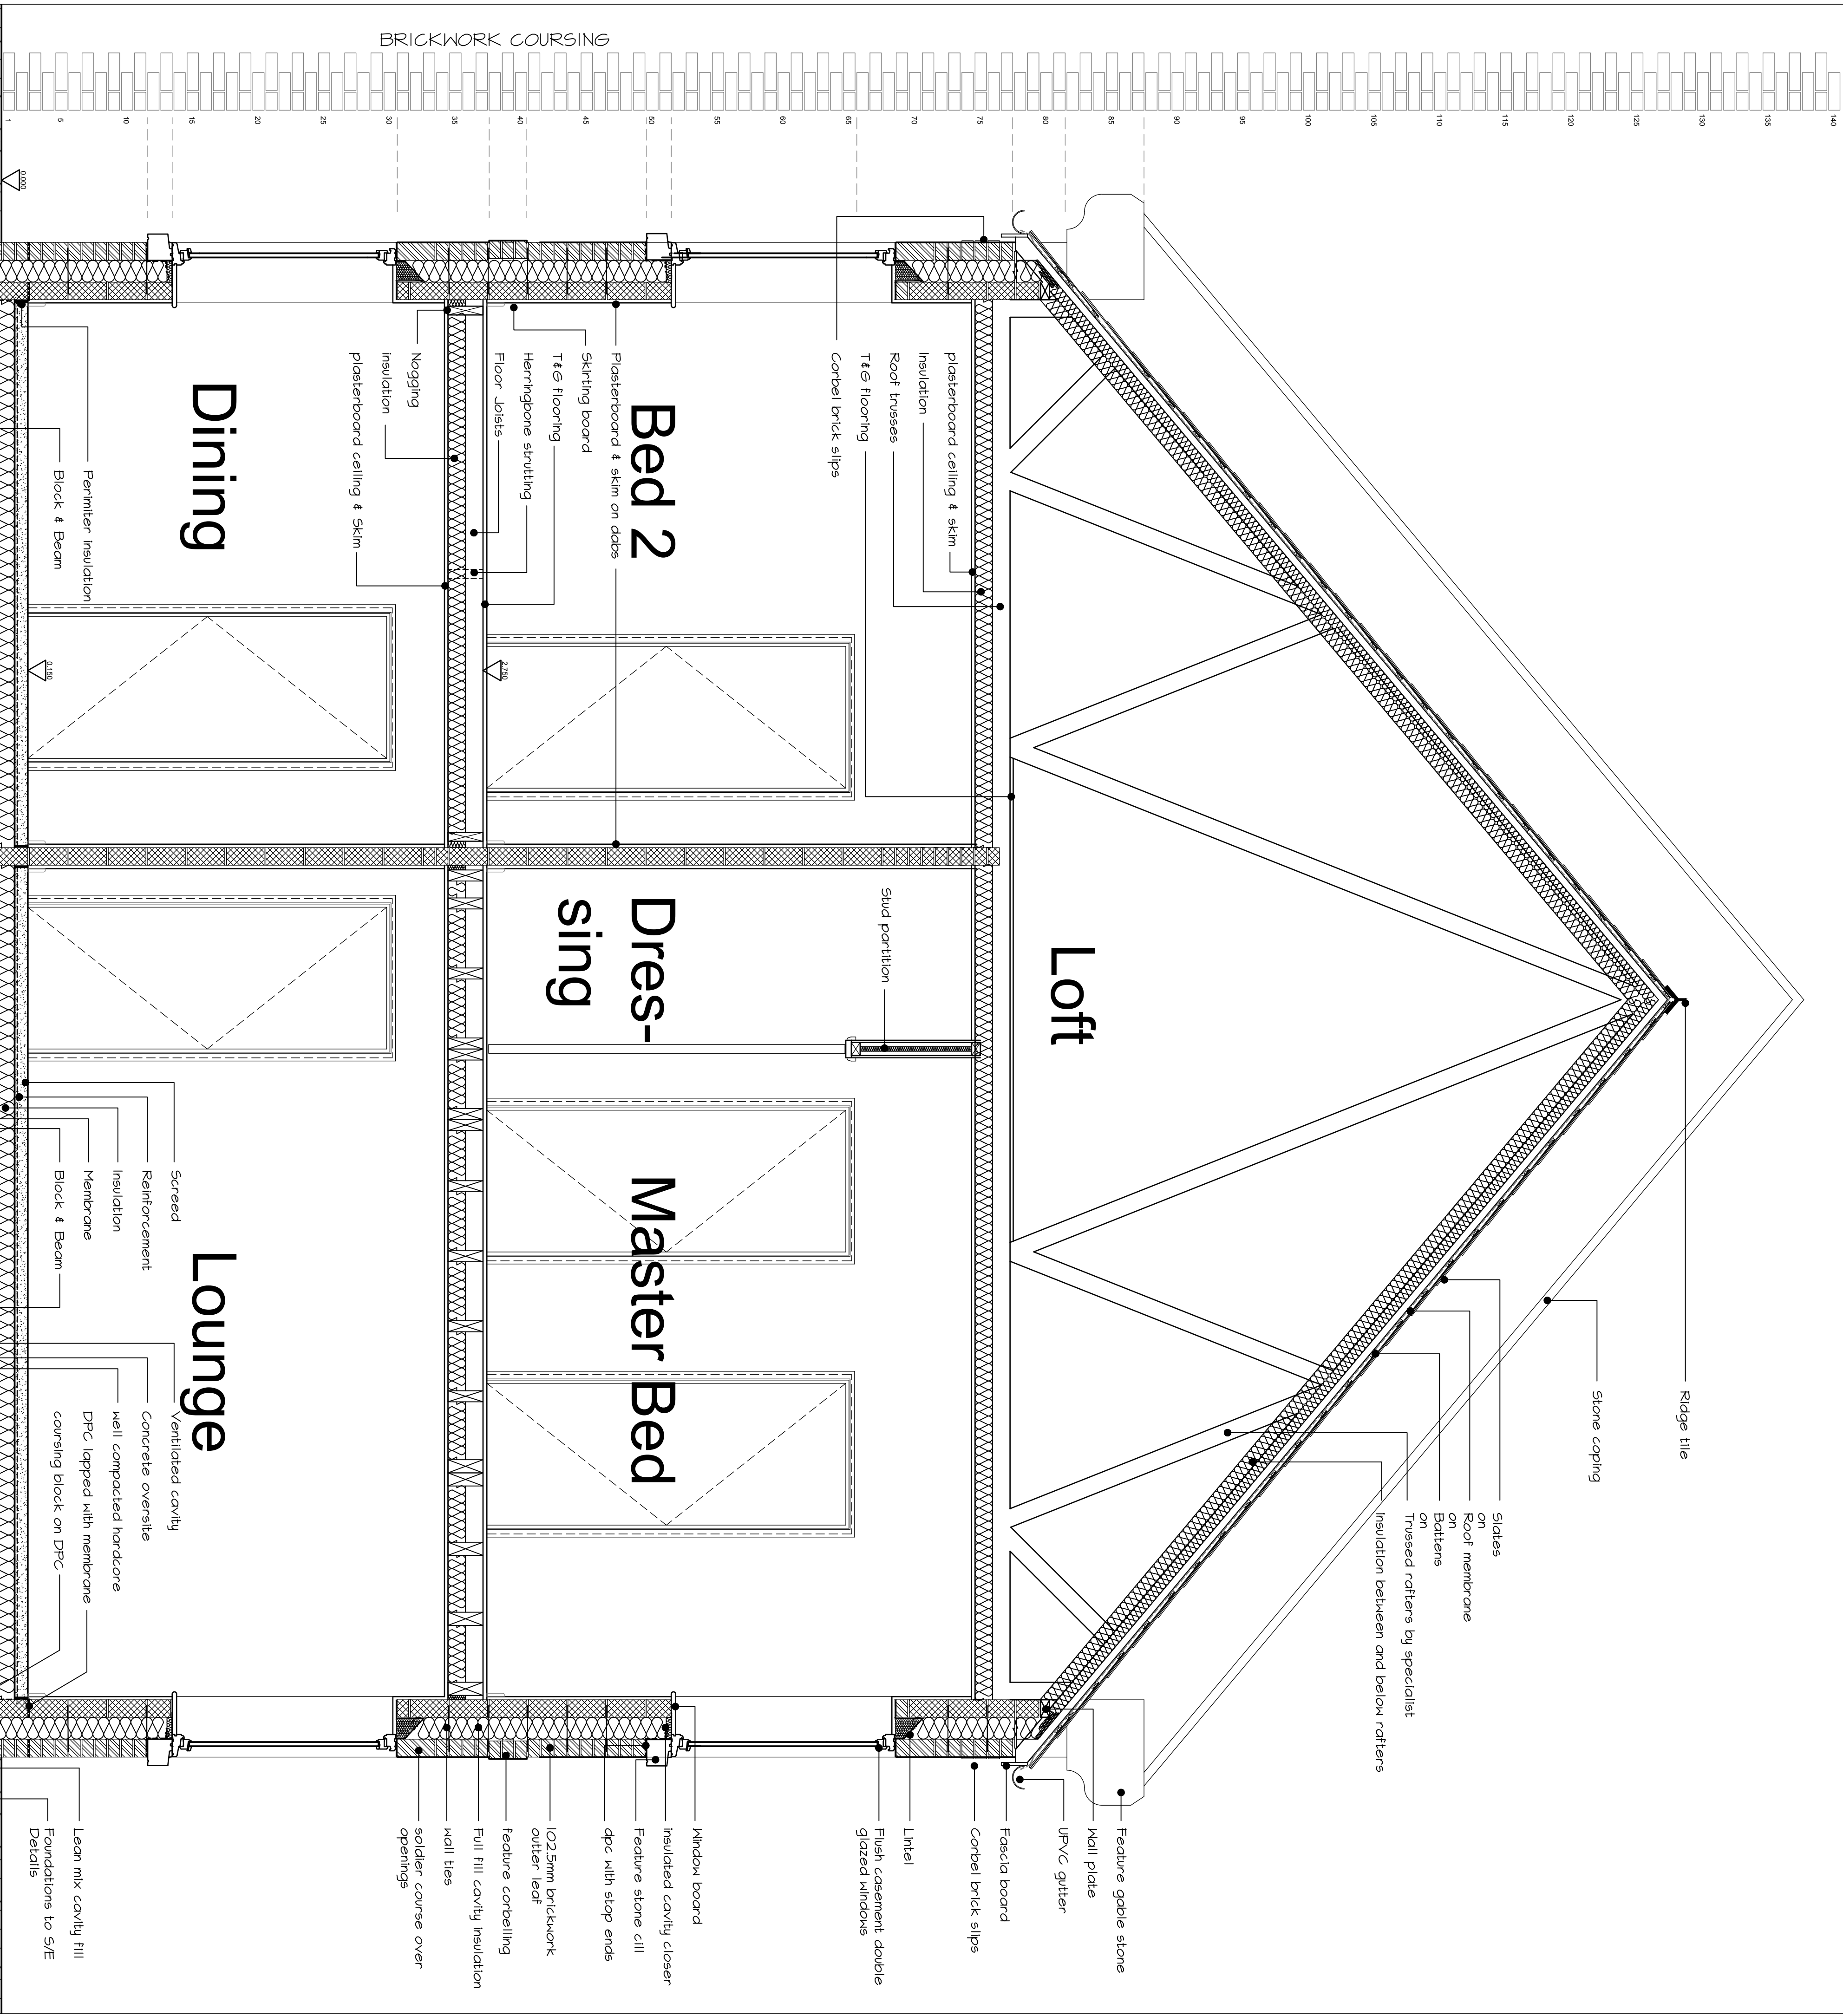

E	Planning Application	01.12.17	ACM
	Window head heights increased and cill heights lowered, corbel/bricks steps added,		
D	Amended to suit on site 'As Built' by contractor	31.03.17	
	to now include different corbel detail above GF window head, omitted corbel detail above FF window head, window cill level lower, roof level increase in height, chimney increase in height & width and gable walls increased in height.		
C	Submitted to Planning for as built amendments	10.03.17	ACM
B	Minor updates to incorporate NHBC comments	16.03.17	ACM
A	Chimney redesigned	11.09.15	ACM
rev	description	date	dr by
original by			
A C Munro		24/08/2015	ACM

This drawing is to be read in conjunction with all related drawings. Do not scale from this drawing. All dimensions must be checked and verified on site before commencing any work or producing shop drawings. The originator should be notified immediately of any discrepancy.
This drawing is copyright and remains the property of Three 6 T Architecture
T : 07583 303 464. E : enquiries@three6t.co.uk

project					The Orchards Overton				
project no					1507/005				
drawing title					Section Proposed				
scale		prefix		drawing No		rev			
As shown @ A1		SE		230		E			