





1. Front (East) Contextual Elevation

1:100

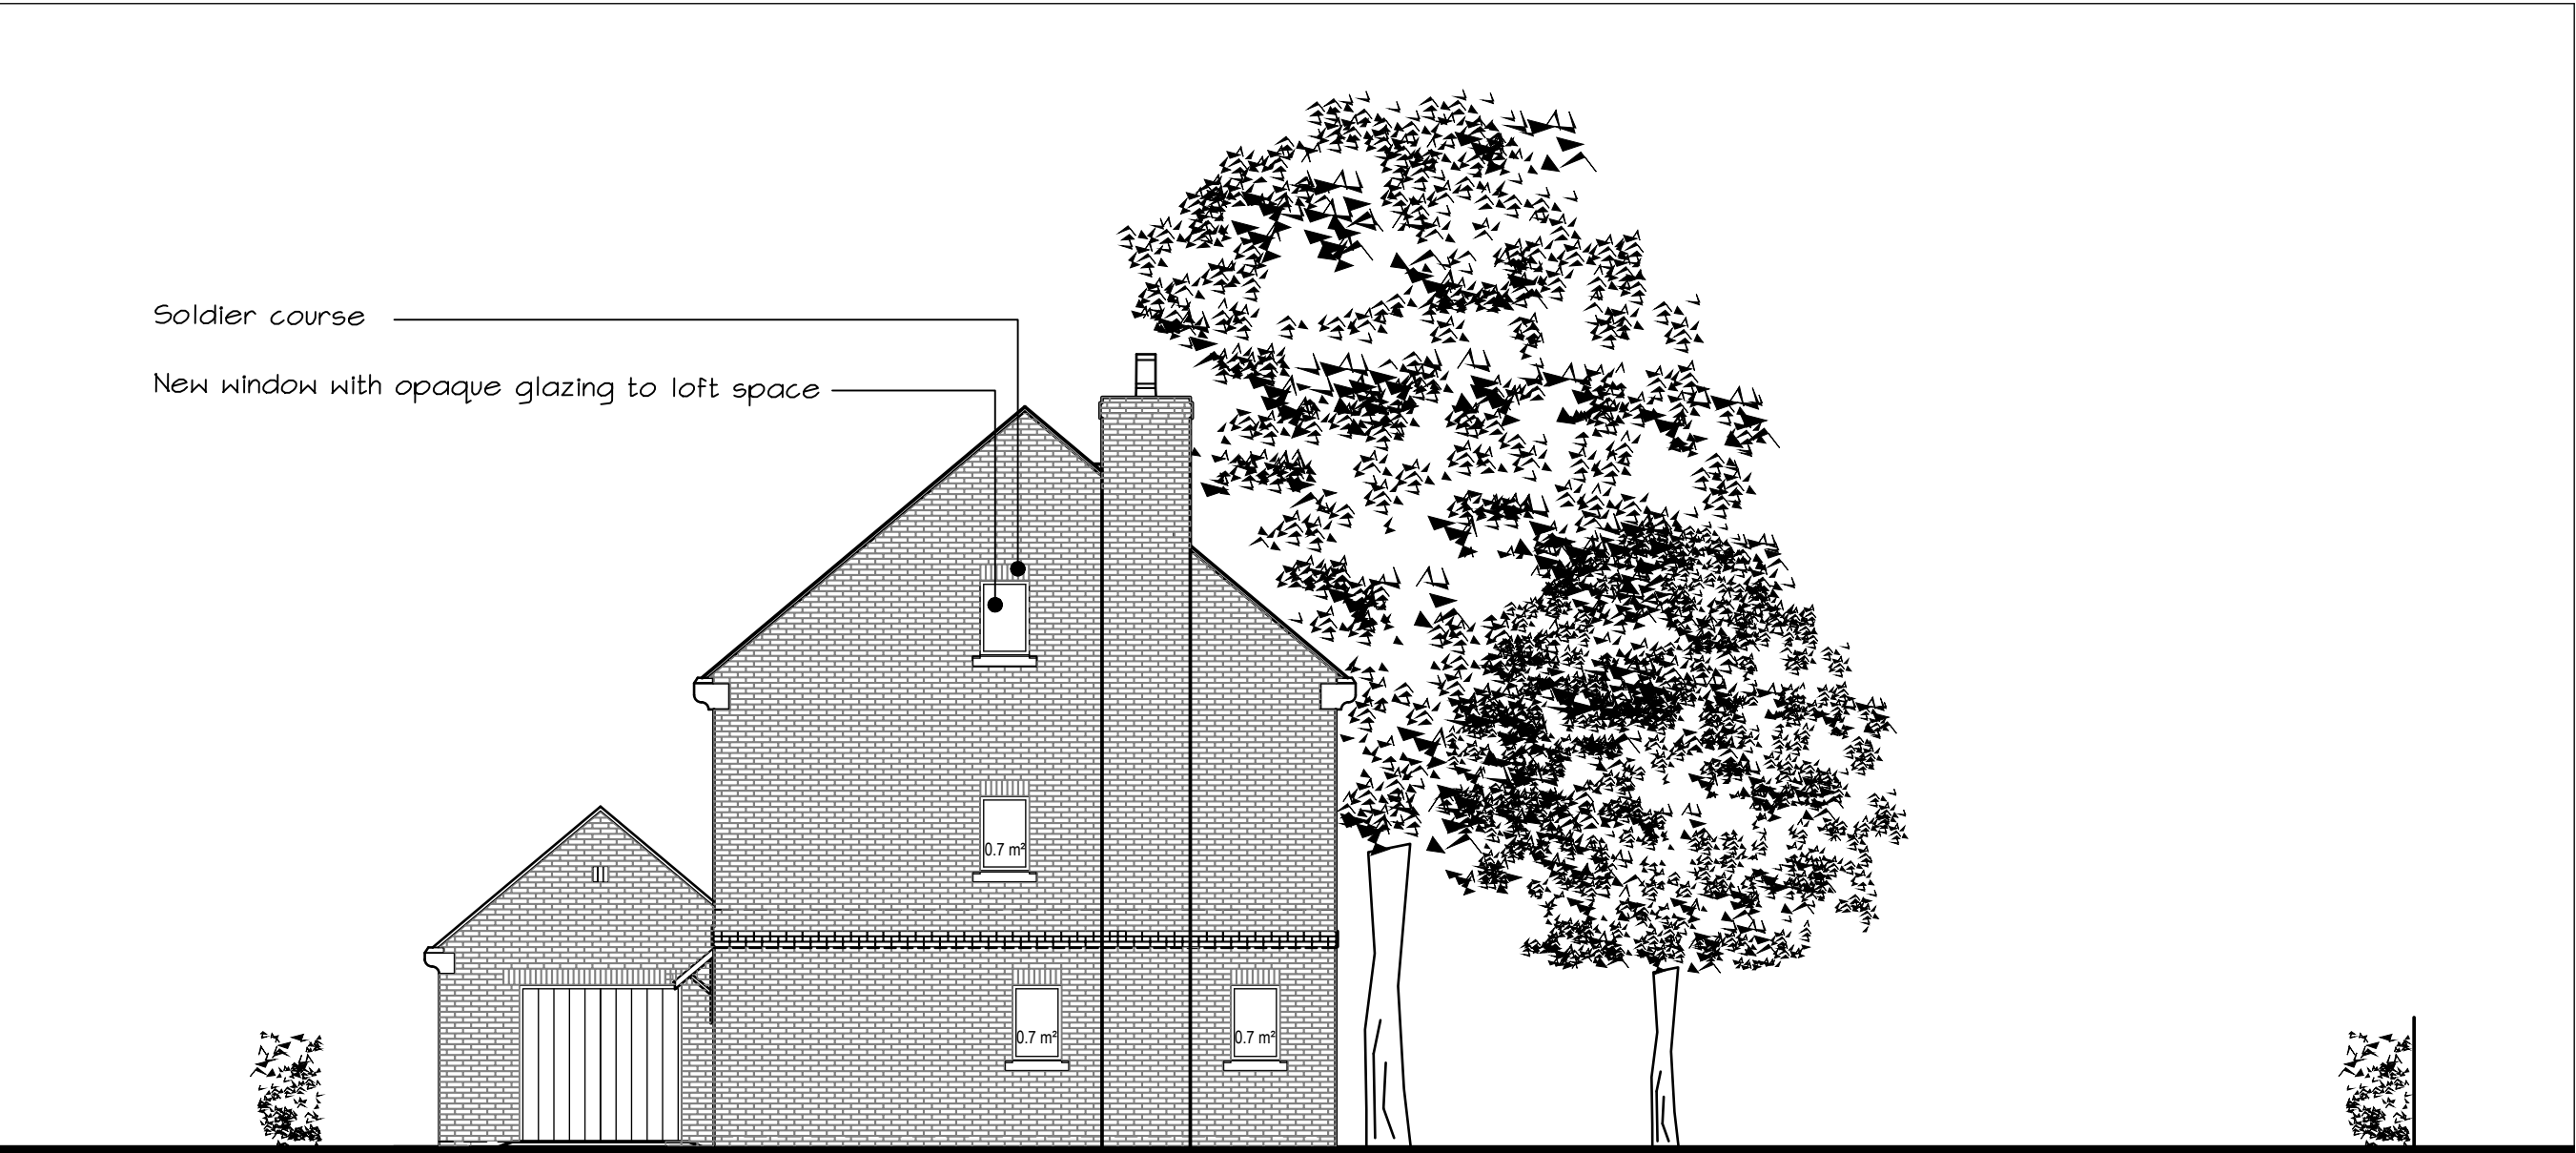

2. Side (North) Elevation

1:100

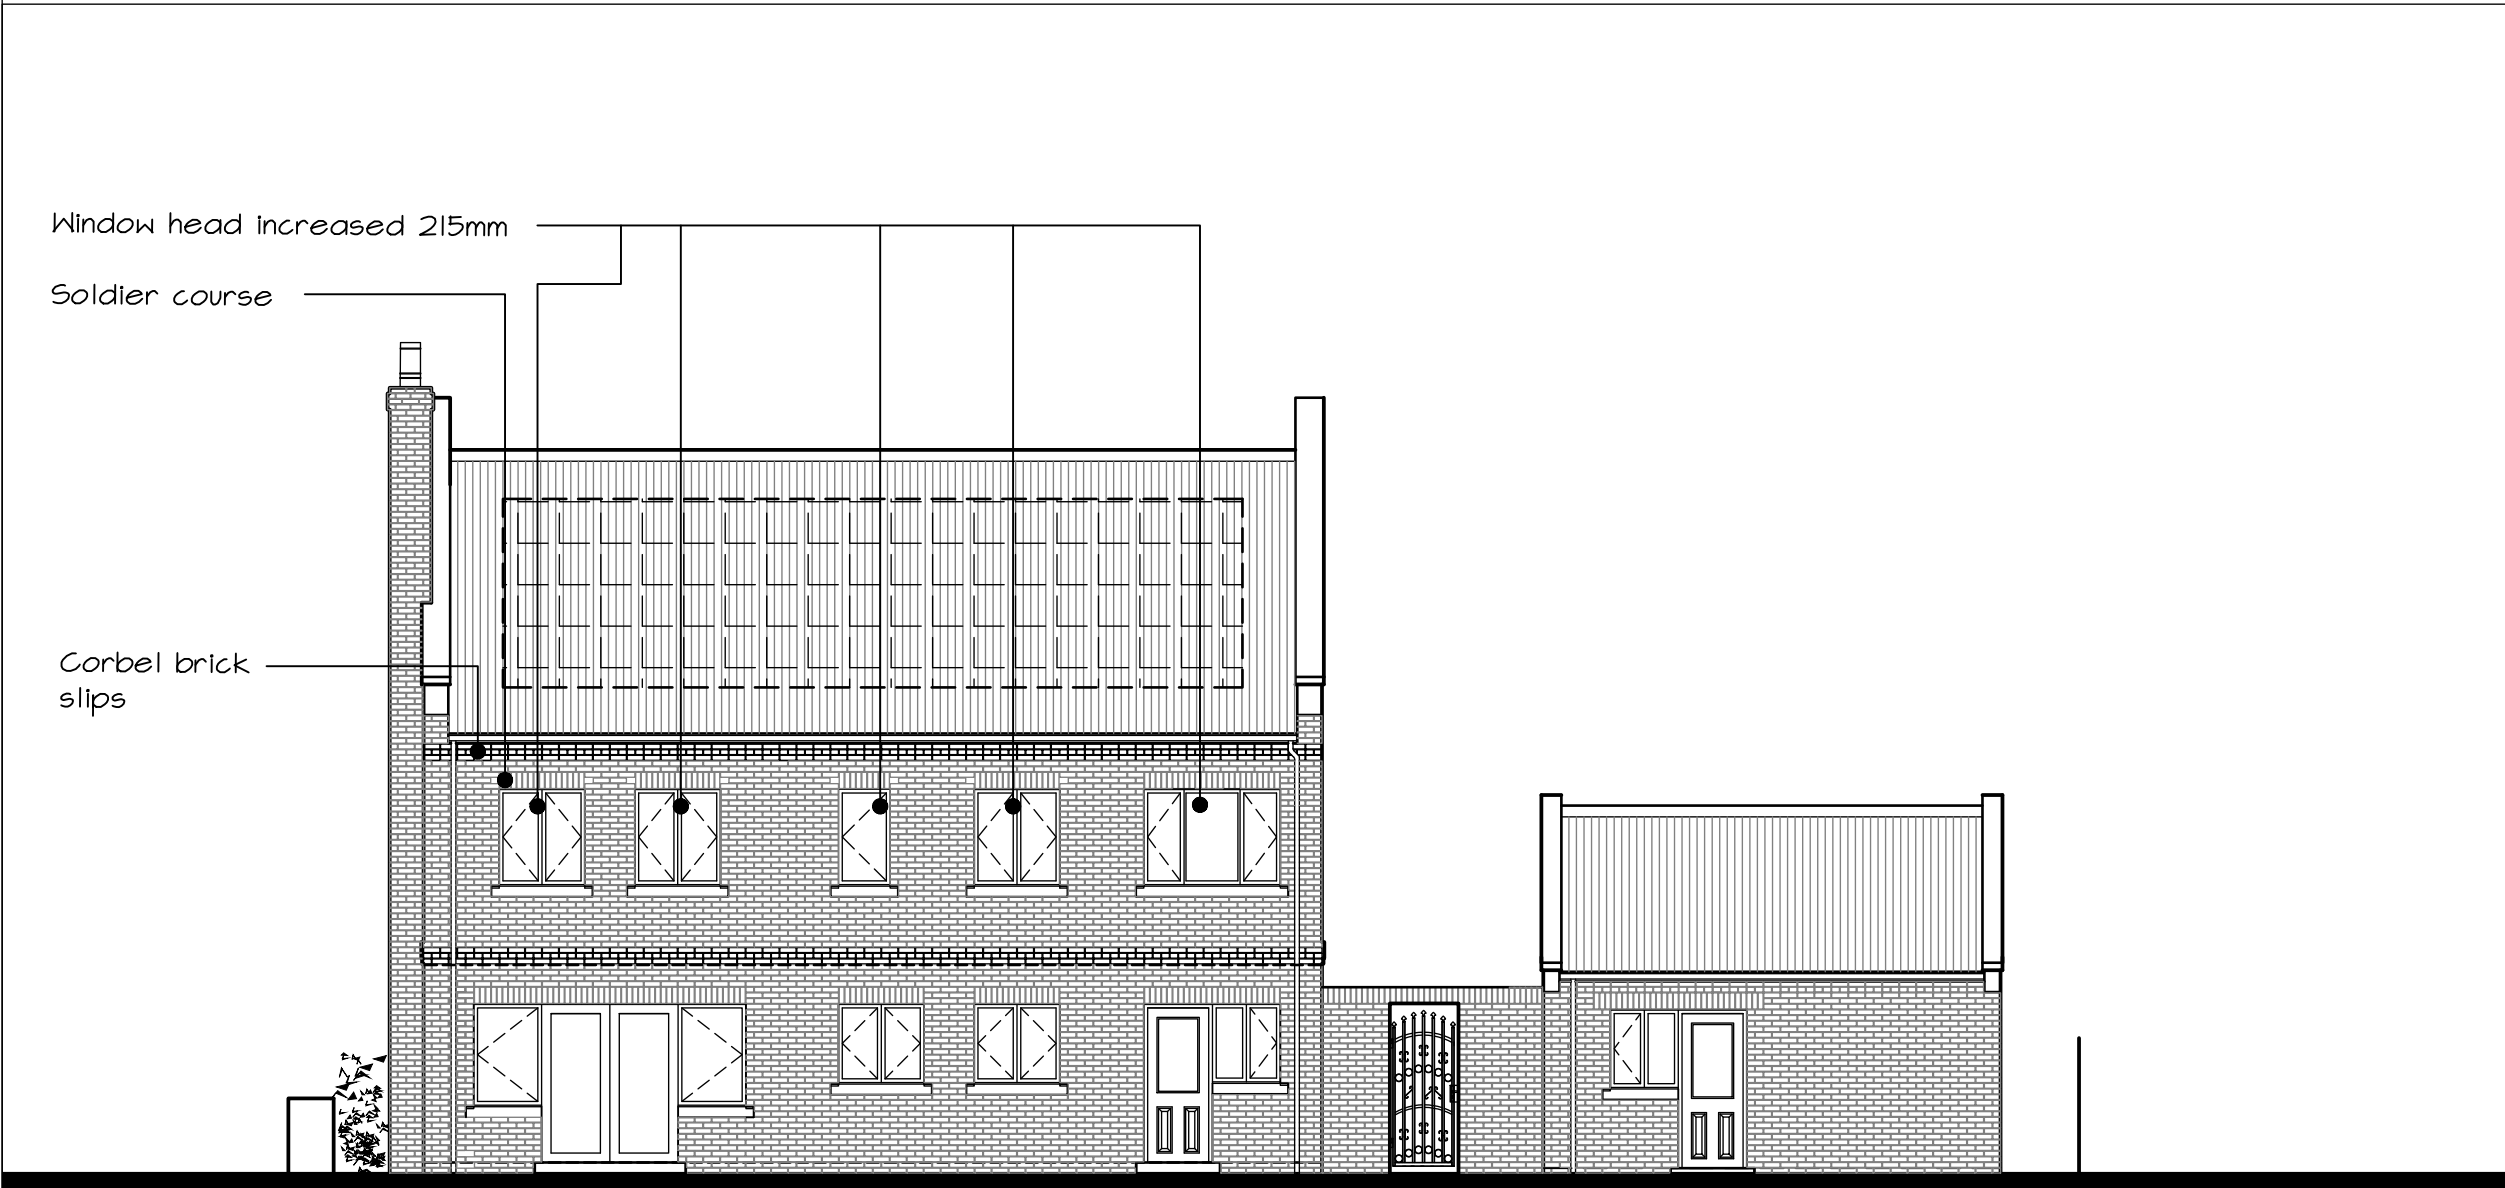

3. Rear (West) Elevation


1:100



4. Side (South) Elevation

1:100

Notes as 1 / 230 unless otherwise noted

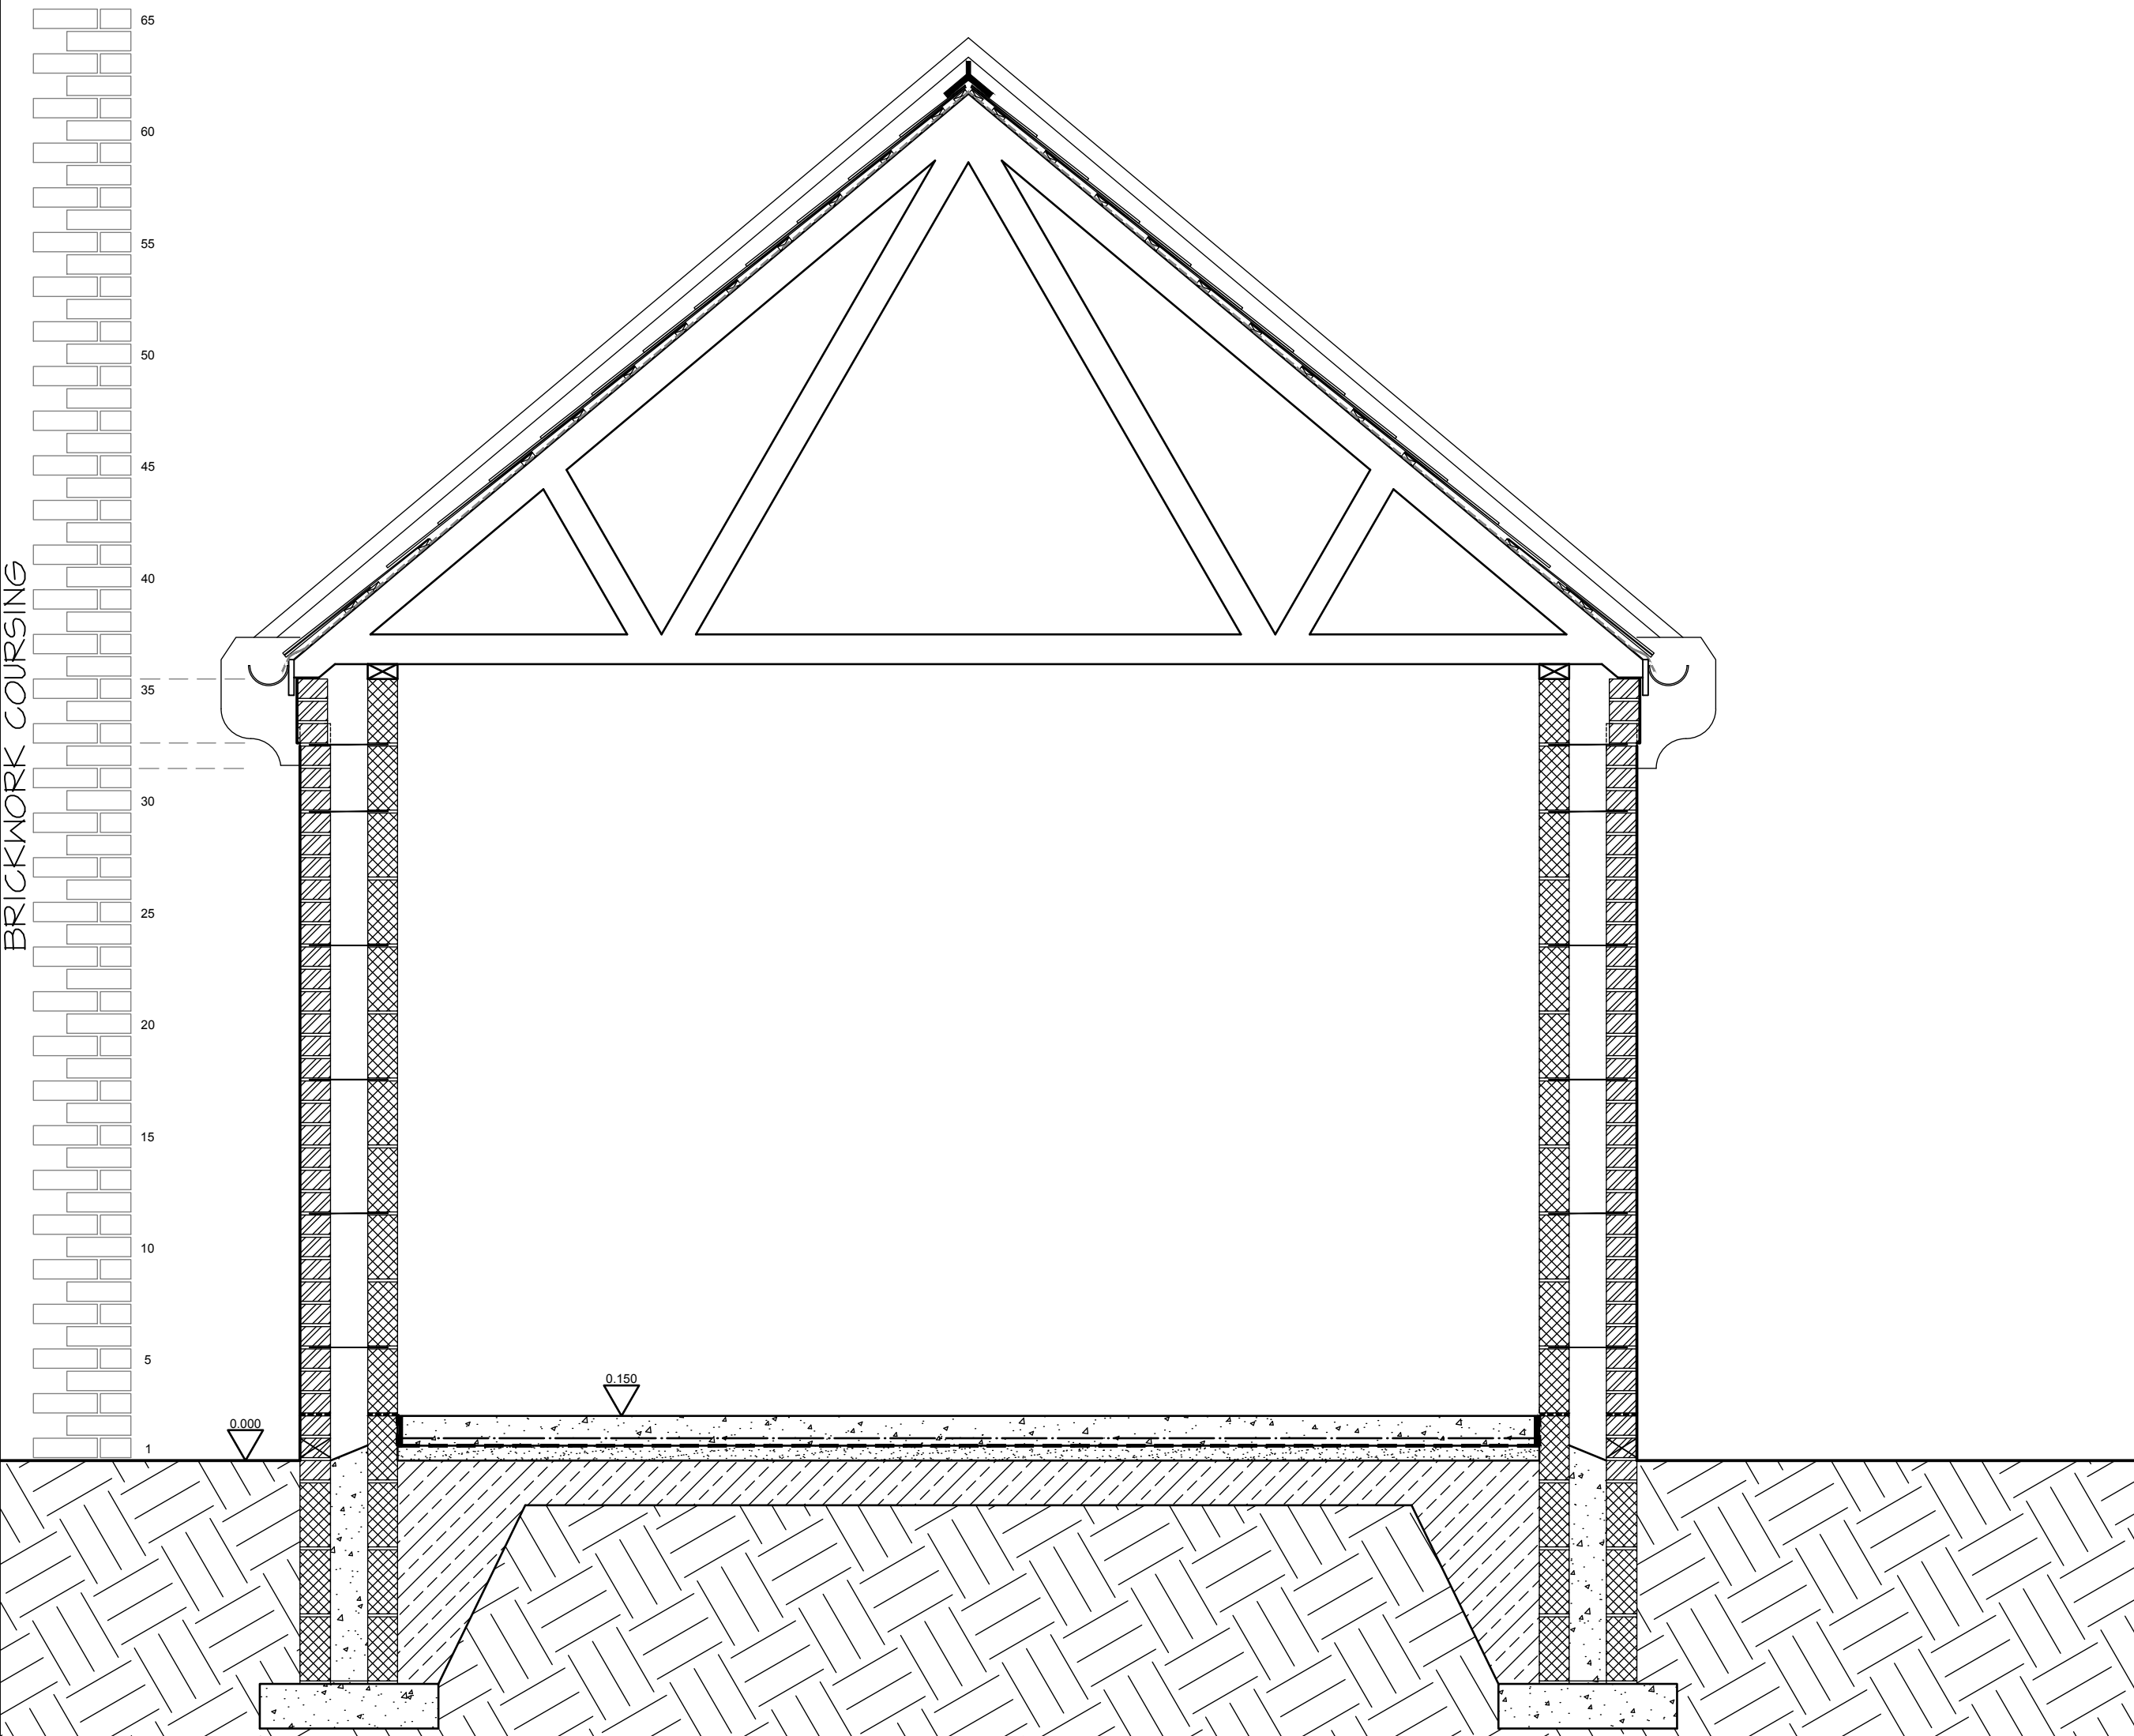

5. Section B - B

1:20

All as per planning approval unless noted.

F	Planning Application	01.12.17	ACM
E	Window head heights increased and cill heights lowered, corbel brick slips added.	31.03.17	ACM
D	Amended to suit on site "As Built" by contractor to now include different corbel detail above GF window head, omitted corbel detail above FF window head, window cill level changes, roof level increase in height, chimney increase in height & width and gable walls increased in height.	10.03.17	ACM
C	Submitted to Planning for as built amendments	18.10.15	ACM
B	Minor updates to incorporate NHBC comments	15.10.15	ACM
A	FF window on South elevation removed to match plan	11.09.15	ACM
rev	description	date	dr by
original by	A C Munro	24/08/2015	ACM

Planning



This drawing is to be read in conjunction with all related drawings. Do not scale from this drawing. All dimensions must be checked and verified on site before commencing any work or producing shop drawings. The originator should be notified immediately of any discrepancy. This drawing is copyright and remains the property of Three 6 T Architecture T: 07583 303 464. E: enquiries@three6t.co.uk

client	Mytton Homes		
project	The Orchards Overton		
project no	1507/005		
drawing title	Elevations & Garage Section Proposed		
scale	prefix	drawing No	rev
As shown @ A1	EL	220	F