
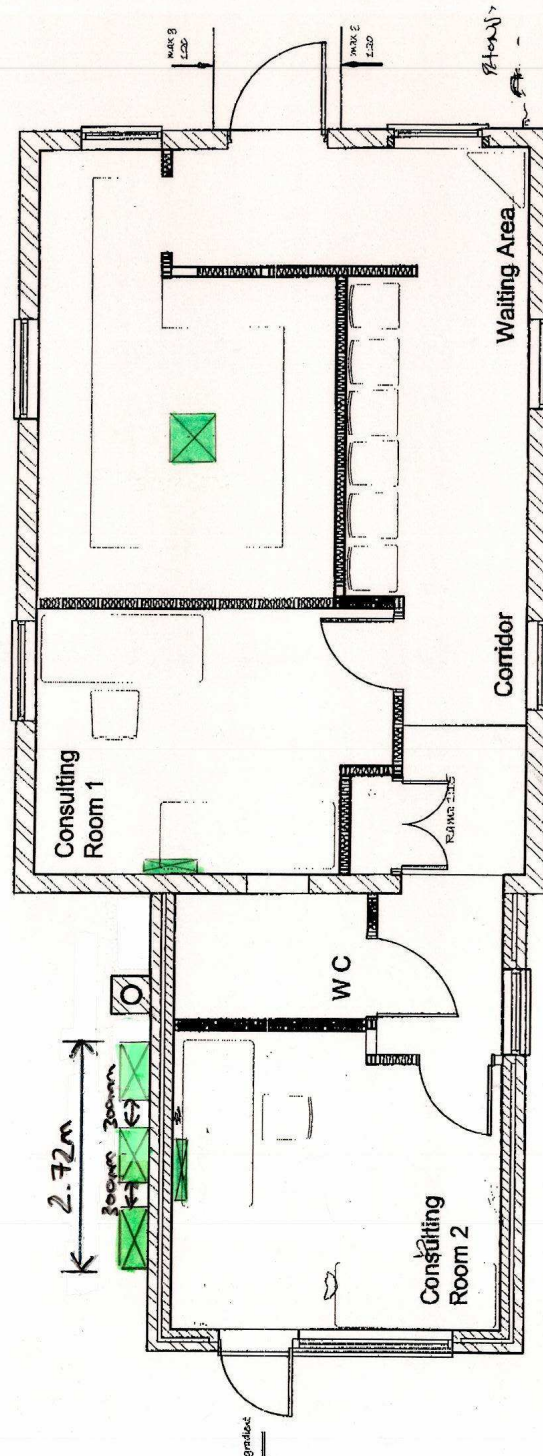


04 Feb. 2015 05:41PM P2

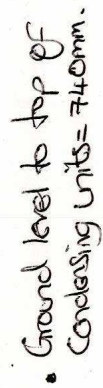

Project	Advertisements and refurbishment works for the building premises to form a new residential building consisting of a three bedroomed semi detached house and a two bedroomed detached house.
Client	OVERTON MEDICAL PRACTICE 15 High Street Widmore Widham IL13 9ED
Drawing	floor plan

Scale	1:50	1: Drawn
Checked		Date 15/02/2014
Drawing No.	121201MP.04	

This drawing and details is copyright and must not be reproduced in part or in whole, without prior written consent. Contractors must verify all dimensions and details against the accompanying text or preparing record drawings.



consulPNE