
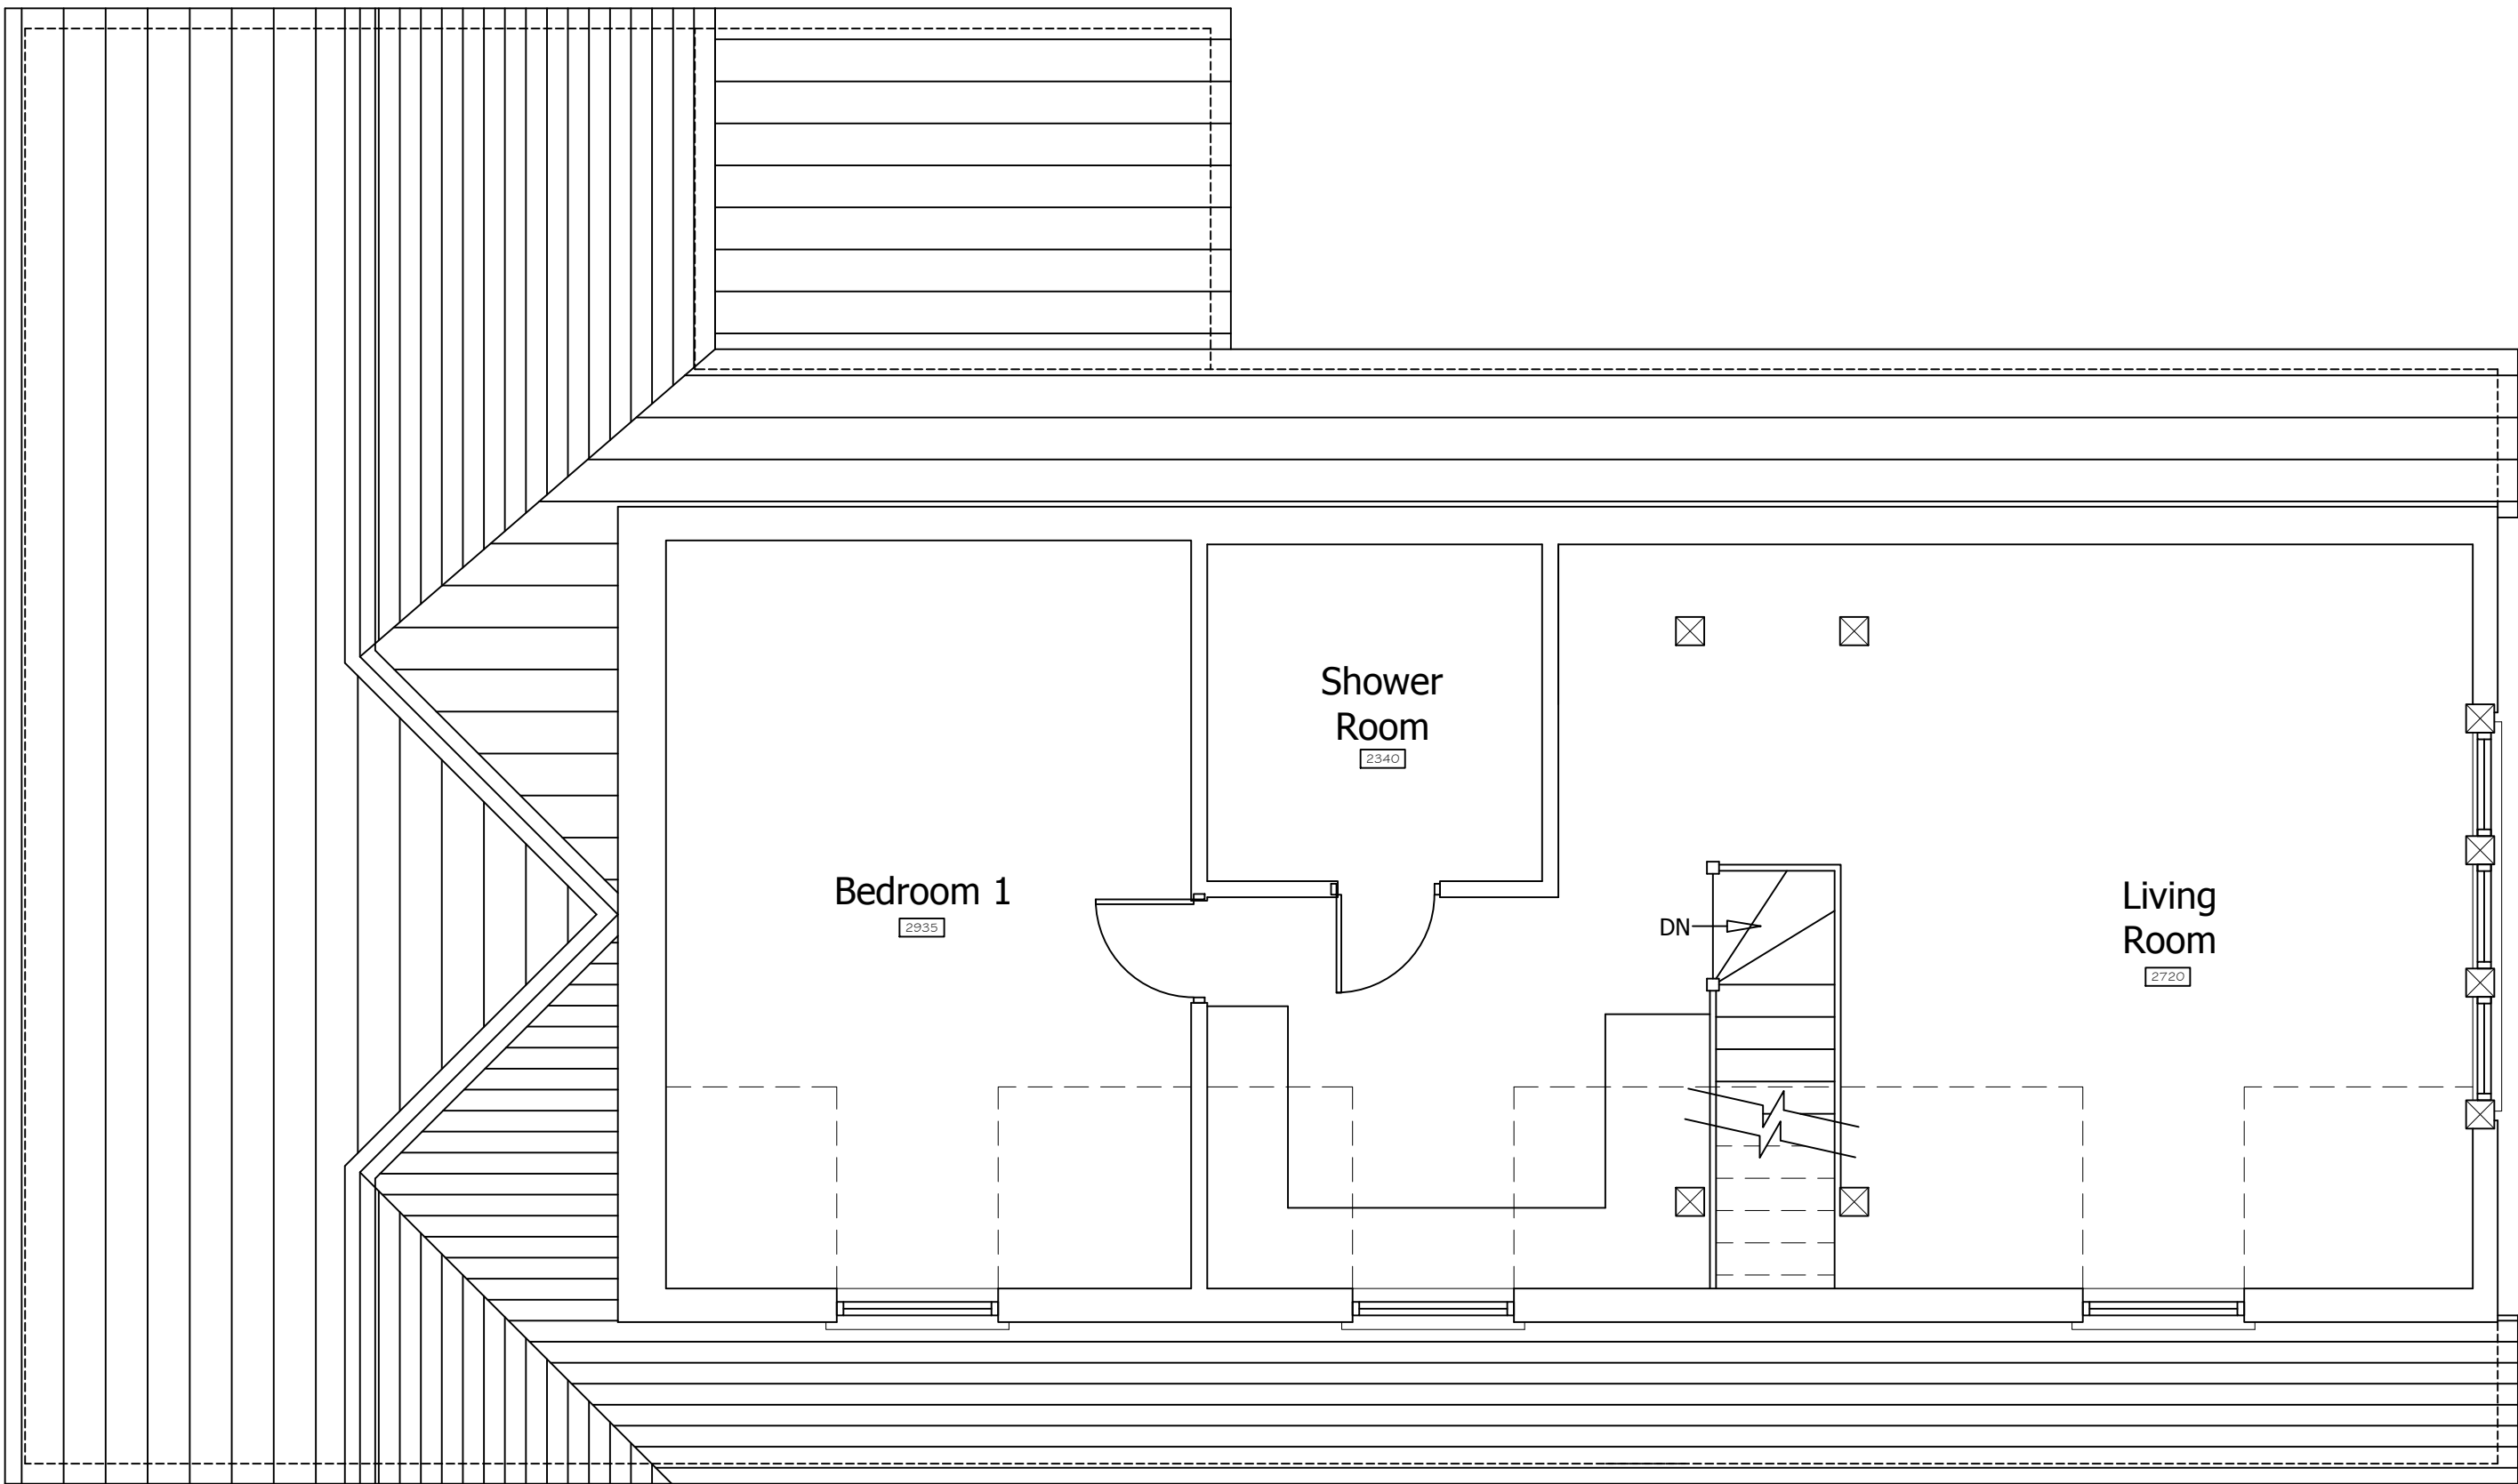
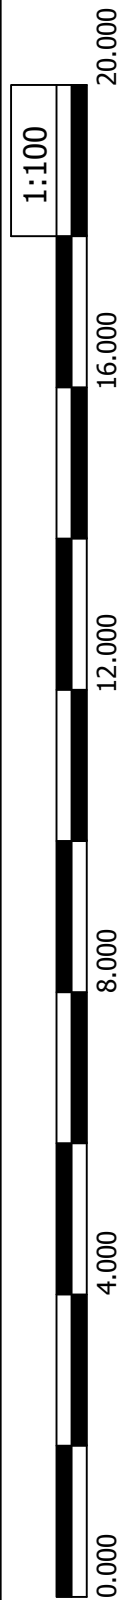


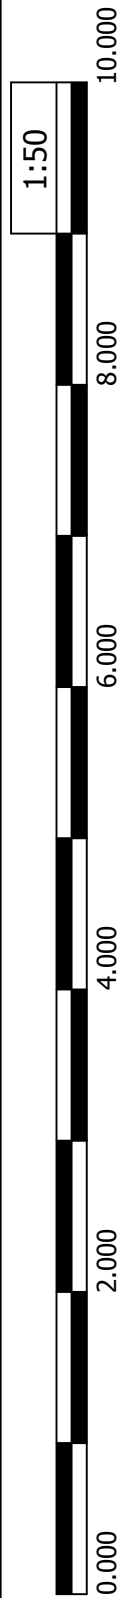

AS-BUILT
First Floor Plan

Portman Surveyors Ltd.©

Note:
This drawing is copyright protected; do not scale off, all dimensions are to be checked on site by contractor. Contractor to report any discrepancies in dimensions, errors or omissions prior to commencing work. Portman Surveyors Ltd. take no responsibility for any unauthorised use of the information contained herein.

A	3.6.24	Kitchen removed as requested by Planners
Rev	Date	Comment

Portman Surveyors Ltd
Chartered Building Surveyors

The Studio
Tarporley Business Centre
Nantwich Road
Tarporley
Cheshire CW6 9UT
Tel/Fax: +44 (0)1829 732696
Mobile: +44 (0)7812 021070
e: rob.lee@portmansurveyors.com

Client:	Date:
Mr & Mrs M Wakefield	June 2023
Project:	
Domestic Garage at Higher Berse Road, Wrexham. LL11 6PW	
Drawing Title:	Scale:
AS-BUILT	1:50
FF Plan	Status:
	Planning
Drawing No:	Rev:
A_374_03	A