


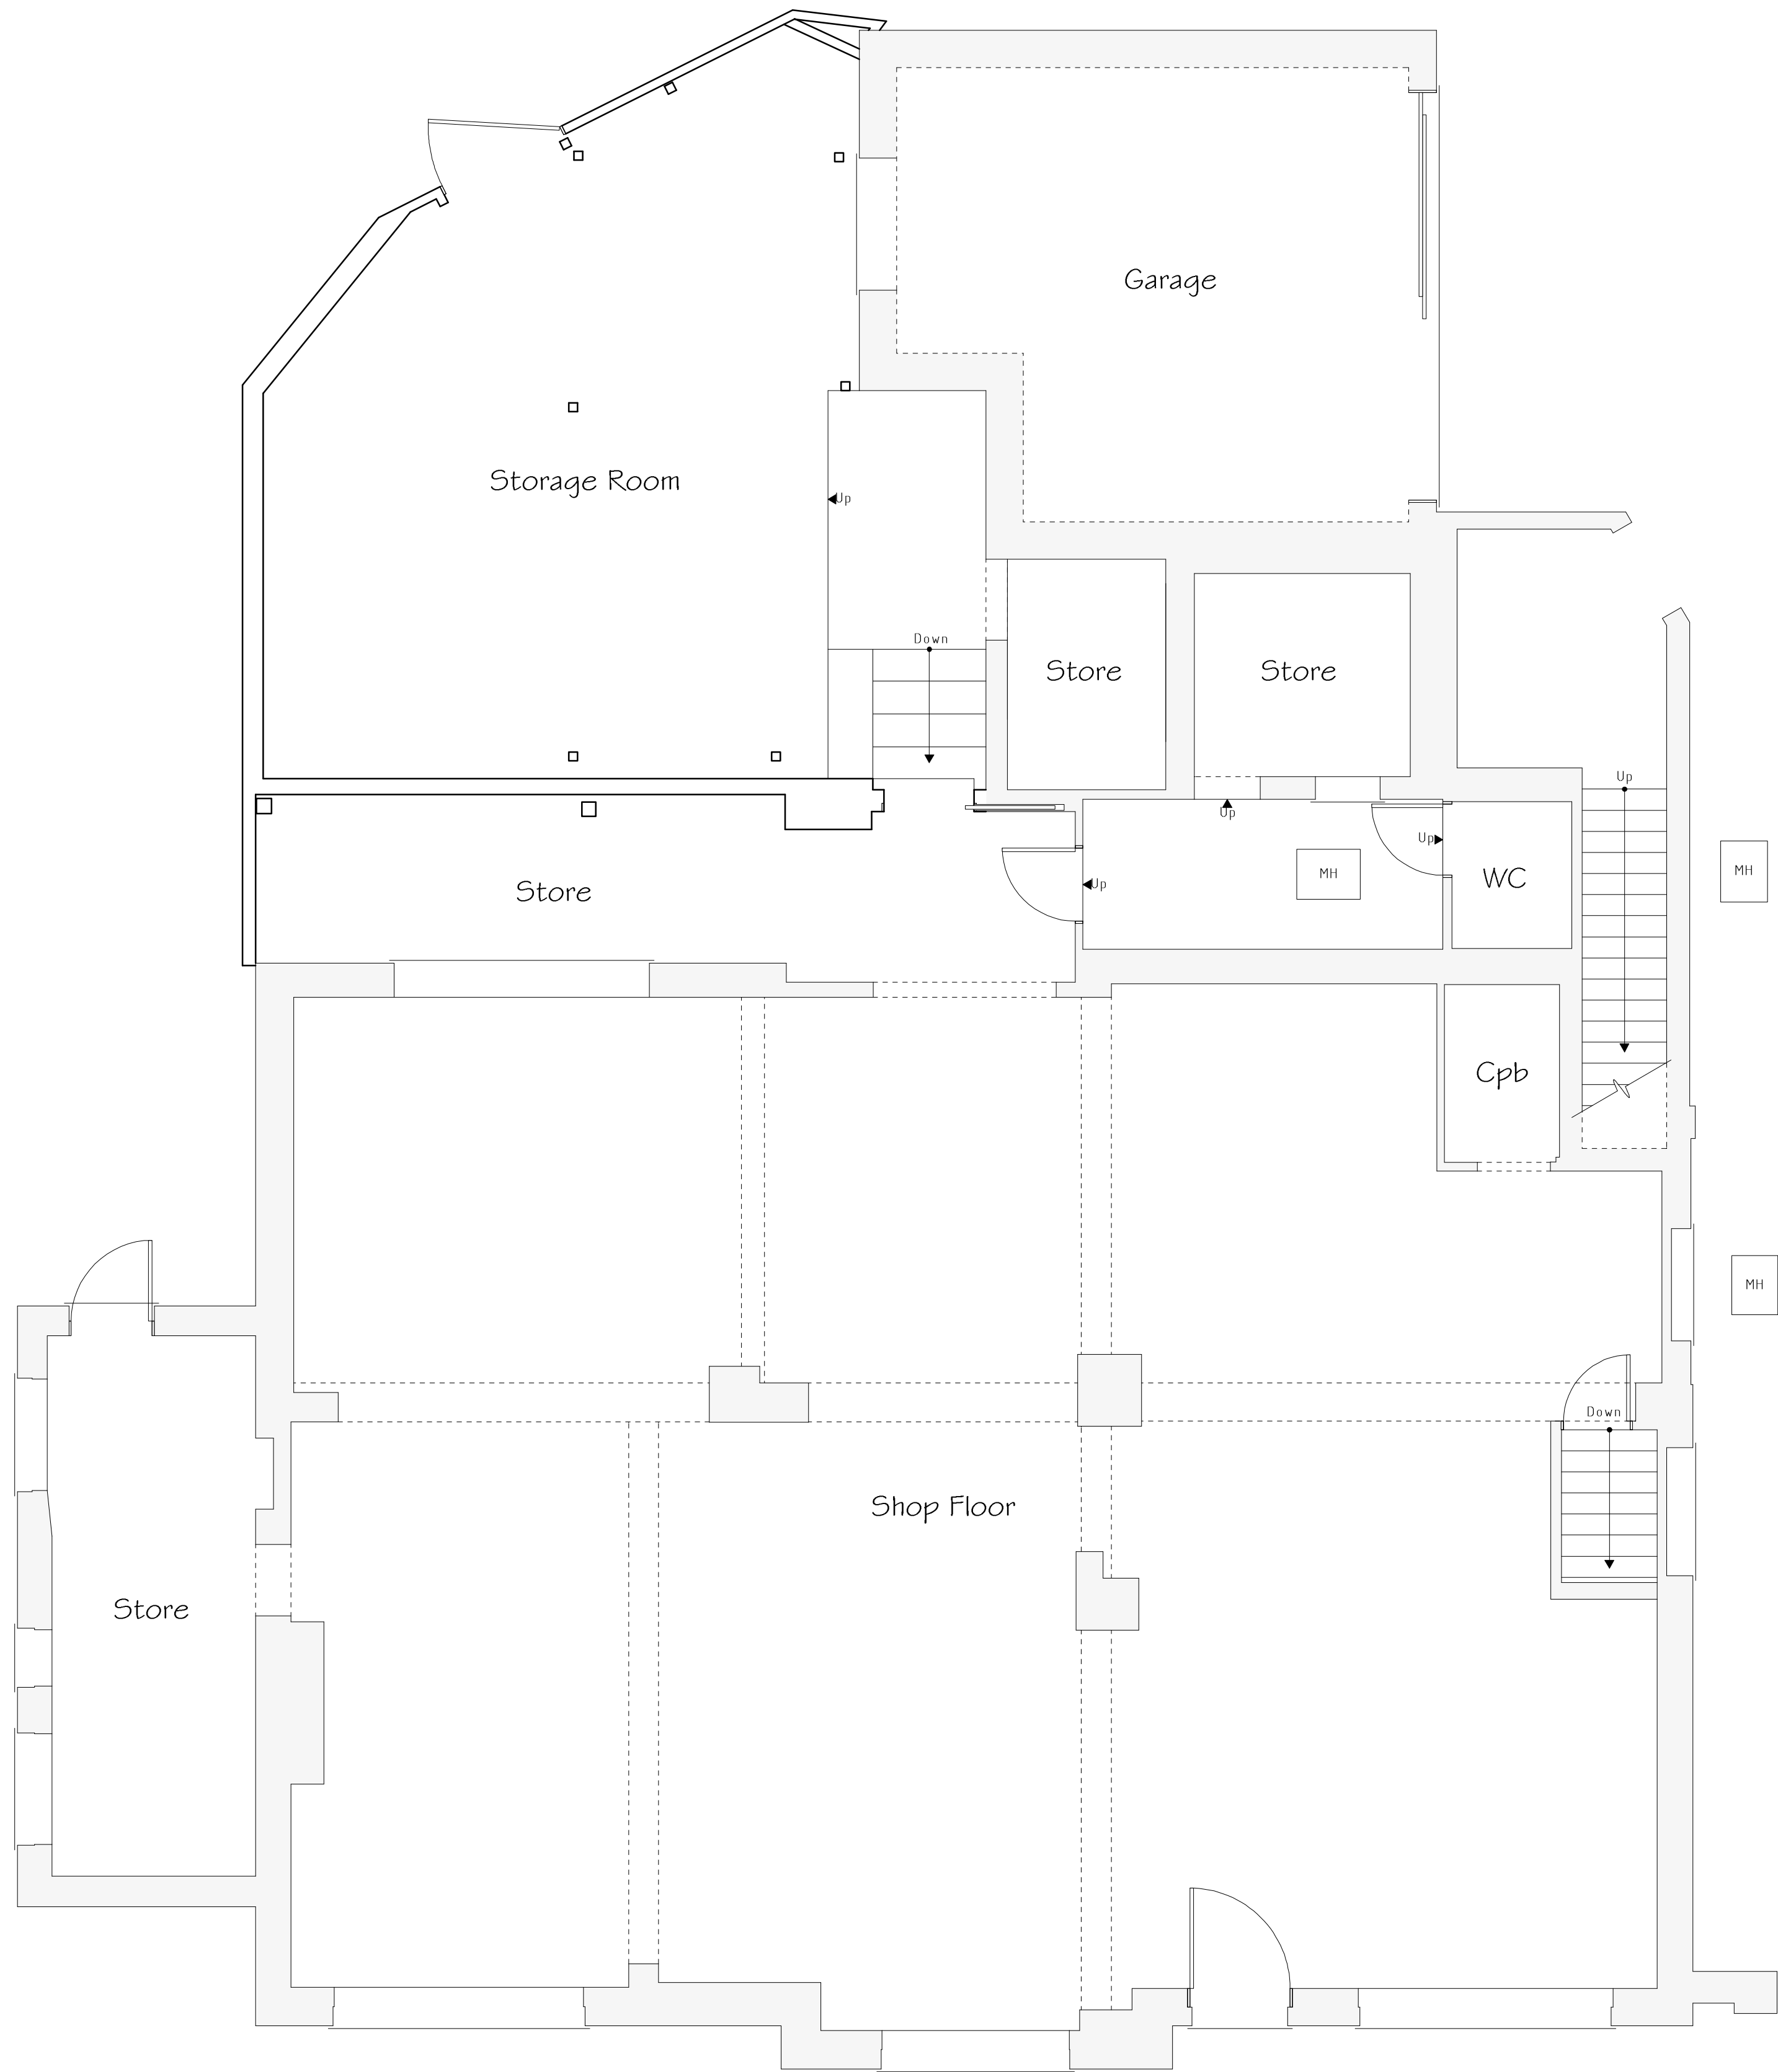

Ground Floor Plan 1:50




Front Elevation 1:100



Schwegler TSP Sparrow terrace box to be fitted with 6 weeks of approval of condition 2, P/2023/0376



Side Elevation 1:100

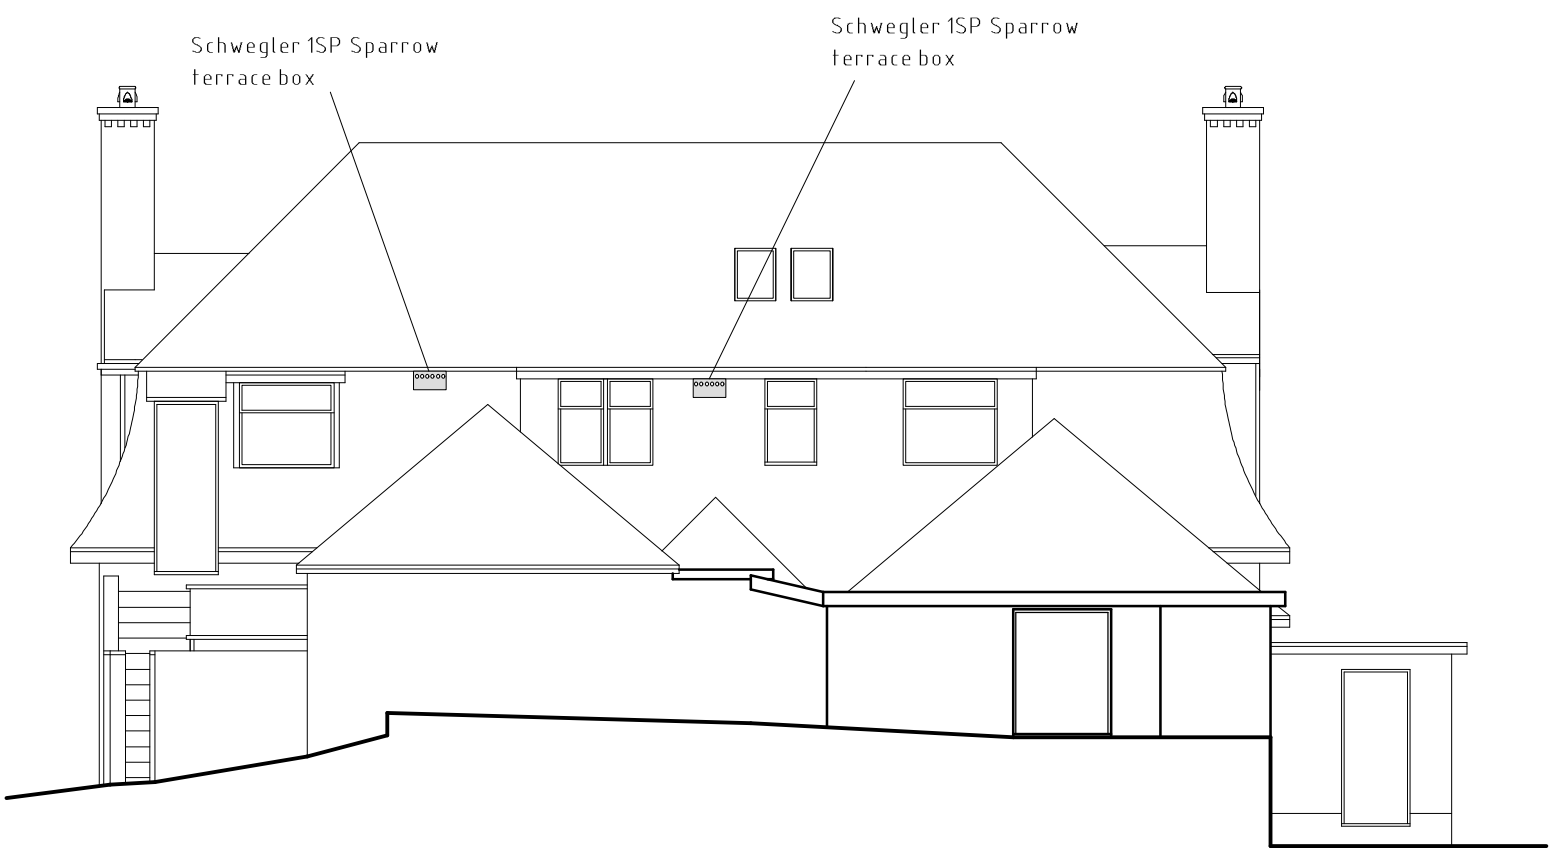

Rear Elevation 1:100



Side Elevation 1:100

Services Key			
MH	Existing	Man Hole Position	

Rev	Date	Detail	Initial
A	06/24	Net Biodiversity Gain	L.F

Project: Proposed Alterations to, Travellers Rest, Kings Mill Road, Wrexham, LL13 8NH	
Title: As Built Plan	Scale: (A1) 1:50 & 1:100

Drawn By: A.Valentine	Date: April 2023
Drawing No: B169/002	Sheet: 1 of 1



Office 3K4,
Redwither Business Tower,
Wrexham, LL13 9XT
Tel: 01978 356500
www.blueprintarchitectural.com
© copyright all rights reserved