



Front elevation 1:100

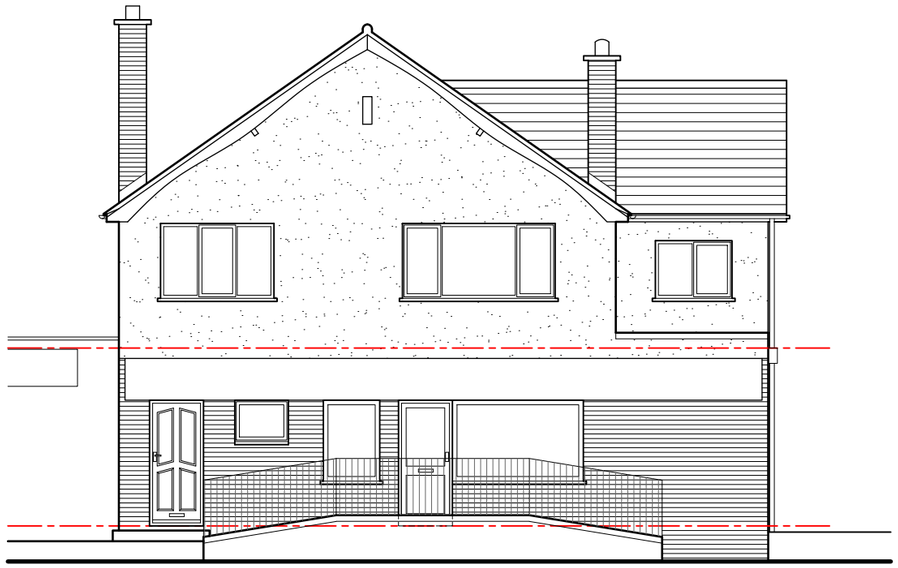

Side-01 elevation 1:100



Rear elevation 1:100

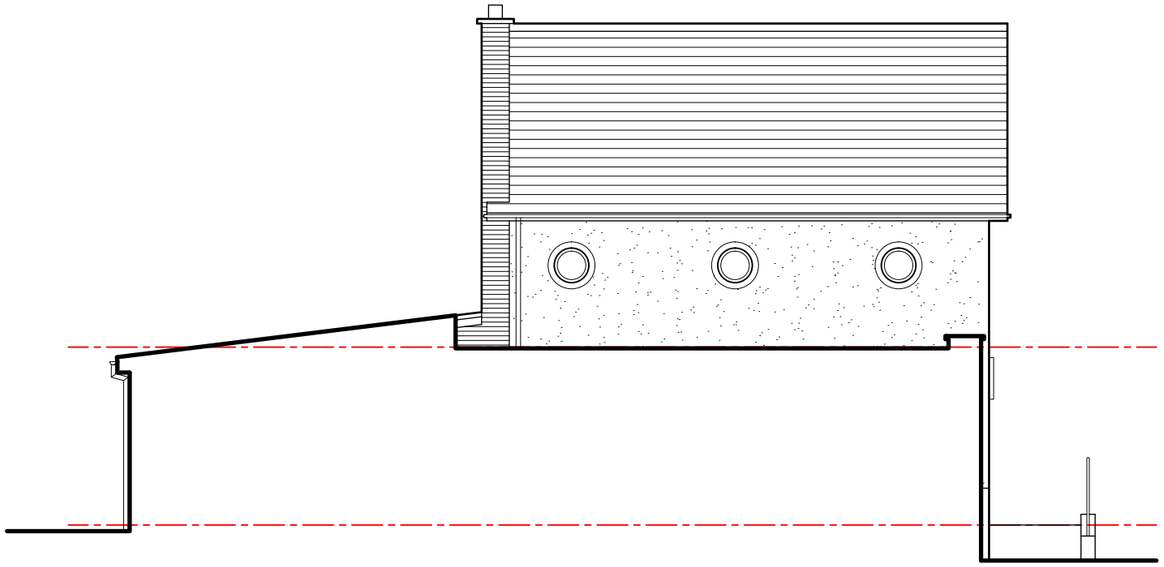

Side-02 elevation 1:100

As Built

HDS ARCHITECTURAL SERVICES	**Project;** Parkside, Fifth Avenue, Llay, Wrexham, LL12 0SA	**Dwg No;** PA/PD/06	**Date;** 07.06.24
HDS Architectural Services, The Foundry, 15 Yorke Street, Wrexham LL13 8LW Tel (01978) 345250 www.hdsarchitectural.co.uk	**Title;** 06-As Built Elevations	**Scale (A3);** 1:100	**Revision;**