



Existing Site plan 1:200

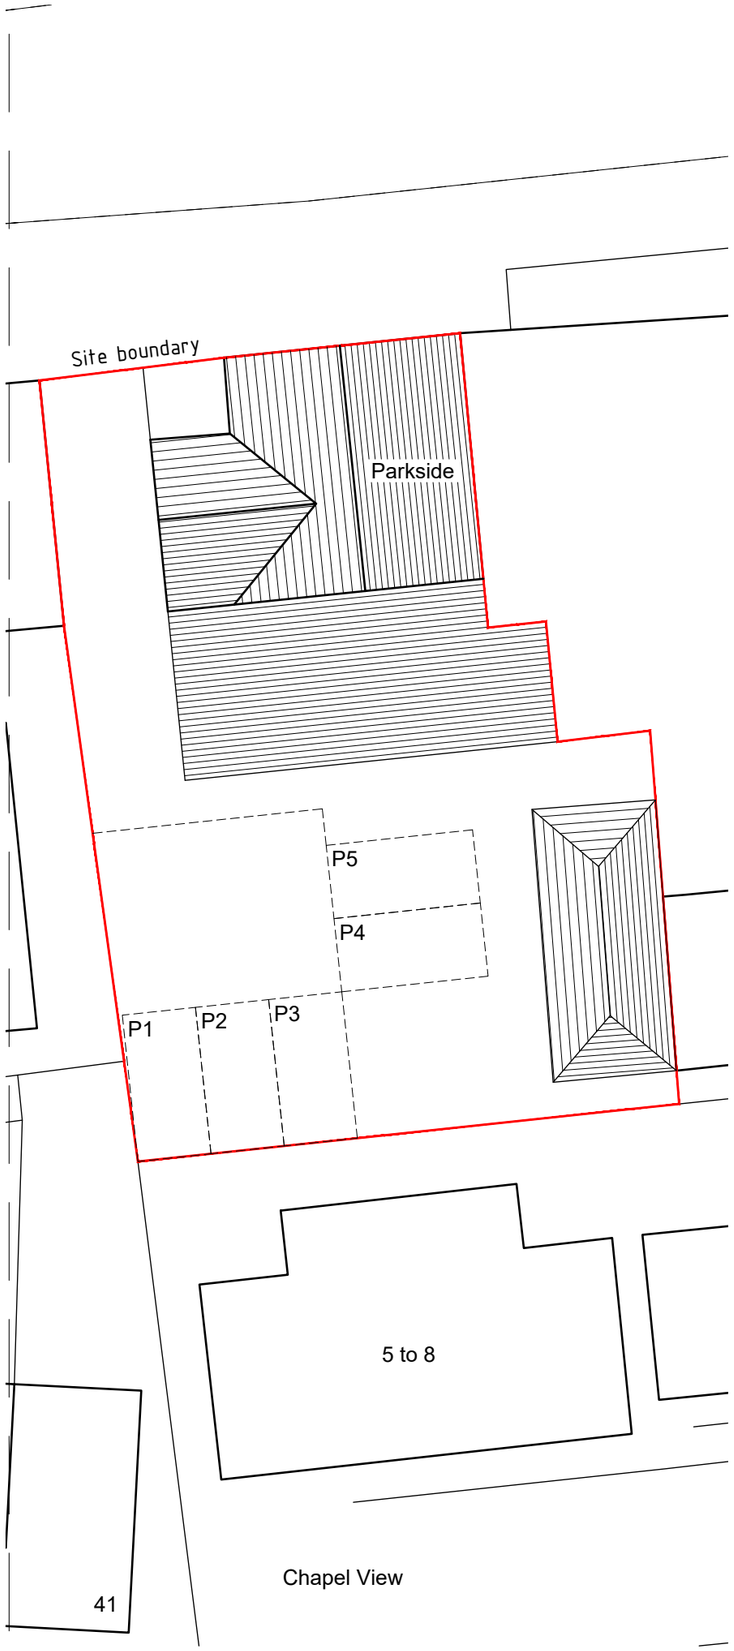

As Built Site plan 1:200

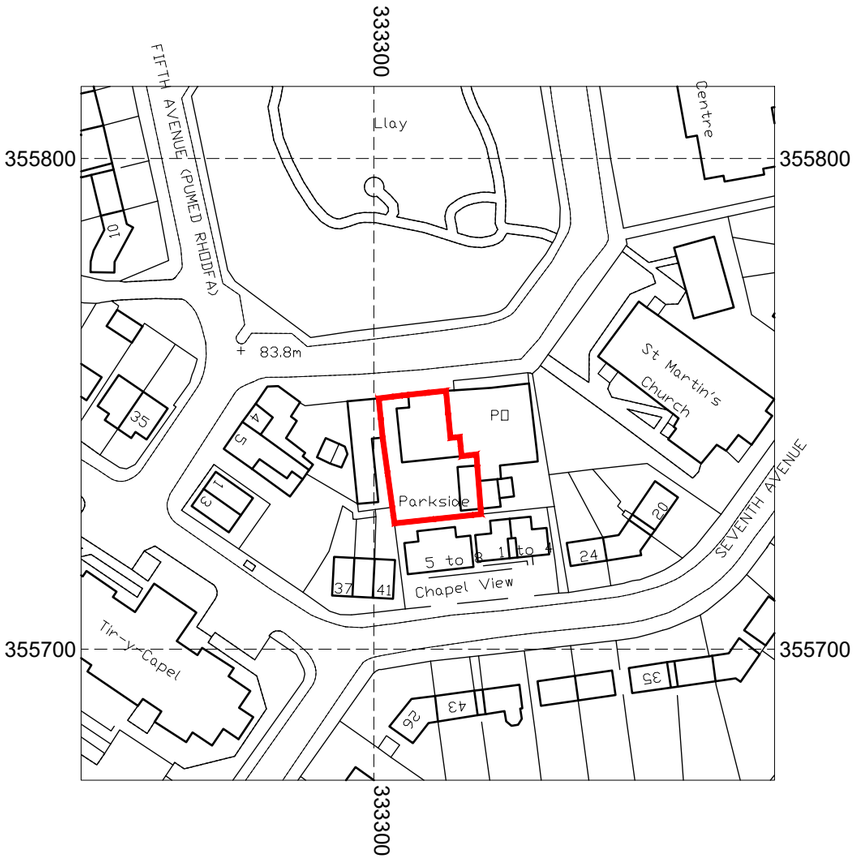


Site location plan 1:1250

1:1250 10m 20m 30m 40m 50m 60m 70m 80m 90m 100m

1:200 1m 2m 4m 6m 8m 10m 12m 14m 16m 18m 20m

©Crown Copyright and database rights 2023 OS 100047474

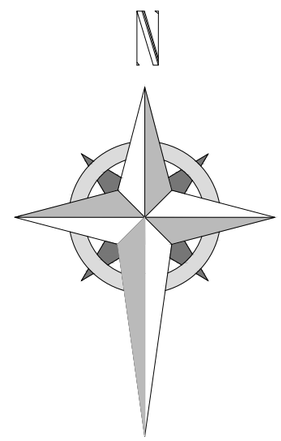

HDS ARCHITECTURAL SERVICES
HDS Architectural Services, The Foundry,
15 Yorke Street, Wrexham
LL13 8LW
Tel (01978) 345250
www.hdsarchitectural.co.uk

Project;
Parkside, Fifth Avenue, Llay, Wrexham, LL12 0SA

Title;	**Scale (A3);**
07-Site location plan	1:200/1250
Dwg No;	**Date;**
PA/PD/07	11.06.24

Revision;