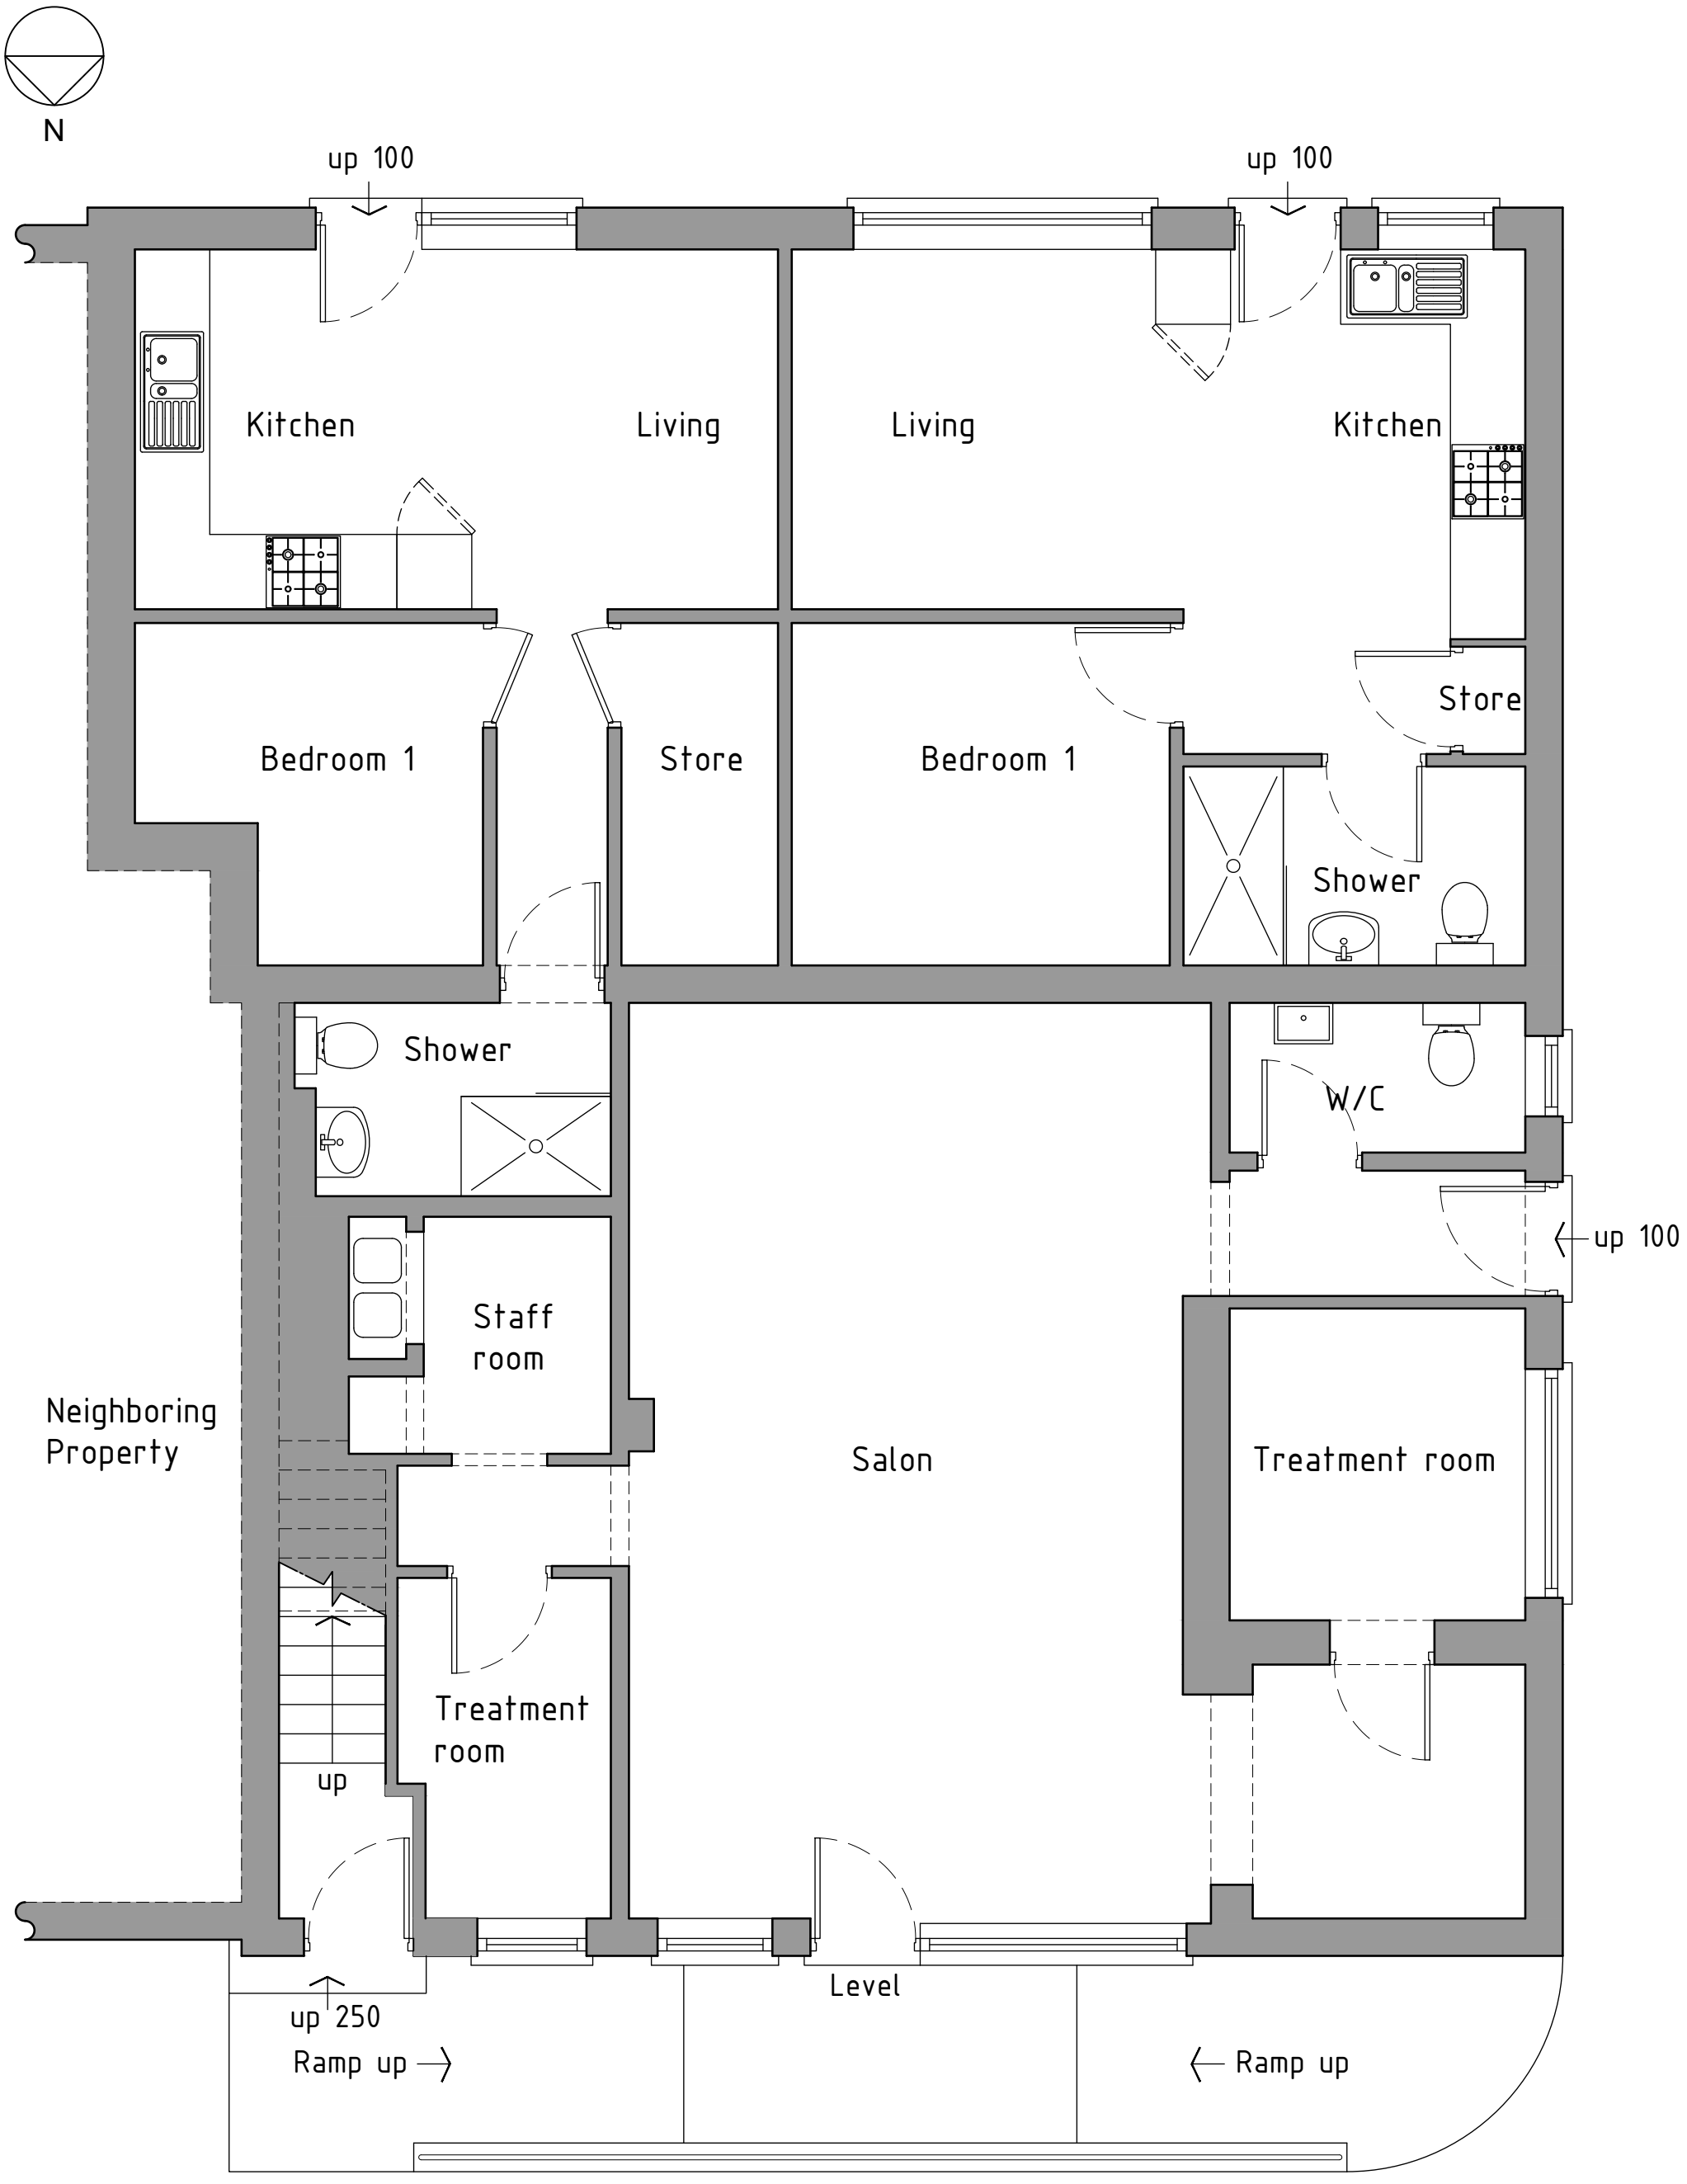


As Built

HDS ARCHITECTURAL SERVICES	**Project;** Parkside, Fifth Avenue, Llay, Wrexham, LL12 0SA		**Dwg No;** PA/PD/04 / **Date;** 06.06.24
HDS Architectural Services, The Foundry, 15 Yorke Street, Wrexham LL13 8LW Tel (01978) 345250 www.hdsarchitectural.co.uk	**Title;** 04-As Built Ground floor plan	**Scale (A3);** 1:50	**Revision;**

Ground floor plan 1:50