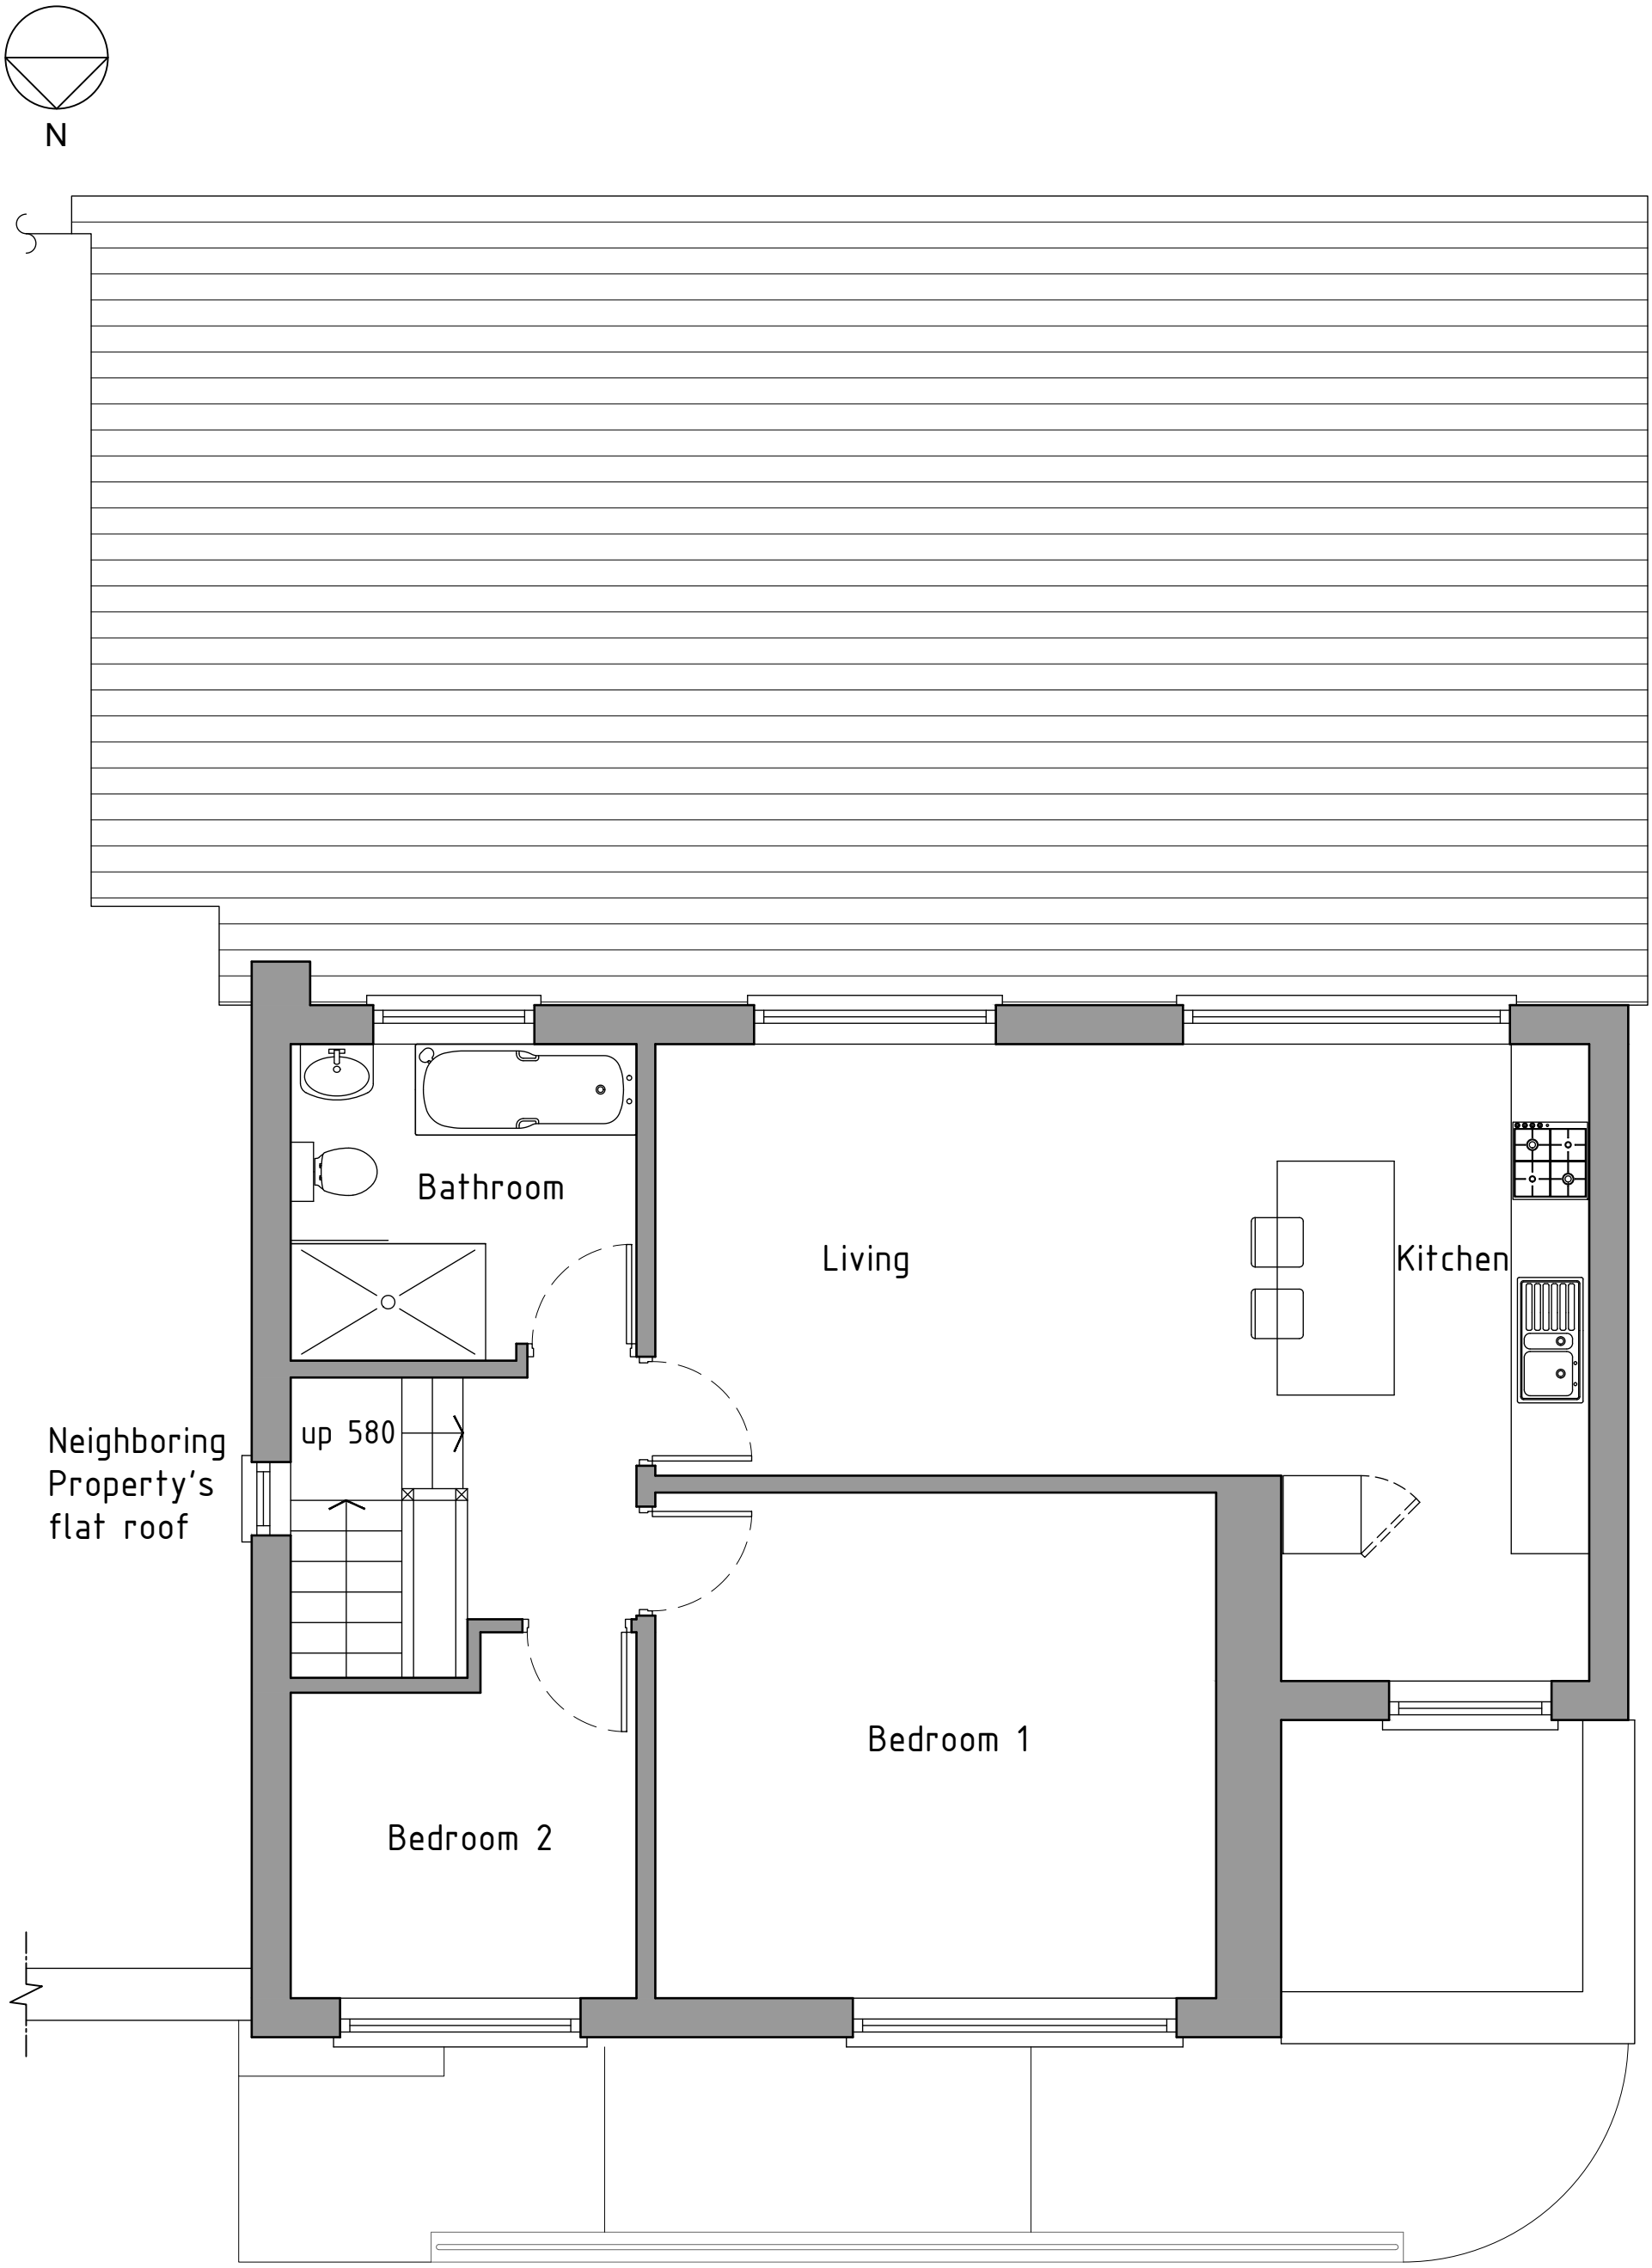


First floor plan 1:50

As Built

HDS ARCHITECTURAL SERVICES	**Project;** Parkside, Fifth Avenue, Llay, Wrexham, LL12 0SA		**Dwg No;** PA/PD/05	**Date;** 06.06.24
HDS Architectural Services, The Foundry, 15 Yorke Street, Wrexham LL13 8LW Tel (01978) 345250 www.hdsarchitectural.co.uk	**Title;** 05-As Built First floor plan	**Scale (A3);** 1:50	**Revision;**	