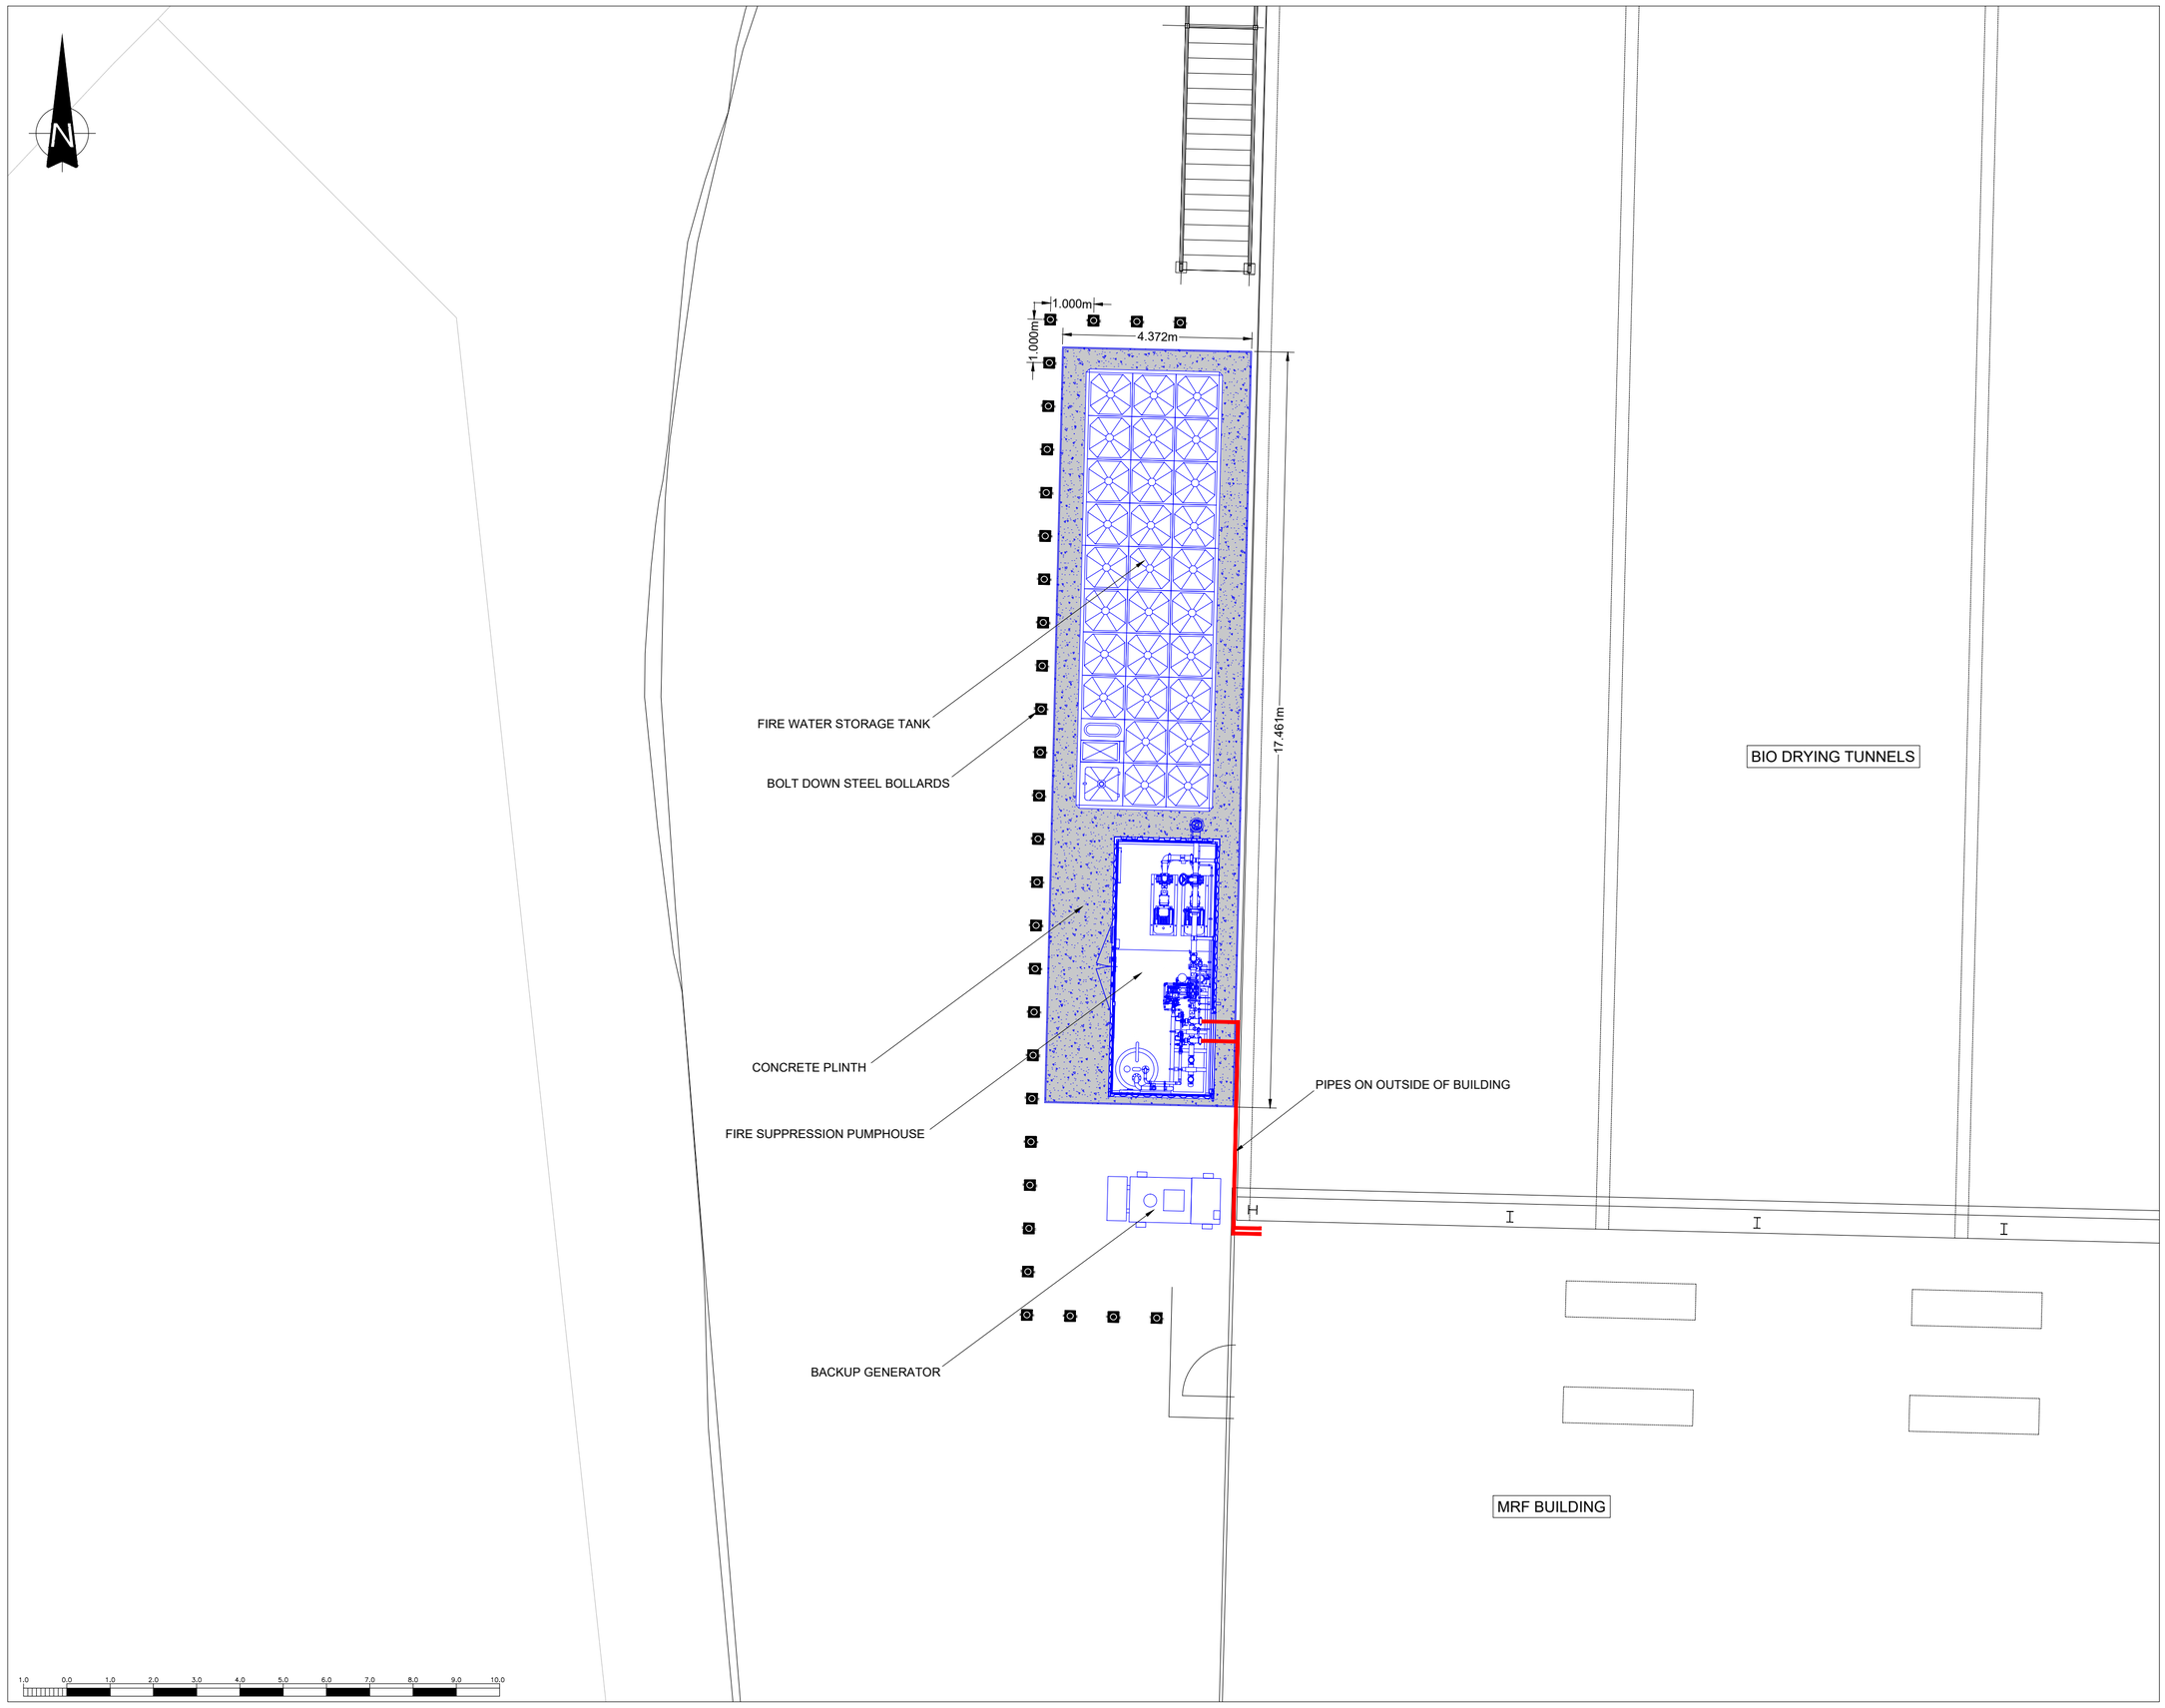


THIS INFORMATION IS CONFIDENTIAL AND THE PROPERTY OF SIRIUS. IT IS RELEASED ON CONDITION THAT NONE OF THE INFORMATION SHALL BE DISCLOSED TO ANY THIRD PARTY OR REPRODUCED IN WHOLE OR PART WITHOUT THE PRIOR CONSENT IN WRITING OF SIRIUS.

KEY

REV	DESCRIPTION	DATE	BY
2	TANK DETAILS UPDATED	15/7/24	S.T
1	AS-BUILT	21/9/23	S.T

CLIENT

FCC Environment

FCC Environment (UK) Limited
6 Sidings Court, White Rose Way, Doncaster, Yorkshire, DN4 5NU

siriUS Planning
4245 Park Approach, Thorpe Park, Leeds. LS15 8GB. 0113 264 9960

JOB TITLE

BRYN LANE AUTOMATIC FIRE SUPPRESSION SYSTEM

DRAWING TITLE

GENERAL ARRANGEMENT

DRAWN	DATE	APPROVED	DATE
S.T	15/7/2024	D.B	15/7/2024

SCALE	SHEET	DRAWING NUMBER	REVISION
1:100	A2L	WR7891/02/05	2