

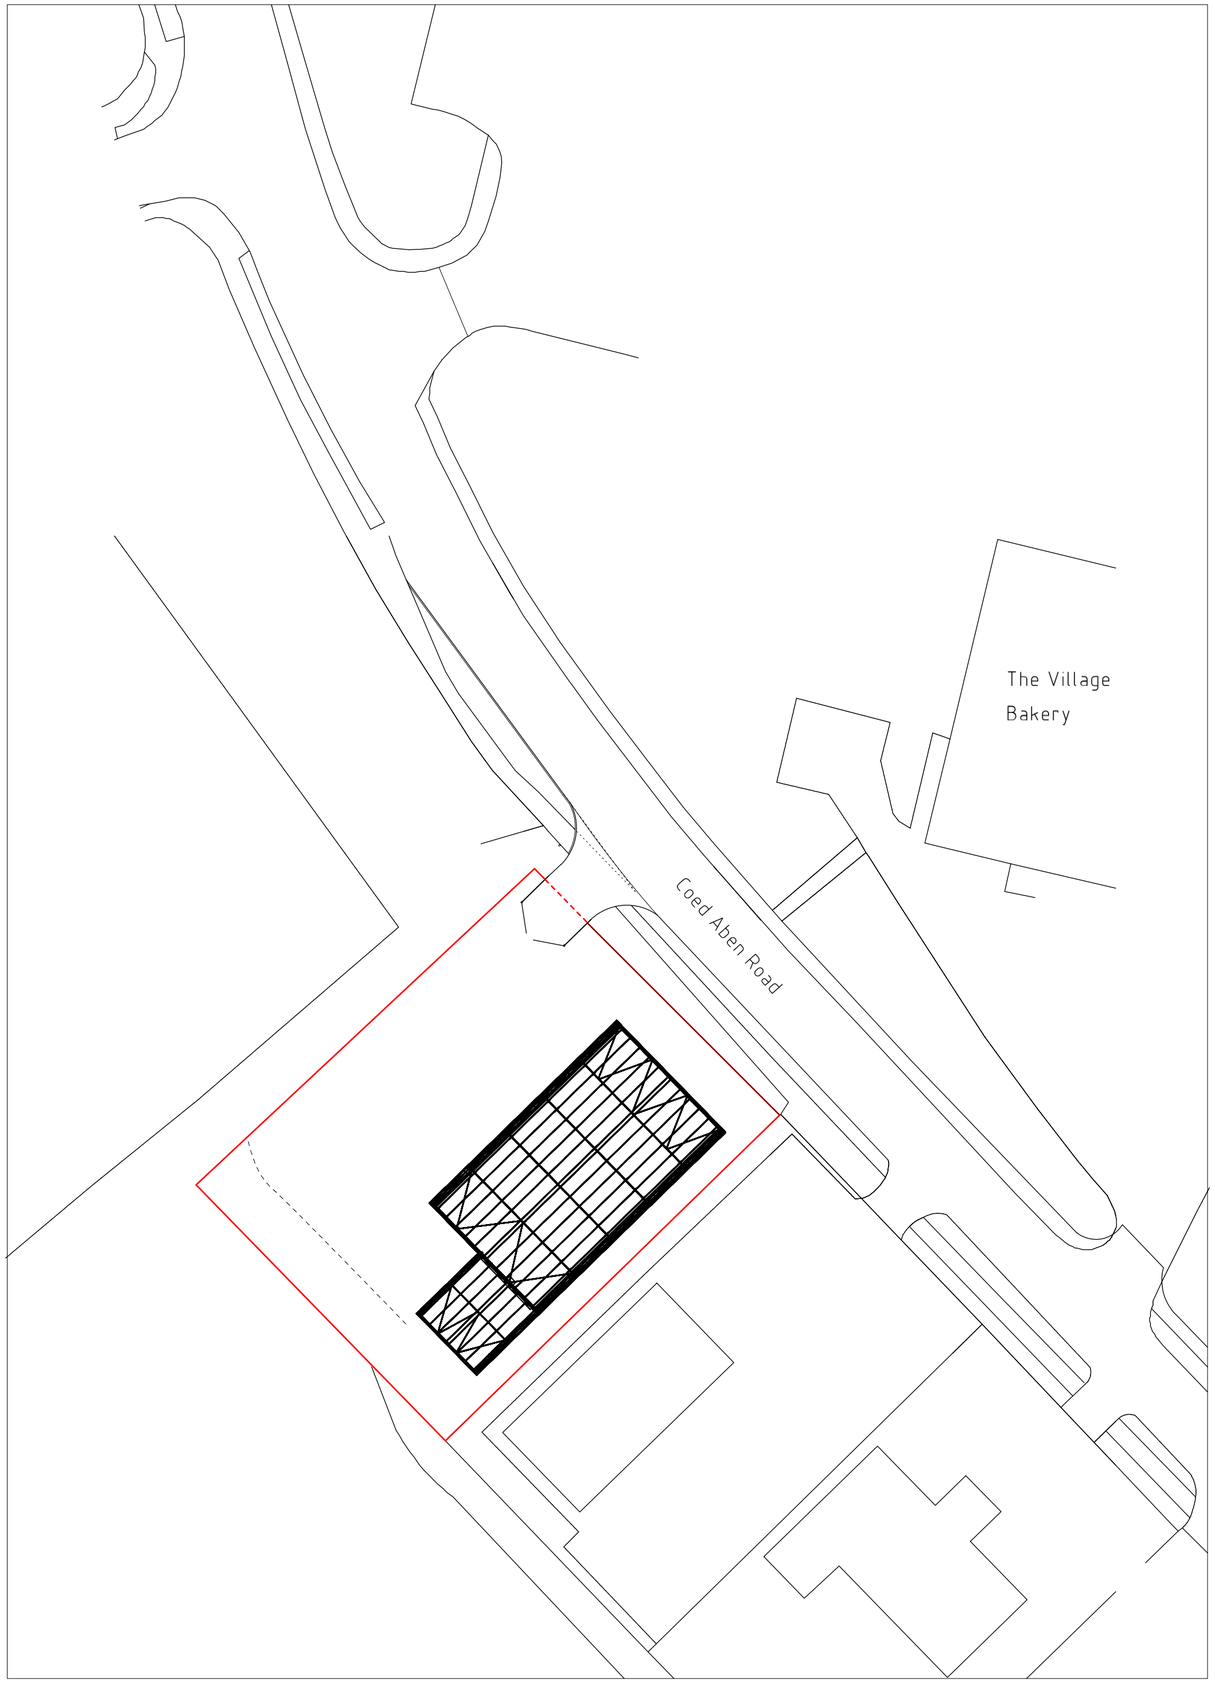


Site Plan 1:500

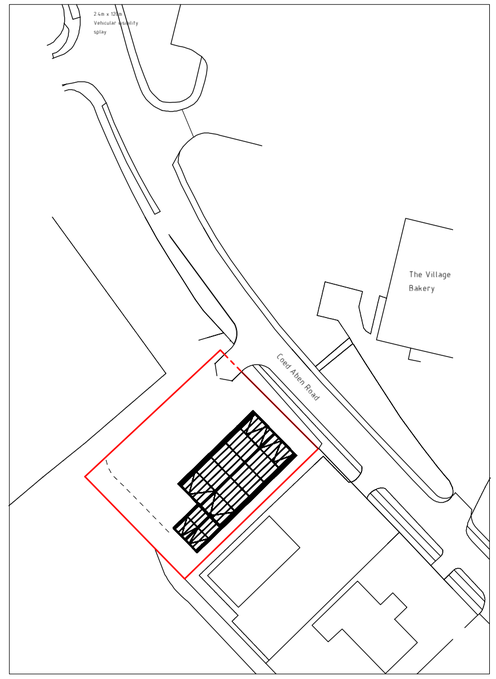

Location Plan 1:1250

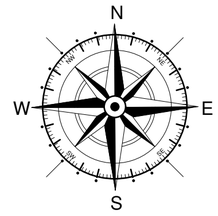

Key

Application Site

Rev	Date	Detail	Initial

Project:
Proposed Development at Land on Coed Aben Road, Wrexham Industrial Estate, Wrexham, LL13 9UH.

Title:	Scale: (A2)
As Built Site & Location Plan	1:500 & 1:1250

Drawn By:	Date:
D.J.Edwards	Feb 2024
Drawing No: P156/001	Sheet: 1 of 1

blueprint
architectural services

partner LABC

Redwither Business Centre,
Redwither Business Park,
Wrexham. LL13 9XR
Tel: 01978 356500
www.blueprintarchitectural.com