

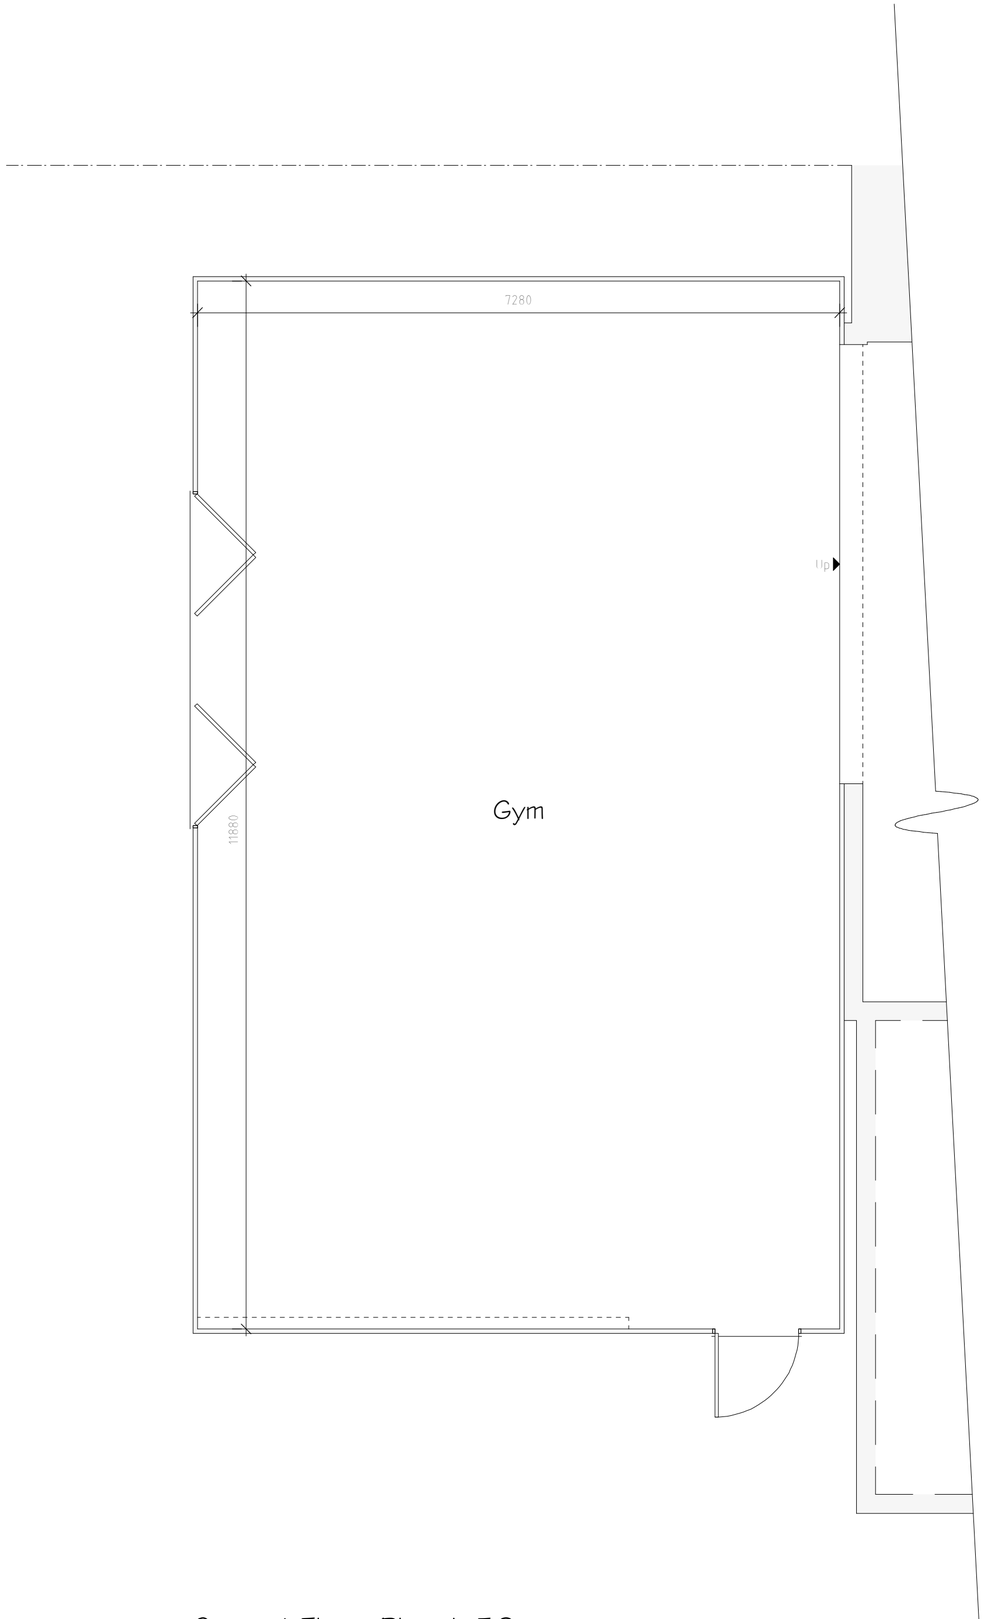



Ground Floor Plan 1:50

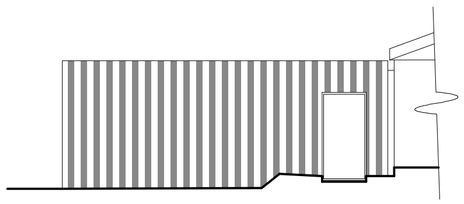

Front Elevation 1:100

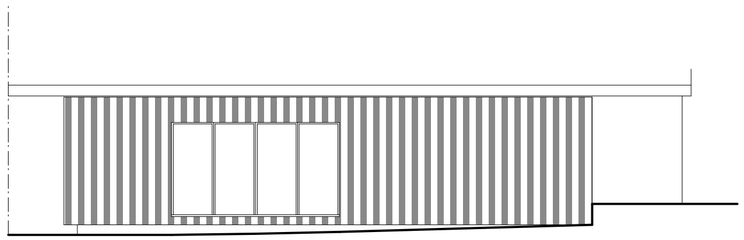

Side Elevation 1:100

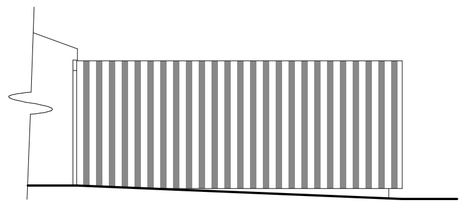

Rear Elevation 1:100

Rev	Date	Detail	Initial

Project: Proposed Alterations at Power Zone Gym, 5 Rivulet Road, Wrexham, LL13 8DT

Title:	Scale: (A2)
As Built	1:50 & 1:100
Drawn By: L. Fowles	Date: July 2024
Drawing No: W218/001	Sheet: 1 of 1

blueprint architectural services

partner LABC

Office 3K4,
Redwither Business Tower,
Wrexham. LL13 9XT
Tel: 01978 356500
www.blueprintarchitectural.com

© copyright all rights reserved