
	Description	By	Date
P1	Initial Issue	LM	06.08.24



1 As-Built Fence Line Site Plan
Scale 1 : 500

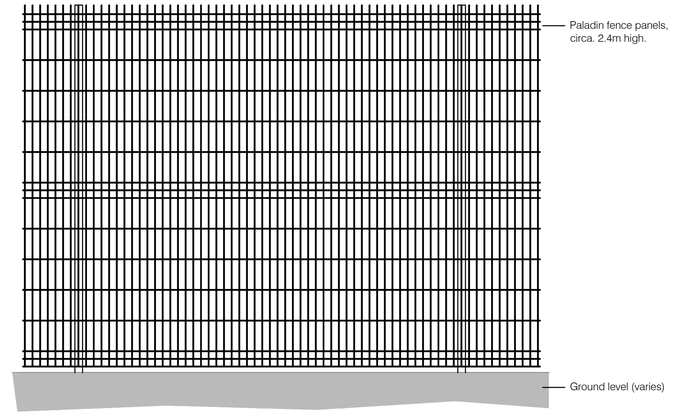

2 Typical Paladin Fence Elevation
Scale 1 : 20

0 2m 10 m 20 m
Scale 1:500

N

Unchanged Fence Line

As-Built Fence Line

Previous Fence Line

Modern City Architecture & Urbanism

Avenue HQ
17 Mann Island
Liverpool
L3 1BP

t: 0161 974 7203
e: info@mcau.co.uk
www.mcau.co.uk

Client
F.I Real Estate Management

Project
Ridley Wood, Bryn Lane
Wrexham

Description
As-Built Fence Line Site Plan

Status
Planning

Drawn By
LM

Job Number
SP133-MCAU

Scale
AS@A1

Date
Aug 24

Drawing Number
P.02-002

Revision
P1

Copyright Modern City Architecture & Urbanism Ltd