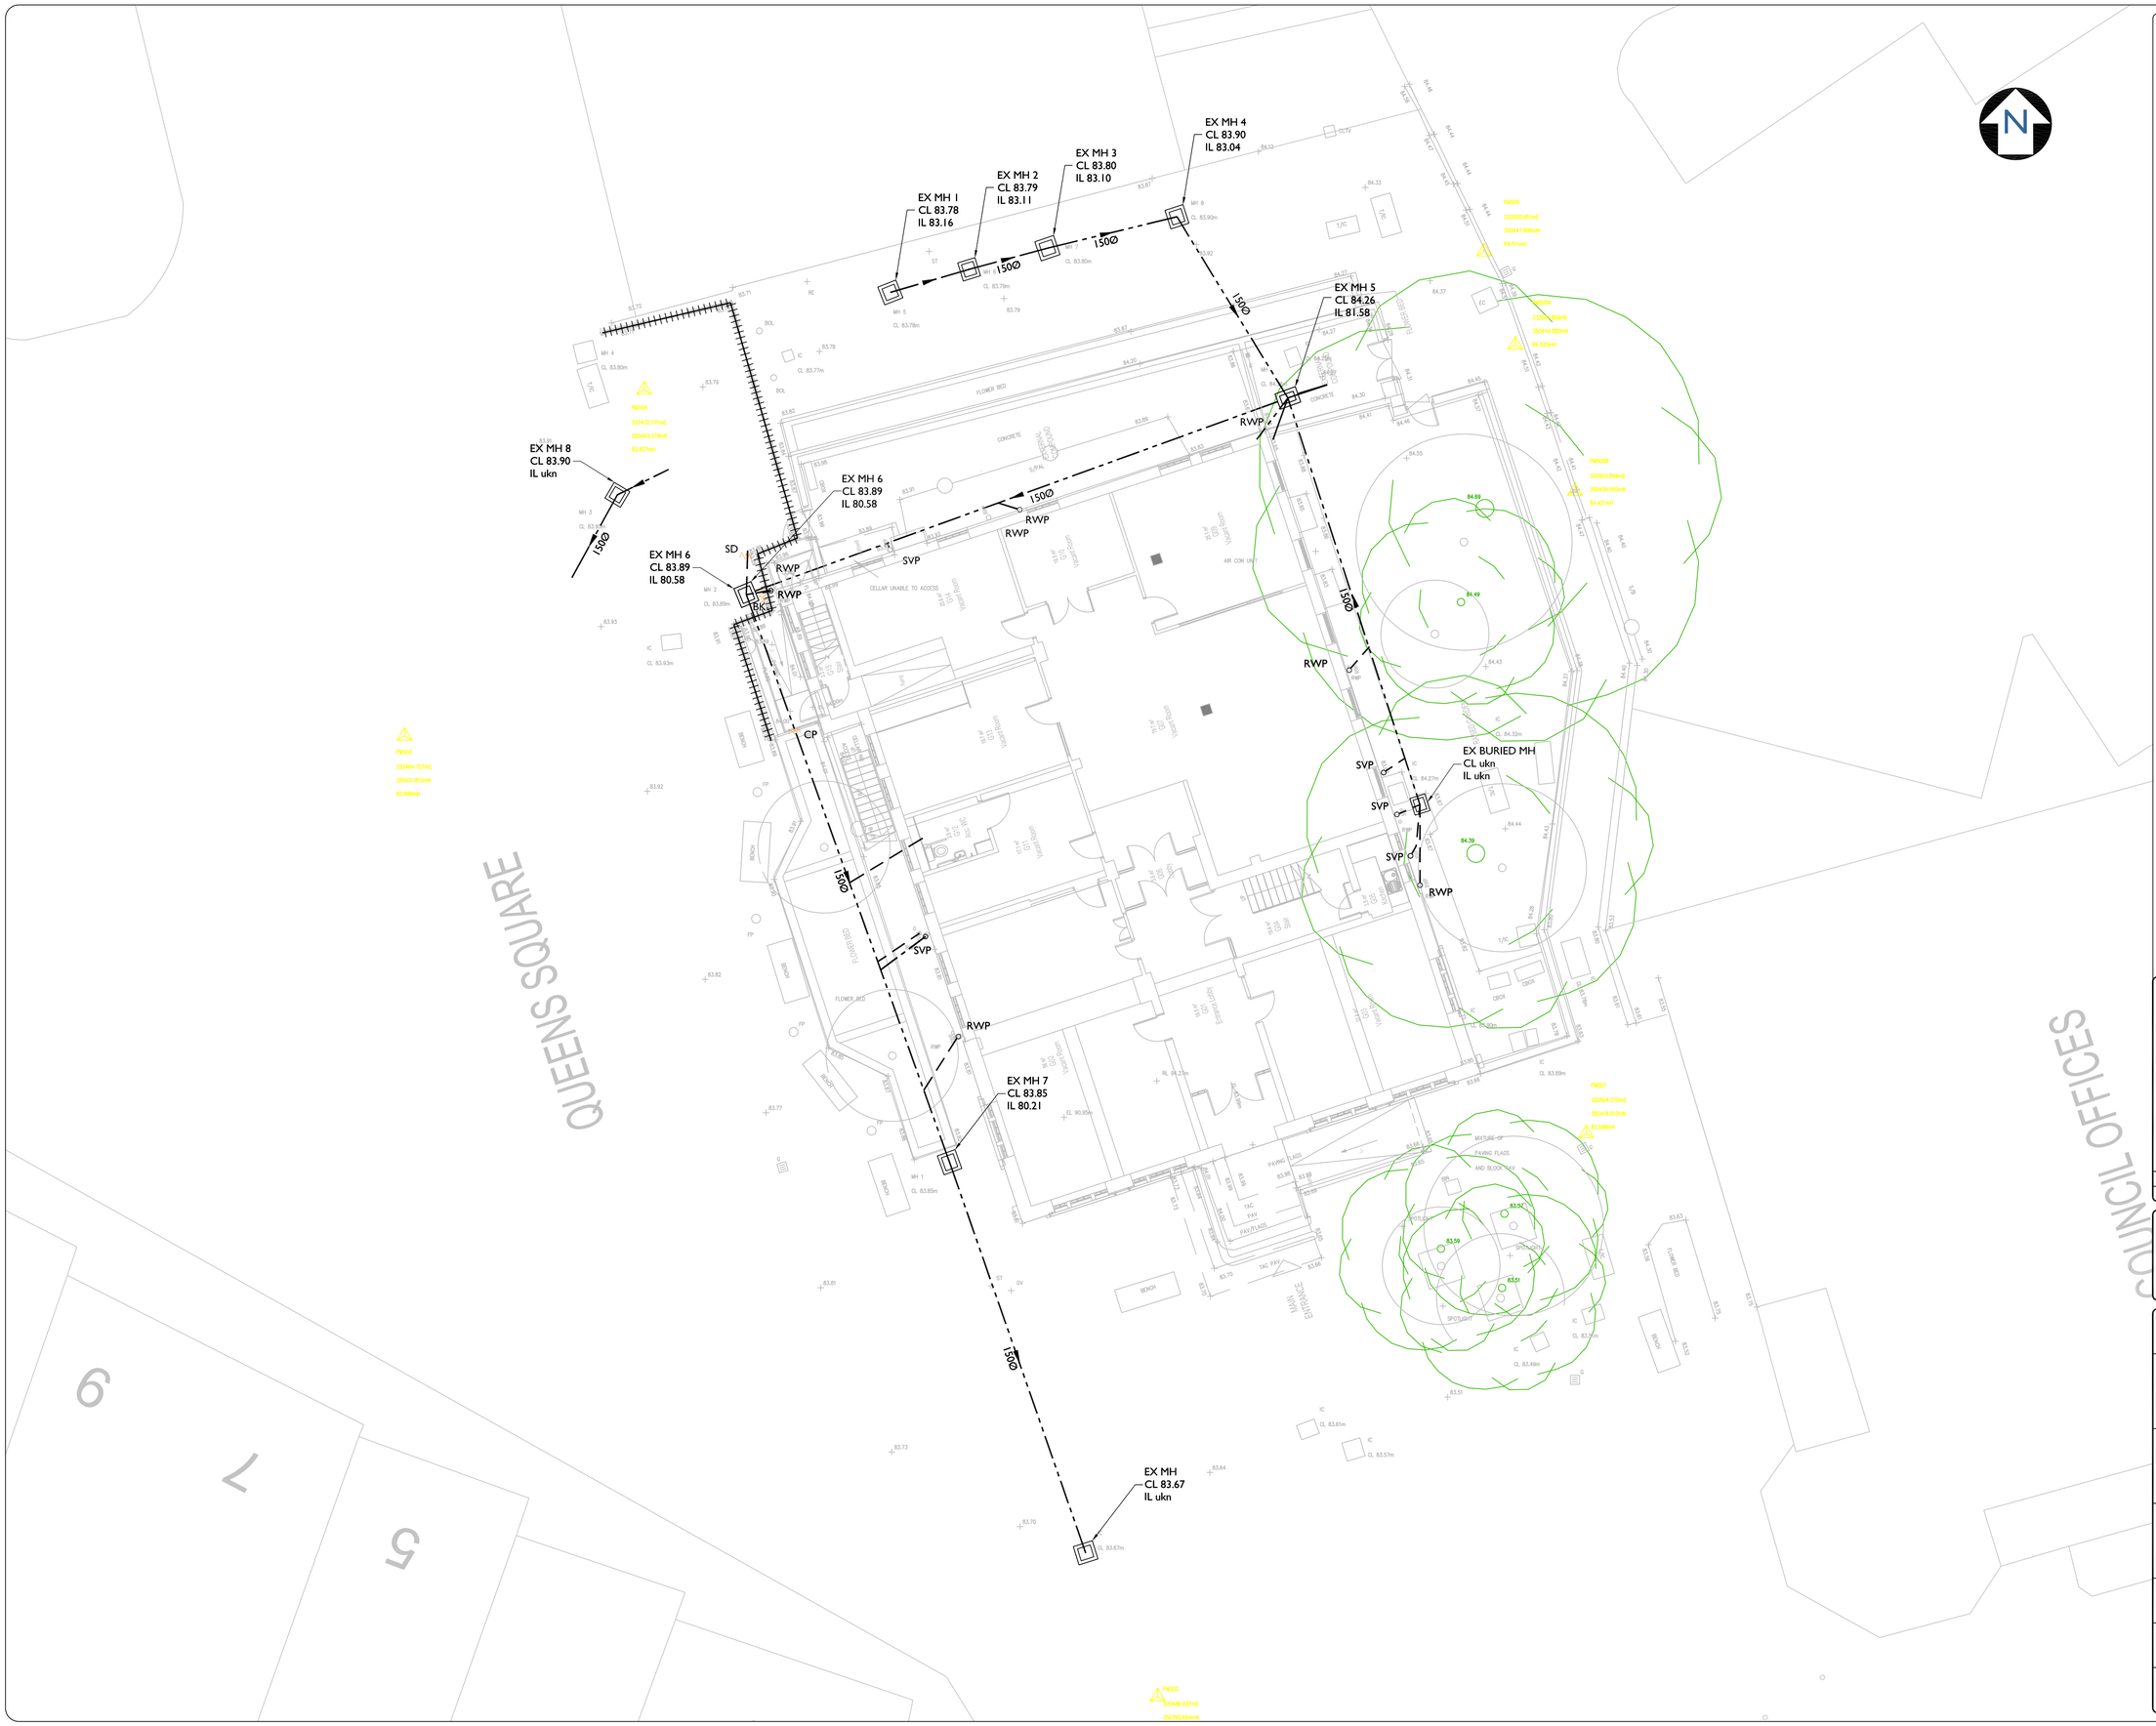


EXISTING DRAINAGE NOTES

THE LOCATION LINE & LEVEL OF ALL KNOWN EXISTING DRAINAGE PIPEWORK INDICATED ON THIS DRAWING IS APPROXIMATE AND FOR GUIDANCE PURPOSES ONLY.

KEY

- FWS — EXISTING FOUL WATER SEWER
- SWS — EXISTING SW SEWER
- CFS — EXISTING COMBINED SEWER
- HD — EXISTING HIGHWAY DRAIN
- EXISTING FOUL DRAIN
- EXISTING SW DRAIN
- EXISTING COMBINED FLOW DRAIN
- sfr — SHOWN FROM RECORD INFORMATION

THE CONTRACTOR SHALL MAKE ALLOWANCE FOR RAISING / LOWERING ALL EXISTING ACCESS COVERS & FRAMES TO SUIT NEW FINISHED LEVELS.

CCTV DEFECT KEY

THE PLAN HAS BEEN UPDATED TO DISPLAY DEFECTS AS IDENTIFIED WITHIN THE CCTV SURVEY / REPORT - LOCATIONS ARE APPROXIMATE BASED ON THE CHAINAGES AS PROVIDED

KEY

- CCTV DEFECT
- BK — BLOCKAGE
- RI — ROOT INGRESS
- CP — CRACKED PIPE
- BP — BROKEN PIPE
- DJ — DISPLACED JOINT
- SD — SETTLED DEPOSITS

THIS DRAWING HAS BEEN PRODUCED BY COMPARING INFORMATION FROM VARIOUS RECORD PLANS AGAINST THE TOPOGRAPHICAL SURVEY DATA OBTAINED. AS SUCH THE ACCURACY CANNOT BE GUARANTEED AND THE CONTRACTOR IS TO VERIFY THE EXISTING LAYOUT & LEVELS PRIOR TO COMMENCEMENT OF ANY DRAINAGE WORKS.

REV	DESCRIPTION	BY	CHK	APR	DATE
-	-	-	-	-	-

JPS CIVIL + STRUCTURAL ENGINEERS
+44 (0)1244 956000 | www.jpstructural.co.uk | info@jpstructural.co.uk

PURPOSE OF ISSUE: PRELIMINARY	STATUS: P
PROJECT: WREXHAM OLD LIBRARY	
TITLE: DRAINAGE SCHEME EXISTING DRAINAGE & CCTV DEFECTS	
CLIENT: LAWRAY ARCHITECTS	
DRAWN BY: SB	CHECKED BY: RH
APPROVED BY: JP	
DATE: 20.08.2024	SCALE (@ A1): 1:100
PROJECT NUMBER: 49011	
DRAWING NUMBER: 0601	REV: P01