
N

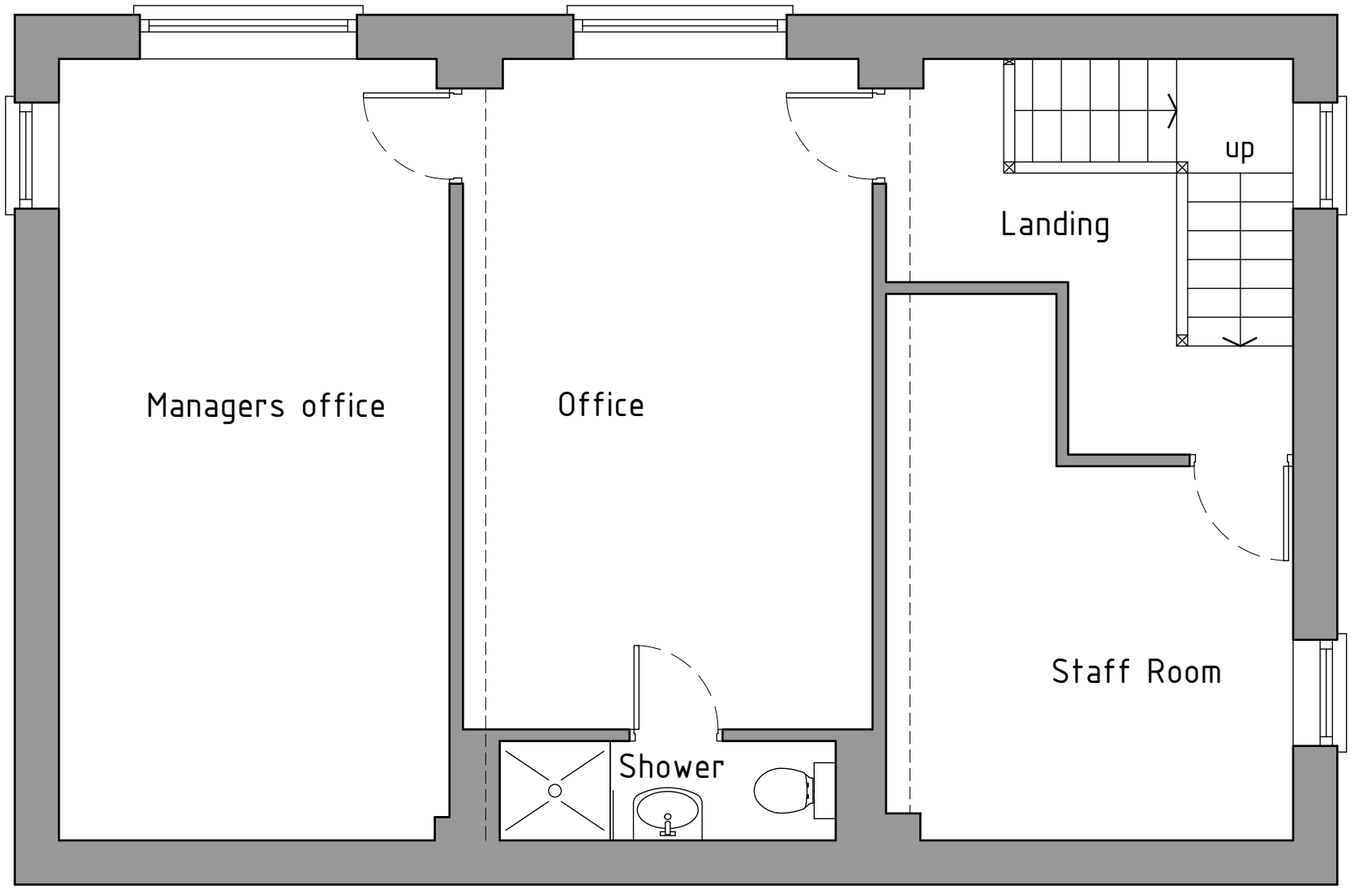

First floor plan 1:50

As Built

HDS ARCHITECTURAL SERVICES
HDS Architectural Services, The Foundry,
15 Yorke Street, Wrexham
LL13 8LW
Tel (01978) 345250
www.hdsarchitectural.co.uk

Project;
Office unit, S&L Aerospace Engineering LTD, The Old Coal Yard, Park Road, Wrexham, LL143YP

Title;	**Scale (A3);**
02-As Built First Floor Plan	1:50
Dwg No;	**Date;**
SOS/PD/02	13.01.25

Revision;