

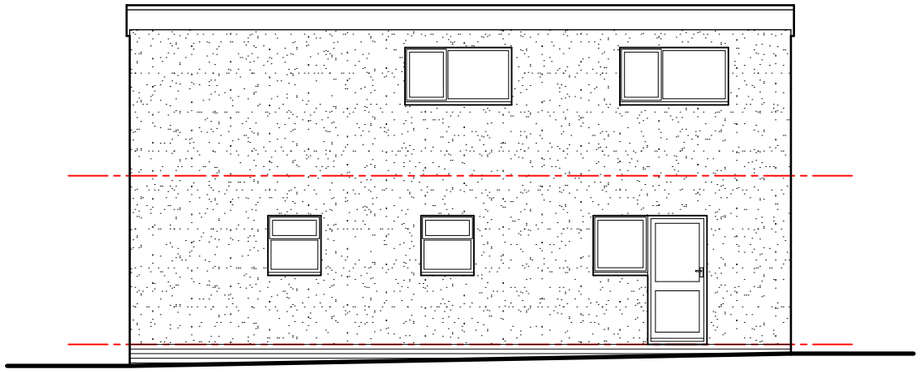



Front elevation 1:100

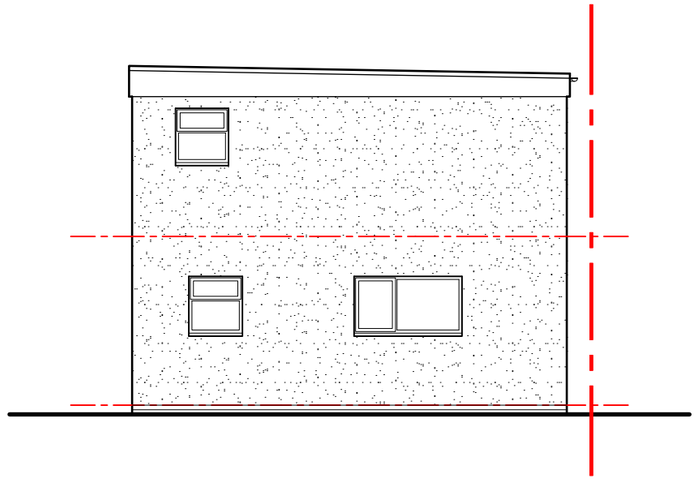

Side-01 elevation 1:100

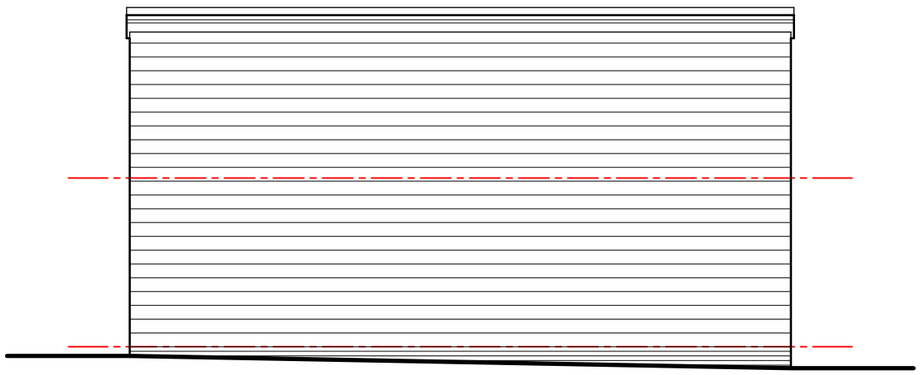

Rear elevation 1:100

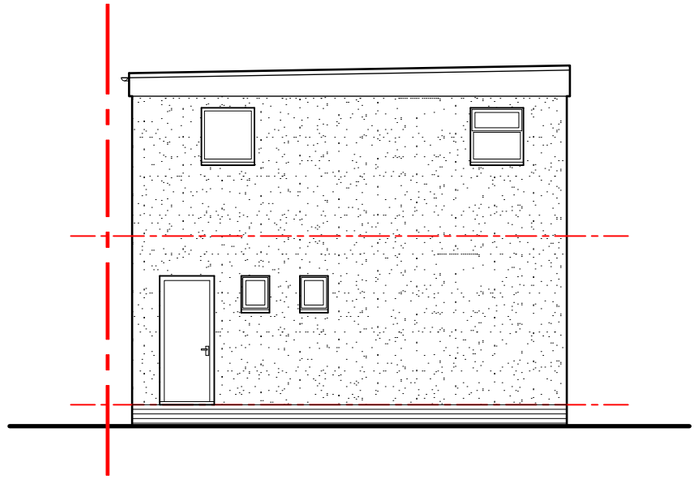

Side-02 elevation 1:100

As Built

HDS ARCHITECTURAL SERVICES

HDS Architectural Services, The Foundry,
15 Yorke Street, Wrexham
LL13 8LW
Tel (01978) 345250
www.hdsarchitectural.co.uk

Project;	Dwg No;	Date;
Office unit, S&L Aerospace Engineering LTD, The Old Coal Yard, Park Road, Wrexham, LL143YP	SOS/PD/03	13.01.25

Title;	Scale (A3);	Revision;
03-As Built Elevations	1:100	